


PARENT PARCEL: 05-00-042-105-015, 05-00-059-101-001, -015, 05-00-060-101-020

CHILD PARCEL: 05-00-042-105-015, 05-00-059-101-022, 05-00-060-101-020

STARTING POINT: SOUTHWEST CORNER OF O.L.60

19-03971

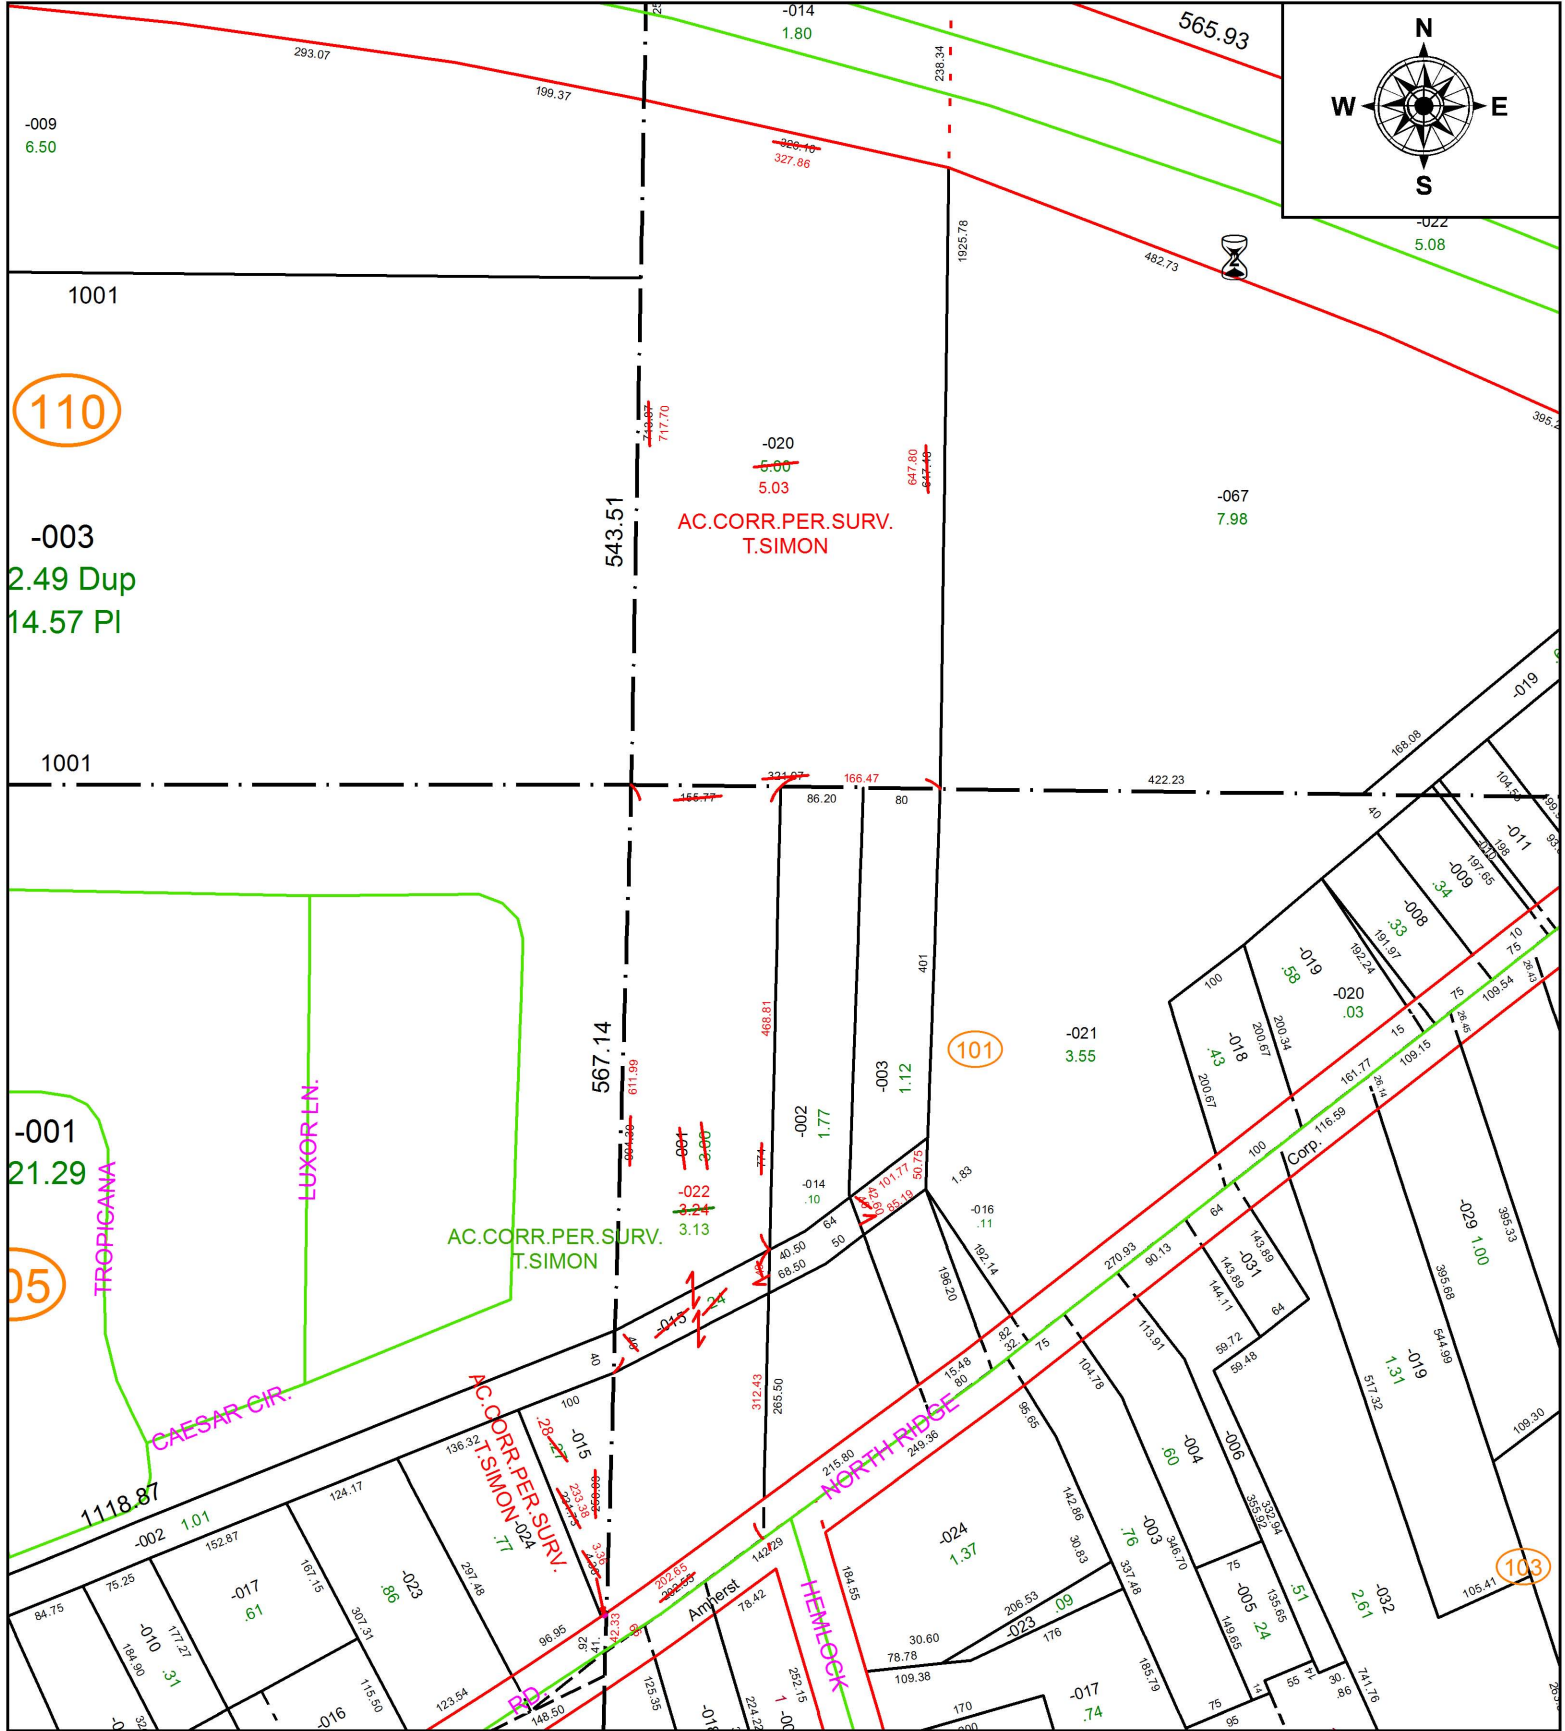

SPLITS/DEEDS PROCESSED
 LORAIN COUNTY TAX MAP DEPARTMENT
 226 MIDDLE AVE. ELYRIA, OH

SURVEYED BY: THOMAS A. SIMON
CLOSURE: 1:364,143
MAP PAGE(S): 5-00-059
APPROVED BY: RRM **DATE:** 5-13-19
SCALE: 1" = 200 **PRIOR INSTRUMENT:** 20190713785