


PARENT PARCEL: 02-02-001-104-028


CHILD PARCEL:

STARTING POINT: INTERSECTION OF C/L OF COOPER FOSTER PARK RD. AND C/L OF N. MAIN ST.

18-03975-C

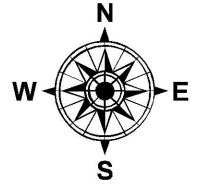

**MAP CORRECTION ONLY**  
CORR. PER SURVEY W.WALLACE

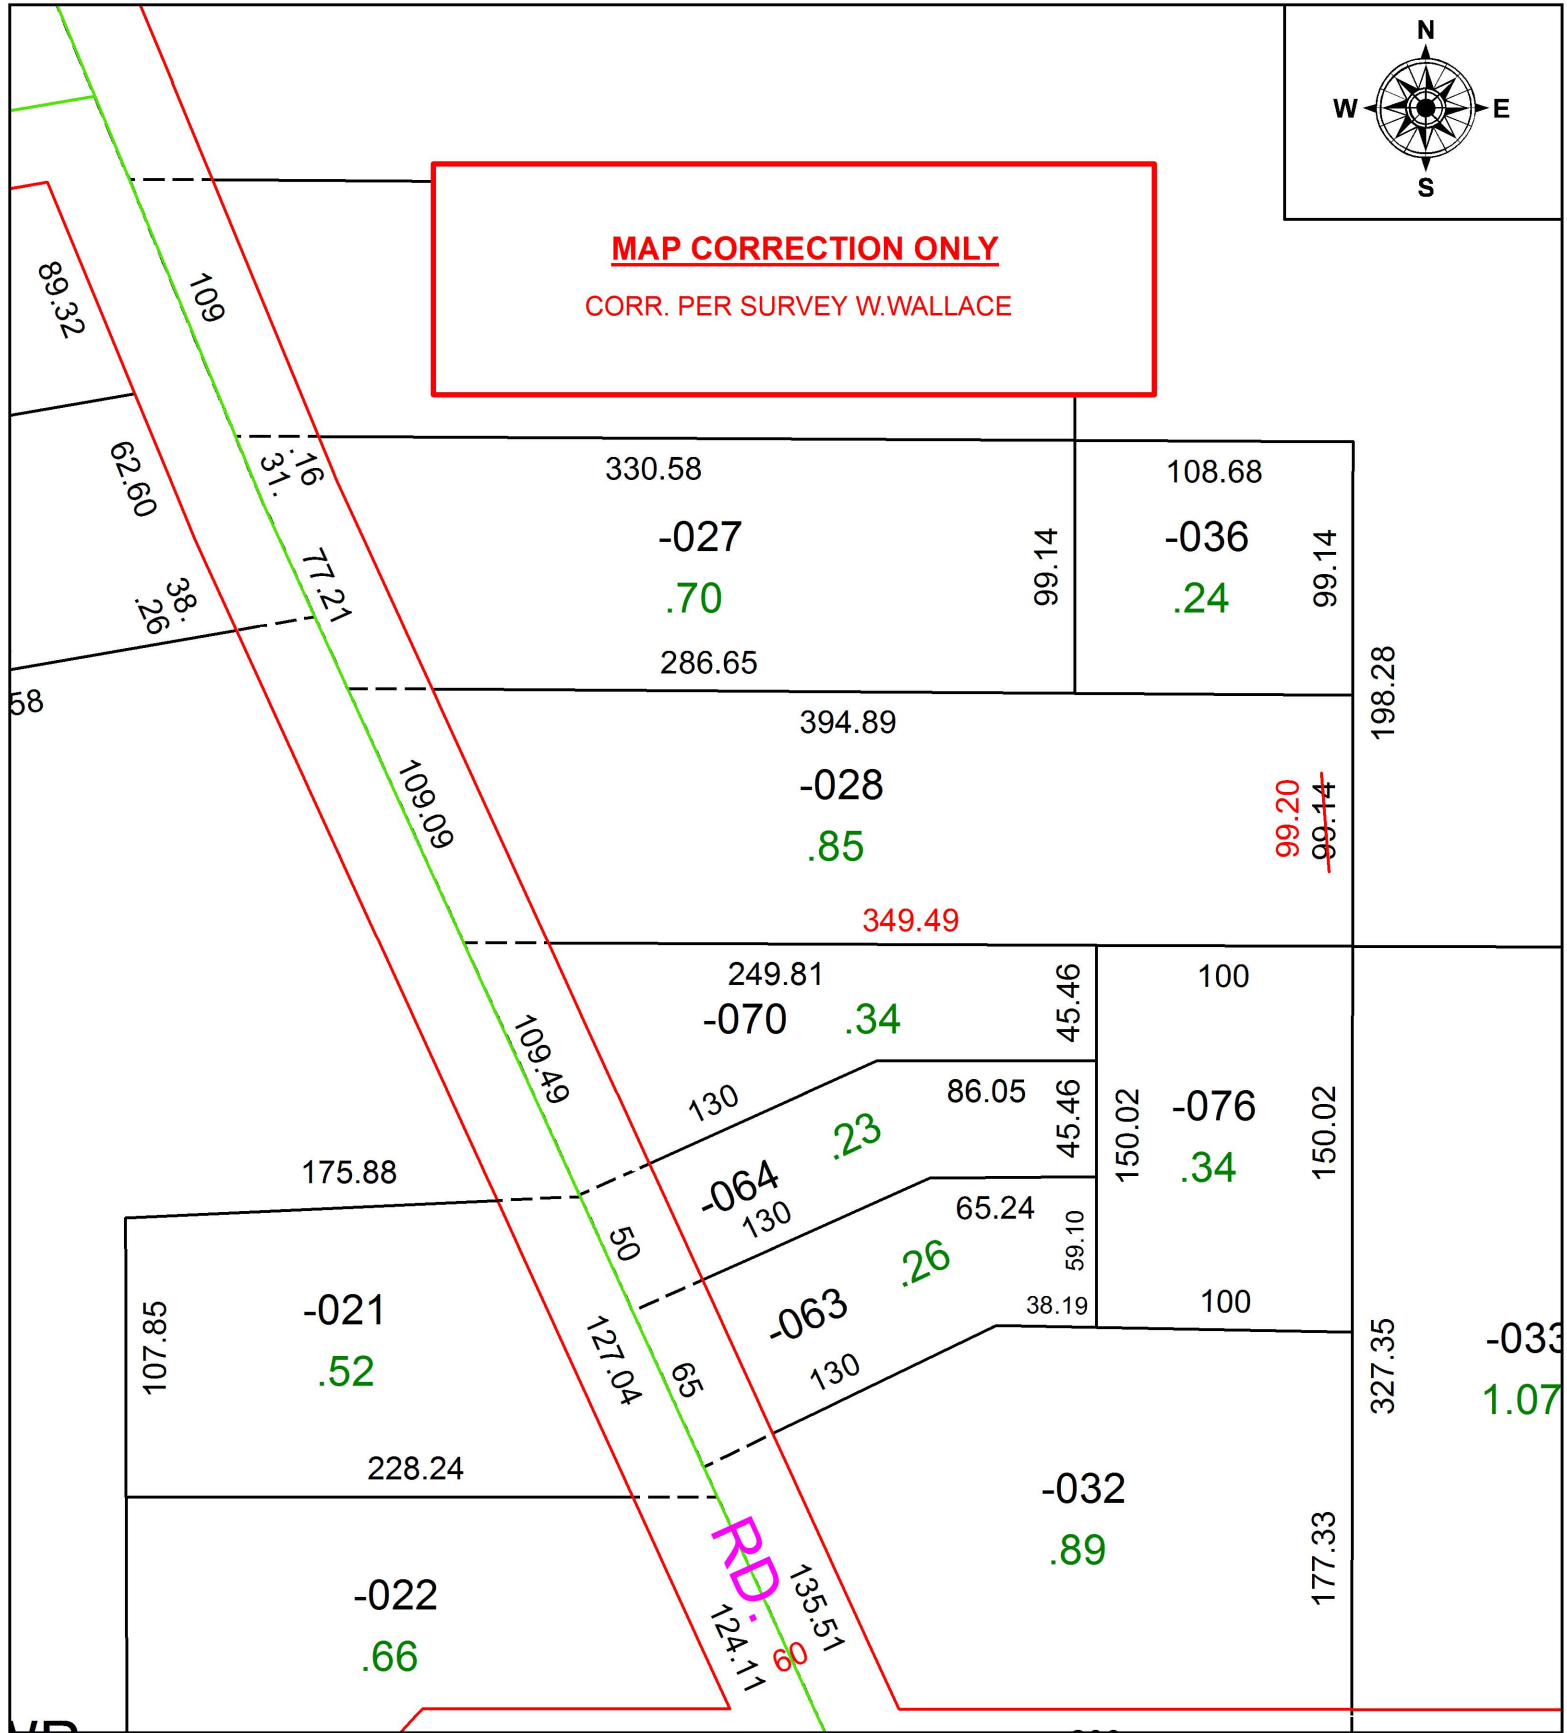

**SPLITS/DEEDS PROCESSED**  
LORAIN COUNTY TAX MAP DEPARTMENT  
226 MIDDLE AVE. ELYRIA, OH

SURVEYED BY: WILLIAM R. WALLACE  
CLOSURE: 1: 177,315  
MAP PAGE(S): 2-02-001  
APPROVED BY: RRM DATE: 11-2-18  
SCALE: 1" = 75' PRIOR INSTRUMENT: 20180683778