


PARENT PARCEL: 06-25-007-000-095, -181, -182

CHILD PARCEL: 06-25-007-000-270

STARTING POINT: INTERSECTION OF C/L OF TAYLOR ST. AND C/L OF TERNES AVE.

18-03978-A

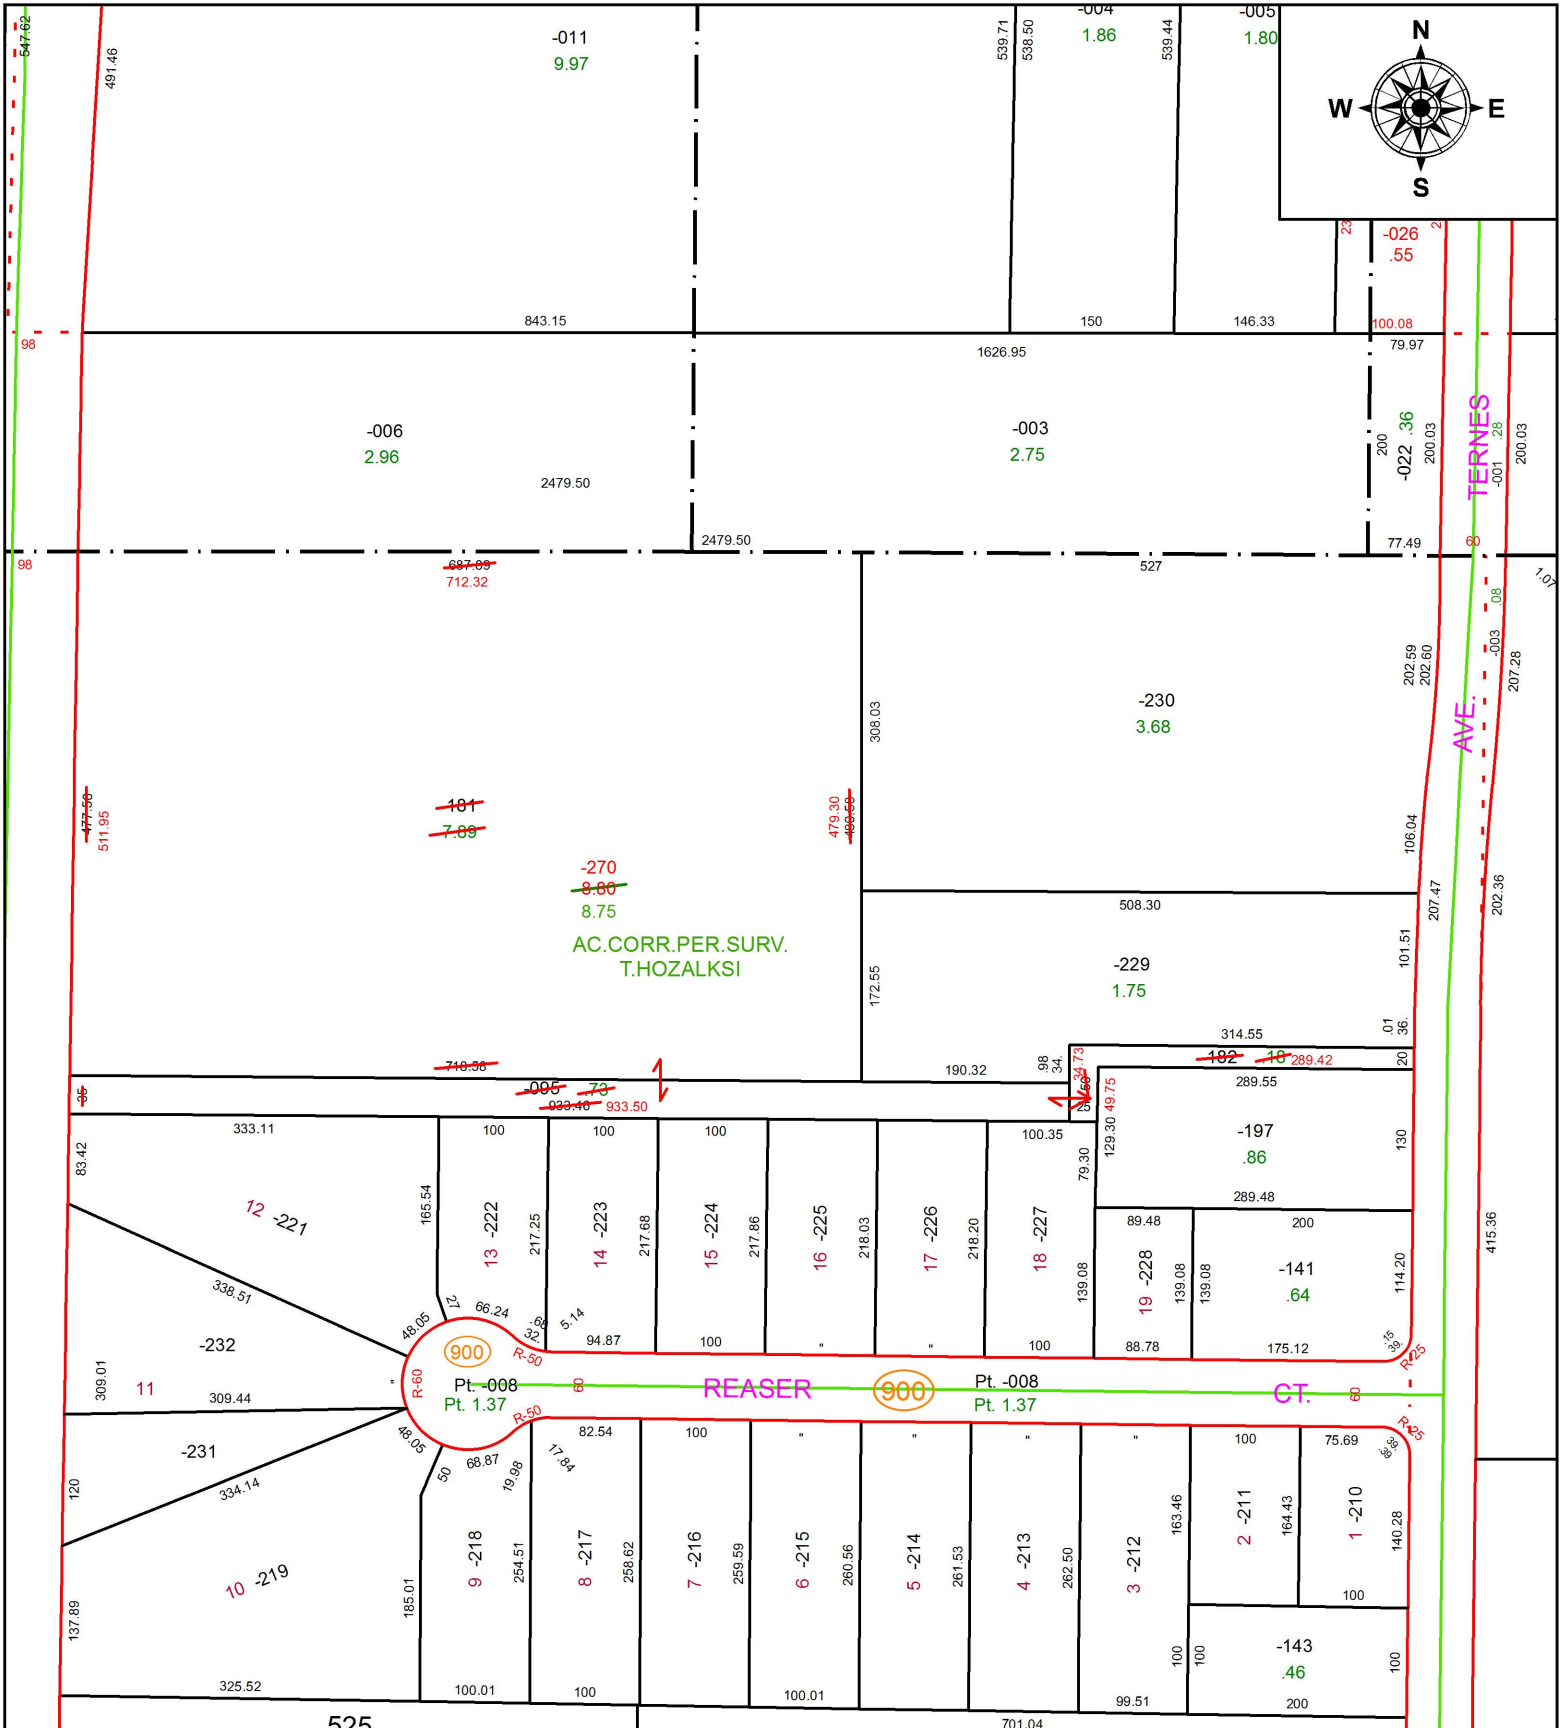

SPLITS/DEEDS PROCESSED
 LORAIN COUNTY TAX MAP DEPARTMENT
 226 MIDDLE AVE. ELYRIA, OH

SURVEYED BY: TIMOTHY D. HOZALSKI

CLOSURE: 1: 225,748

MAP PAGE(S): 6-25-007

APPROVED BY: RRM **DATE:** 11-9-18

SCALE: 1" = 175 **PRIOR INSTRUMENT:** VOL.270/153