
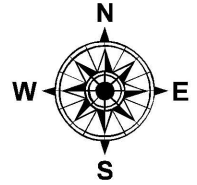


PARENT PARCEL: 15-00-039-000-007

CHILD PARCEL: 15-00-039-000-016, -017

STARTING POINT: INTERSECTION OF C/L OF DIAGONAL RD. AND C/L OF BIGGS RD.

19-03978

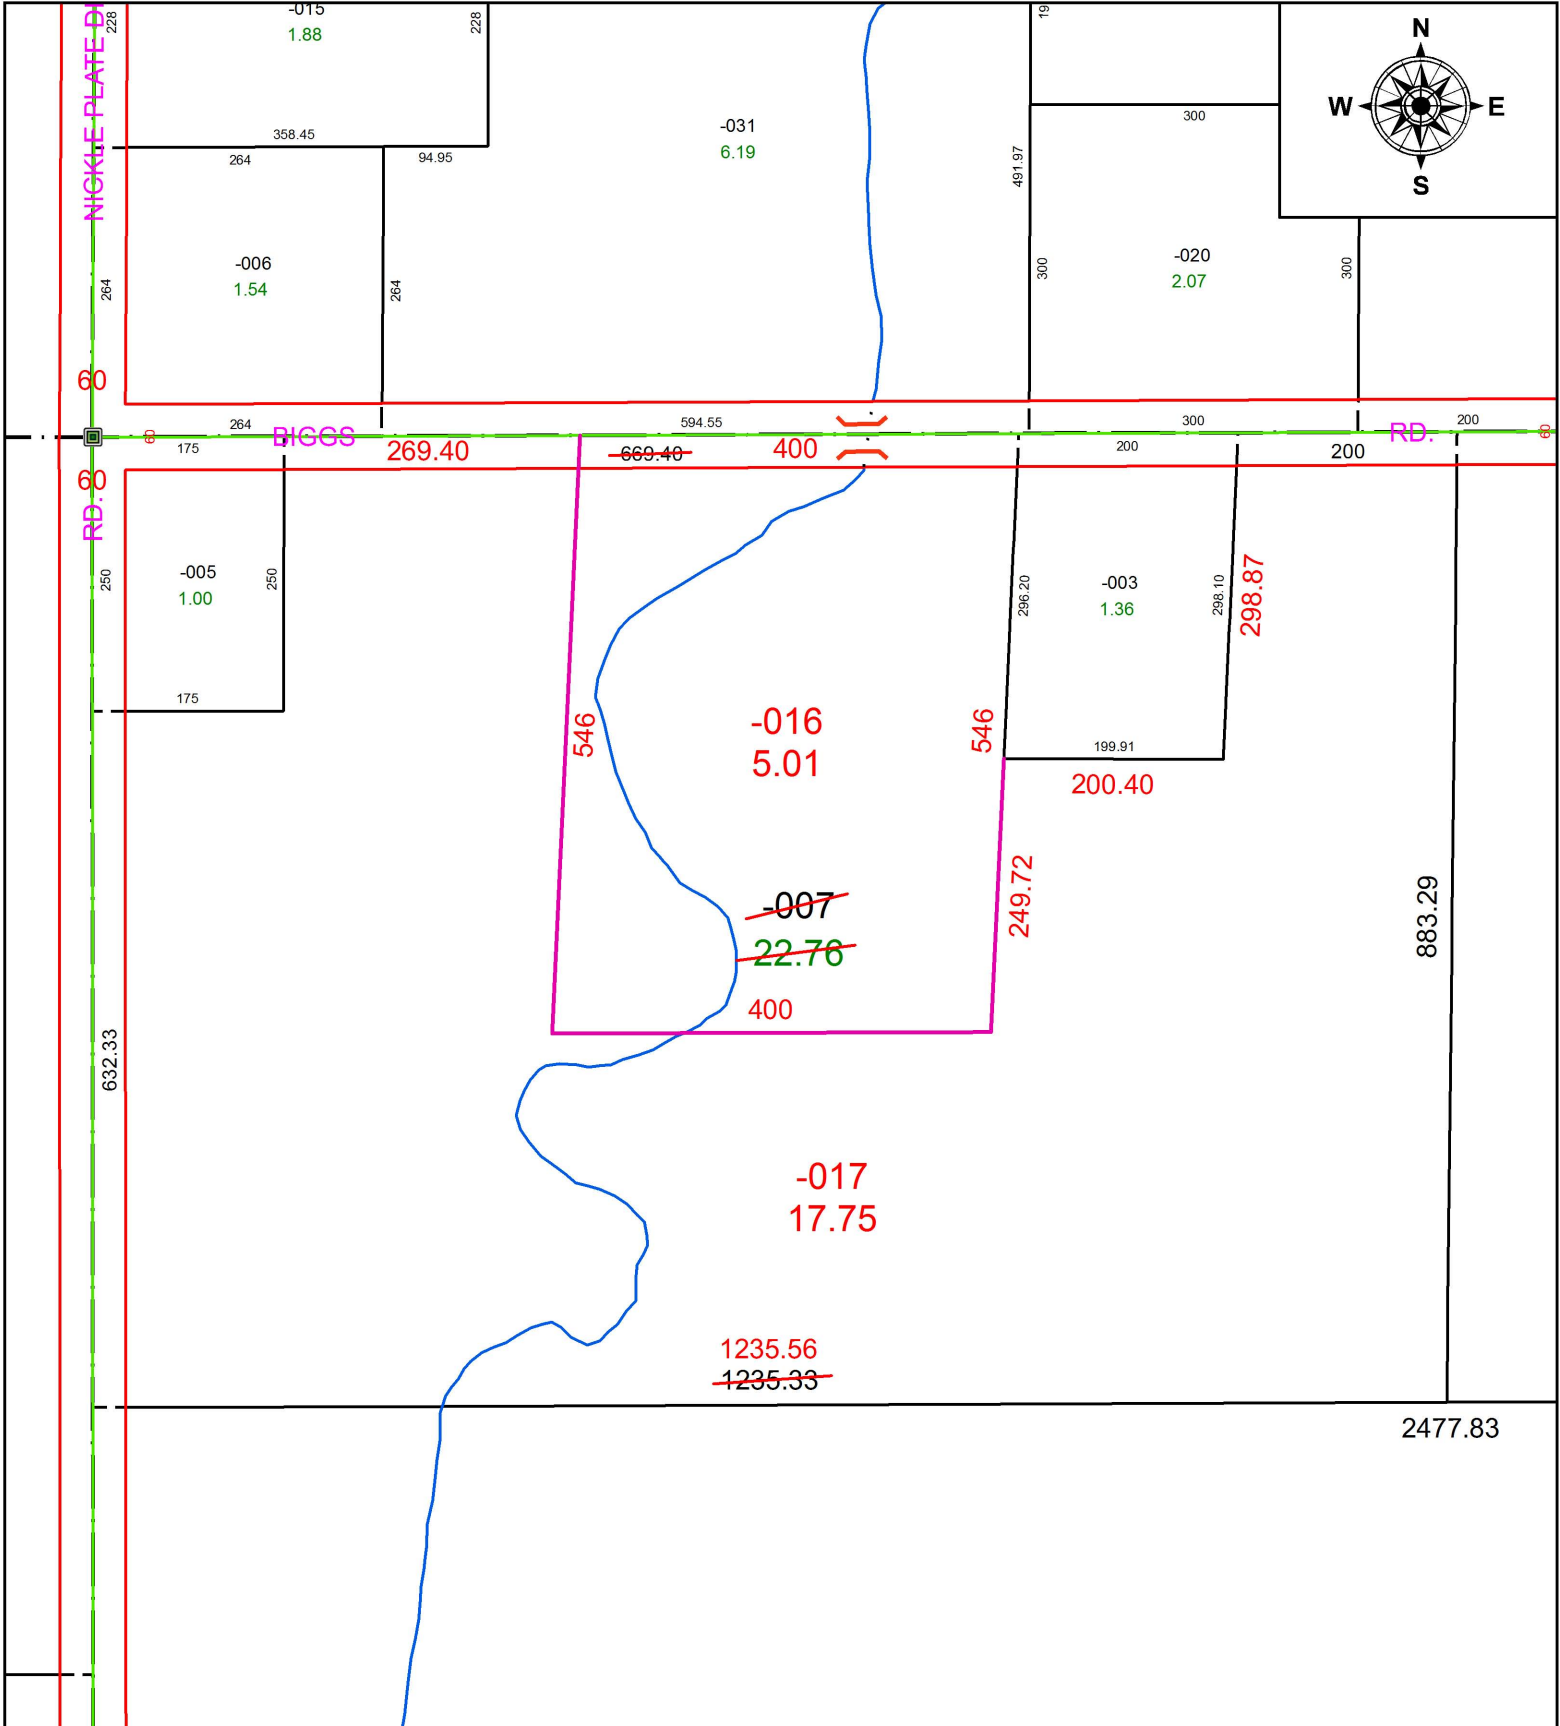

**SPLITS/DEEDS PROCESSED**  
 LORAIN COUNTY TAX MAP DEPARTMENT  
 226 MIDDLE AVE. ELYRIA, OH

SURVEYED BY: THOMAS A. SIMON  
 CLOSURE: 1:548,330  
 MAP PAGE(S): 15-00-039  
 APPROVED BY: RRM DATE: 6-4-19  
 SCALE: 1" = 175 PRIOR INSTRUMENT: 20150549742