


PARENT PARCEL: 05-00-015-000-078, 05-00-016-102-027

CHILD PARCEL: 05-00-015-000-139, -140, 05-00-016-102-037, -038

STARTING POINT: INTERSECTION OF NORTH LINE OF COPPER CREEK SUB. AND C/L OF PYLE SOUTH AMHERST RD.

19-03981

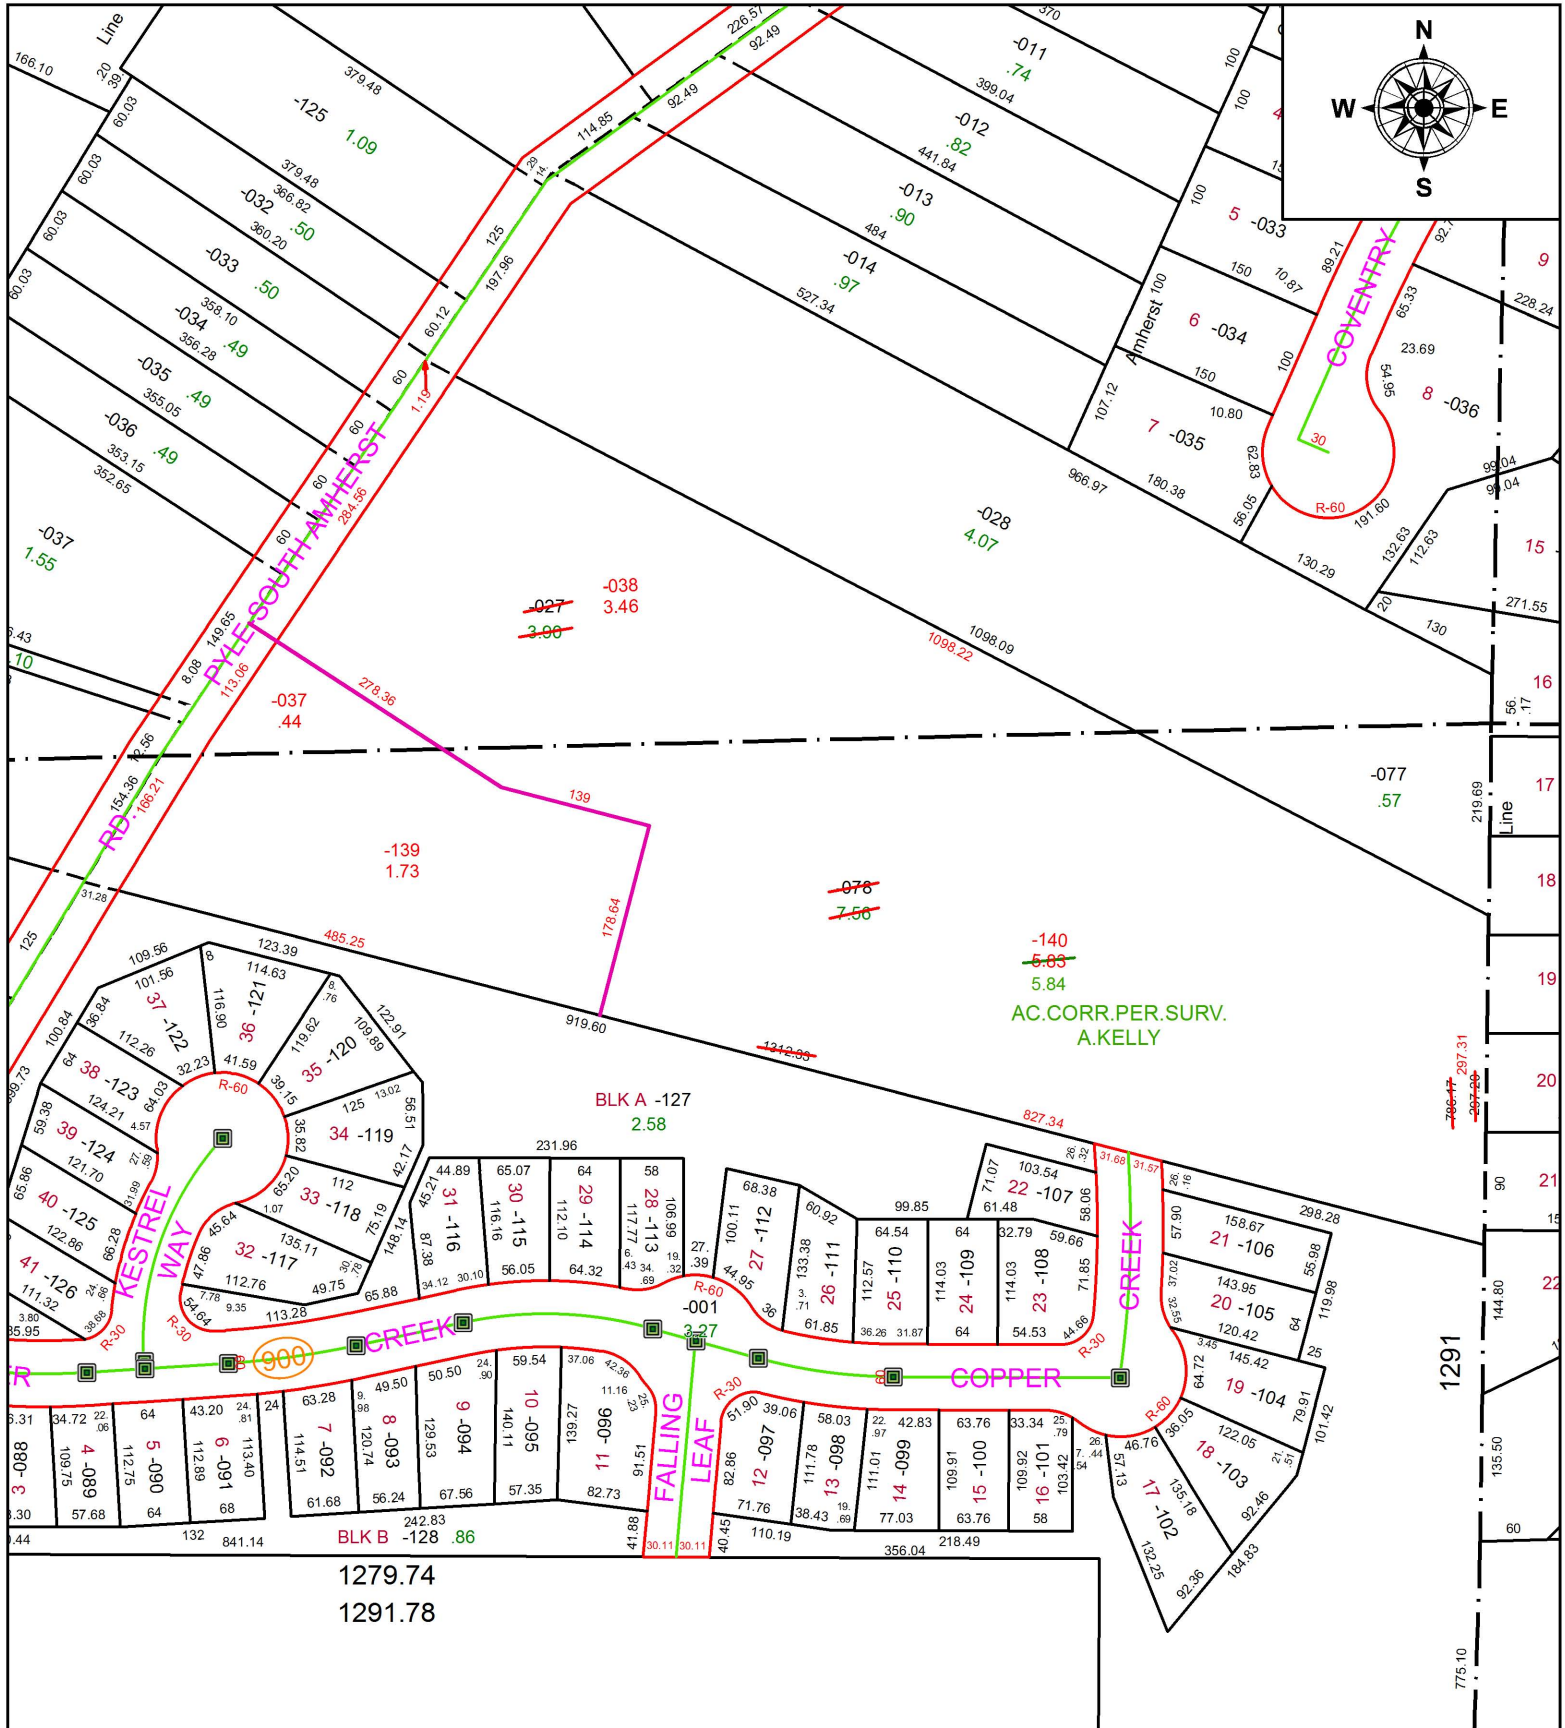

SPLITS/DEEDS PROCESSED
 LORAIN COUNTY TAX MAP DEPARTMENT
 226 MIDDLE AVE. ELYRIA, OH

SURVEYED BY: AMY M. KELLY
 CLOSURE: 1:856,675
 MAP PAGE(S): 5-00-015
 APPROVED BY: RRM DATE: 6-18-19
 SCALE: 1" = 175 PRIOR INSTRUMENT: 20040017353