


PARENT PARCEL: 18-00-027-101-002, -005

CHILD PARCEL:

STARTING POINT: NORTHWEST CORNER OF S/L 5 IN HEMENWAY ADDITION

18-03987-D

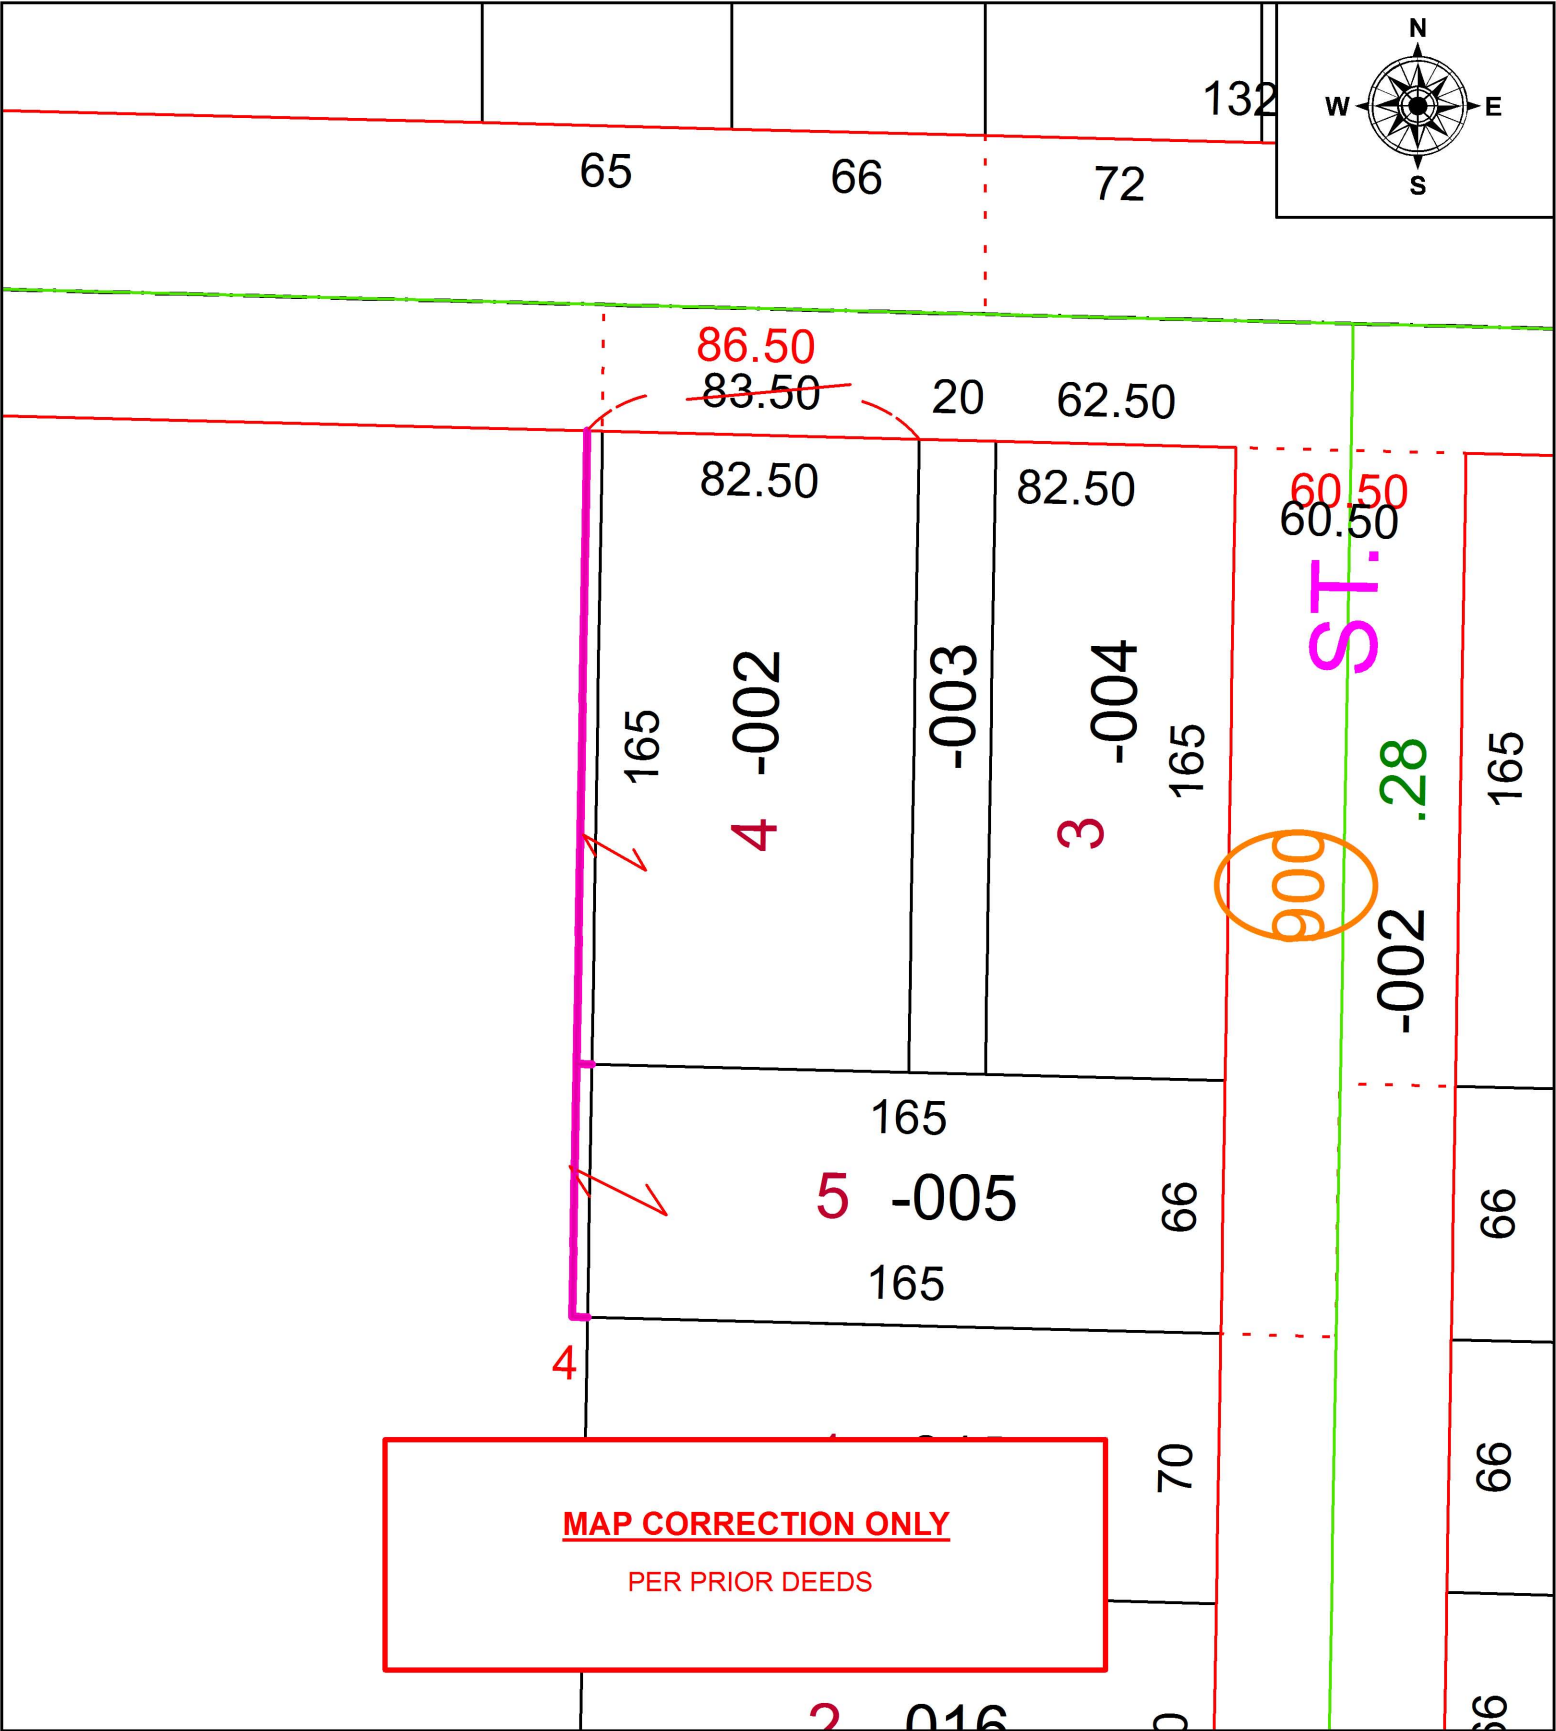

SPLITS/DEEDS PROCESSED
LORAIN COUNTY TAX MAP DEPARTMENT
226 MIDDLE AVE. ELYRIA, OH

SURVEYED BY:	N/A
CLOSURE:	N/A
MAP PAGE(S):	18-00-027
APPROVED BY:	RRM DATE: 12-6-18
SCALE:	1" = 50' PRIOR INSTRUMENT: 20040986491