
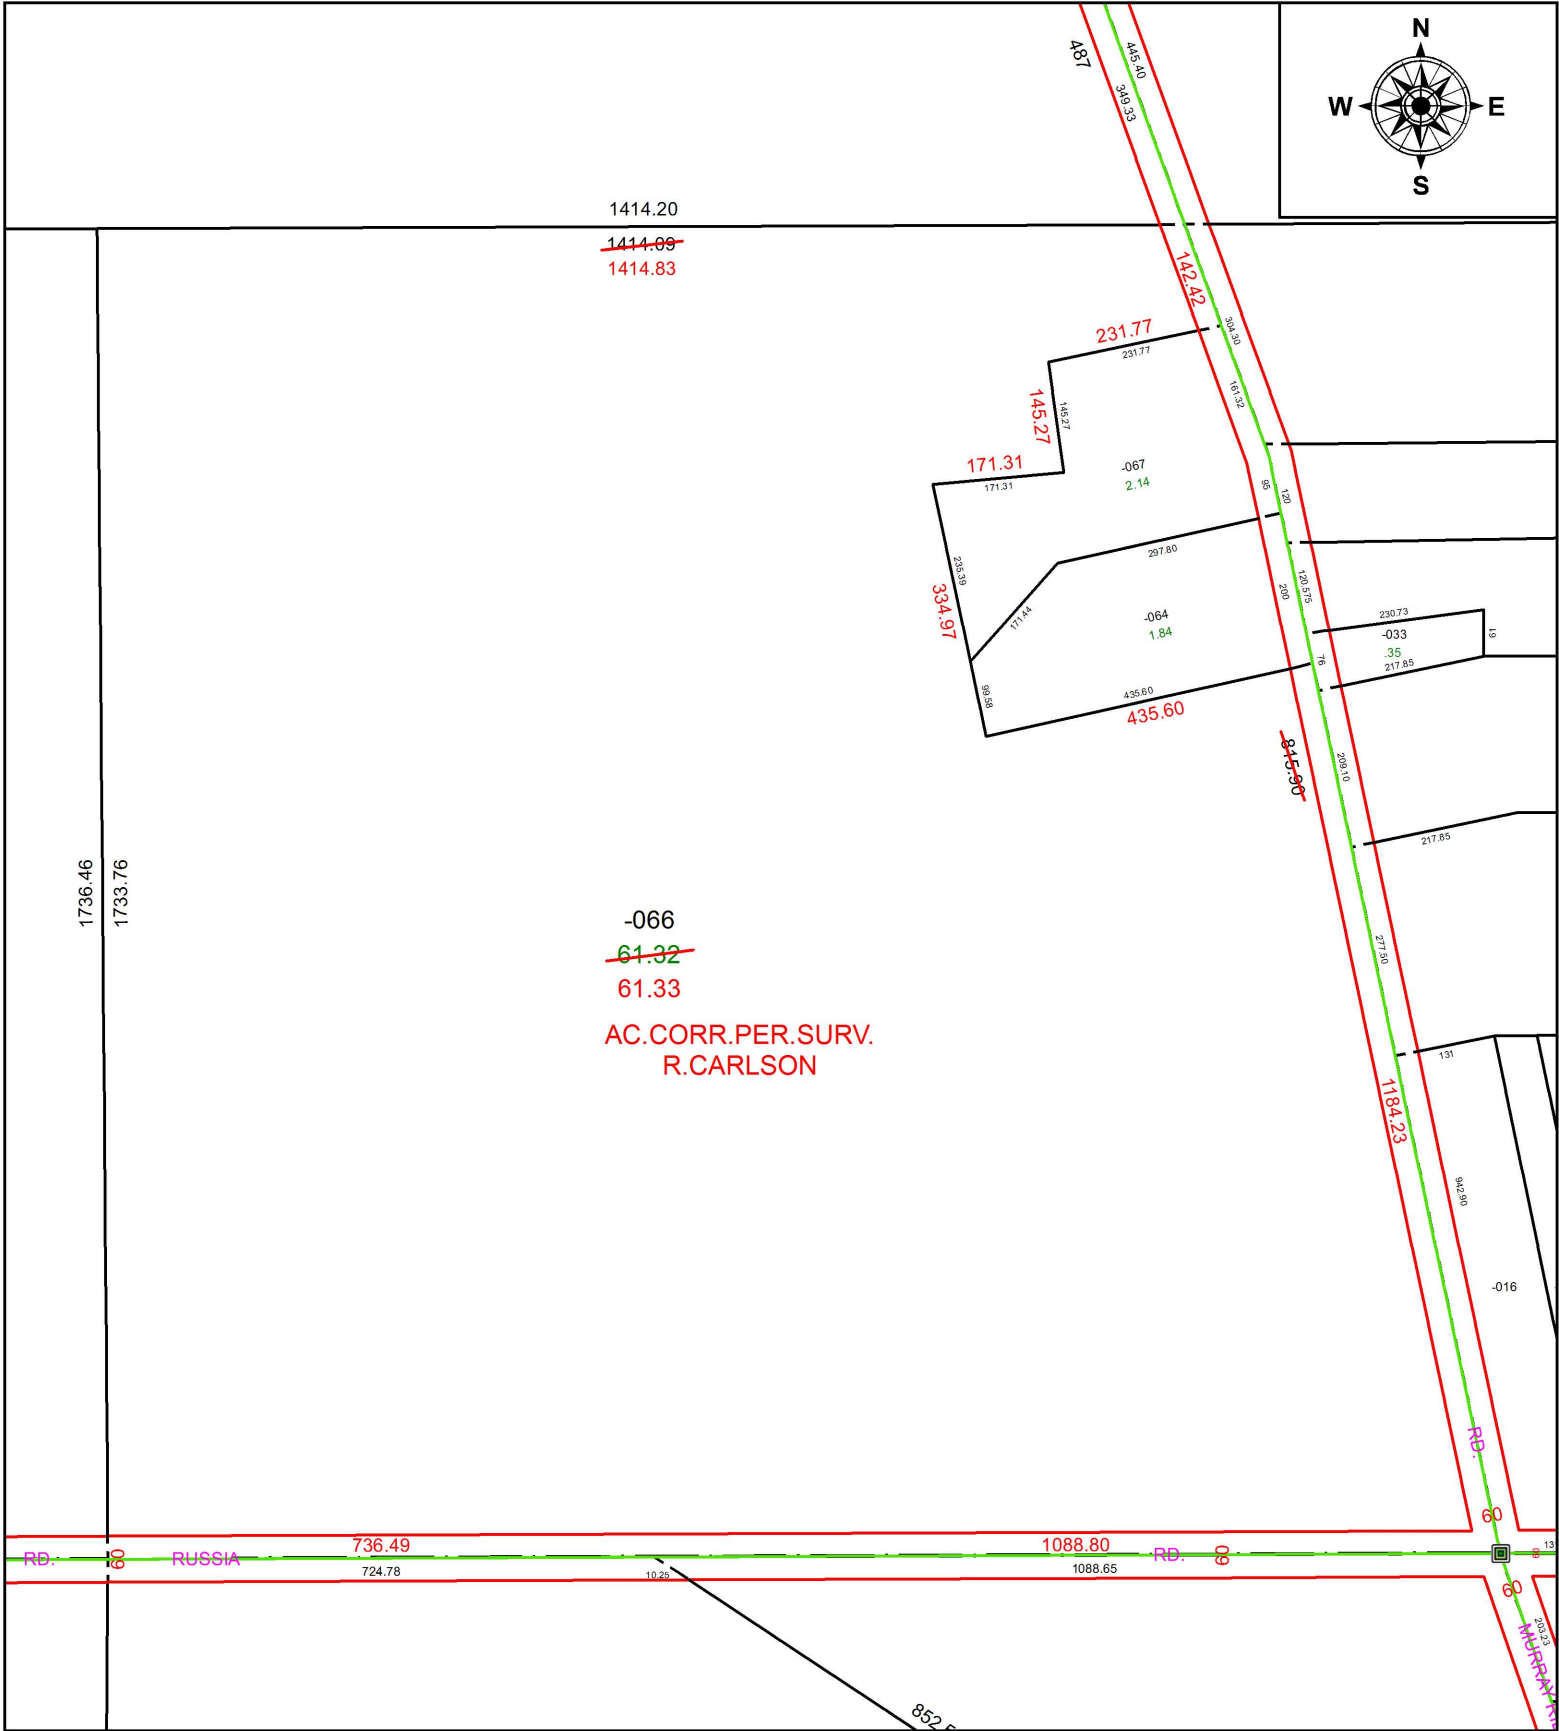


PARENT PARCEL: 10-00-002-000-066

CHILD PARCEL:

STARTING POINT: INTERSECTION OF C/L OF RUSSIA RD. AND C/L OF MURRAY RIDGE RD.


18-03988-A

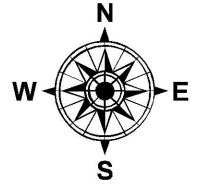

1414.20  
~~1414.09~~  
1414.83

-066  
~~61.32~~  
61.33

AC. CORR. PER. SURV.  
R. CARLSON

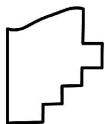

**SPLITS/DEEDS PROCESSED**  
LORAIN COUNTY TAX MAP DEPARTMENT  
226 MIDDLE AVE. ELYRIA, OH

SURVEYED BY: RICHARD D. CARLSON

CLOSURE: 1: 390,020

MAP PAGE(S): 10-00-002

APPROVED BY: RRM DATE: 12-10-18

SCALE: 1" = 250 PRIOR INSTRUMENT: 20040042982