


PARENT PARCEL: 04-00-020-104-621, -644

CHILD PARCEL: 04-00-020-104-661

STARTING POINT: INTERSECTION OF C/L OF LEAR NAGLE RD. AND C/L OF COUNTRY CLUB DR.

19-03992

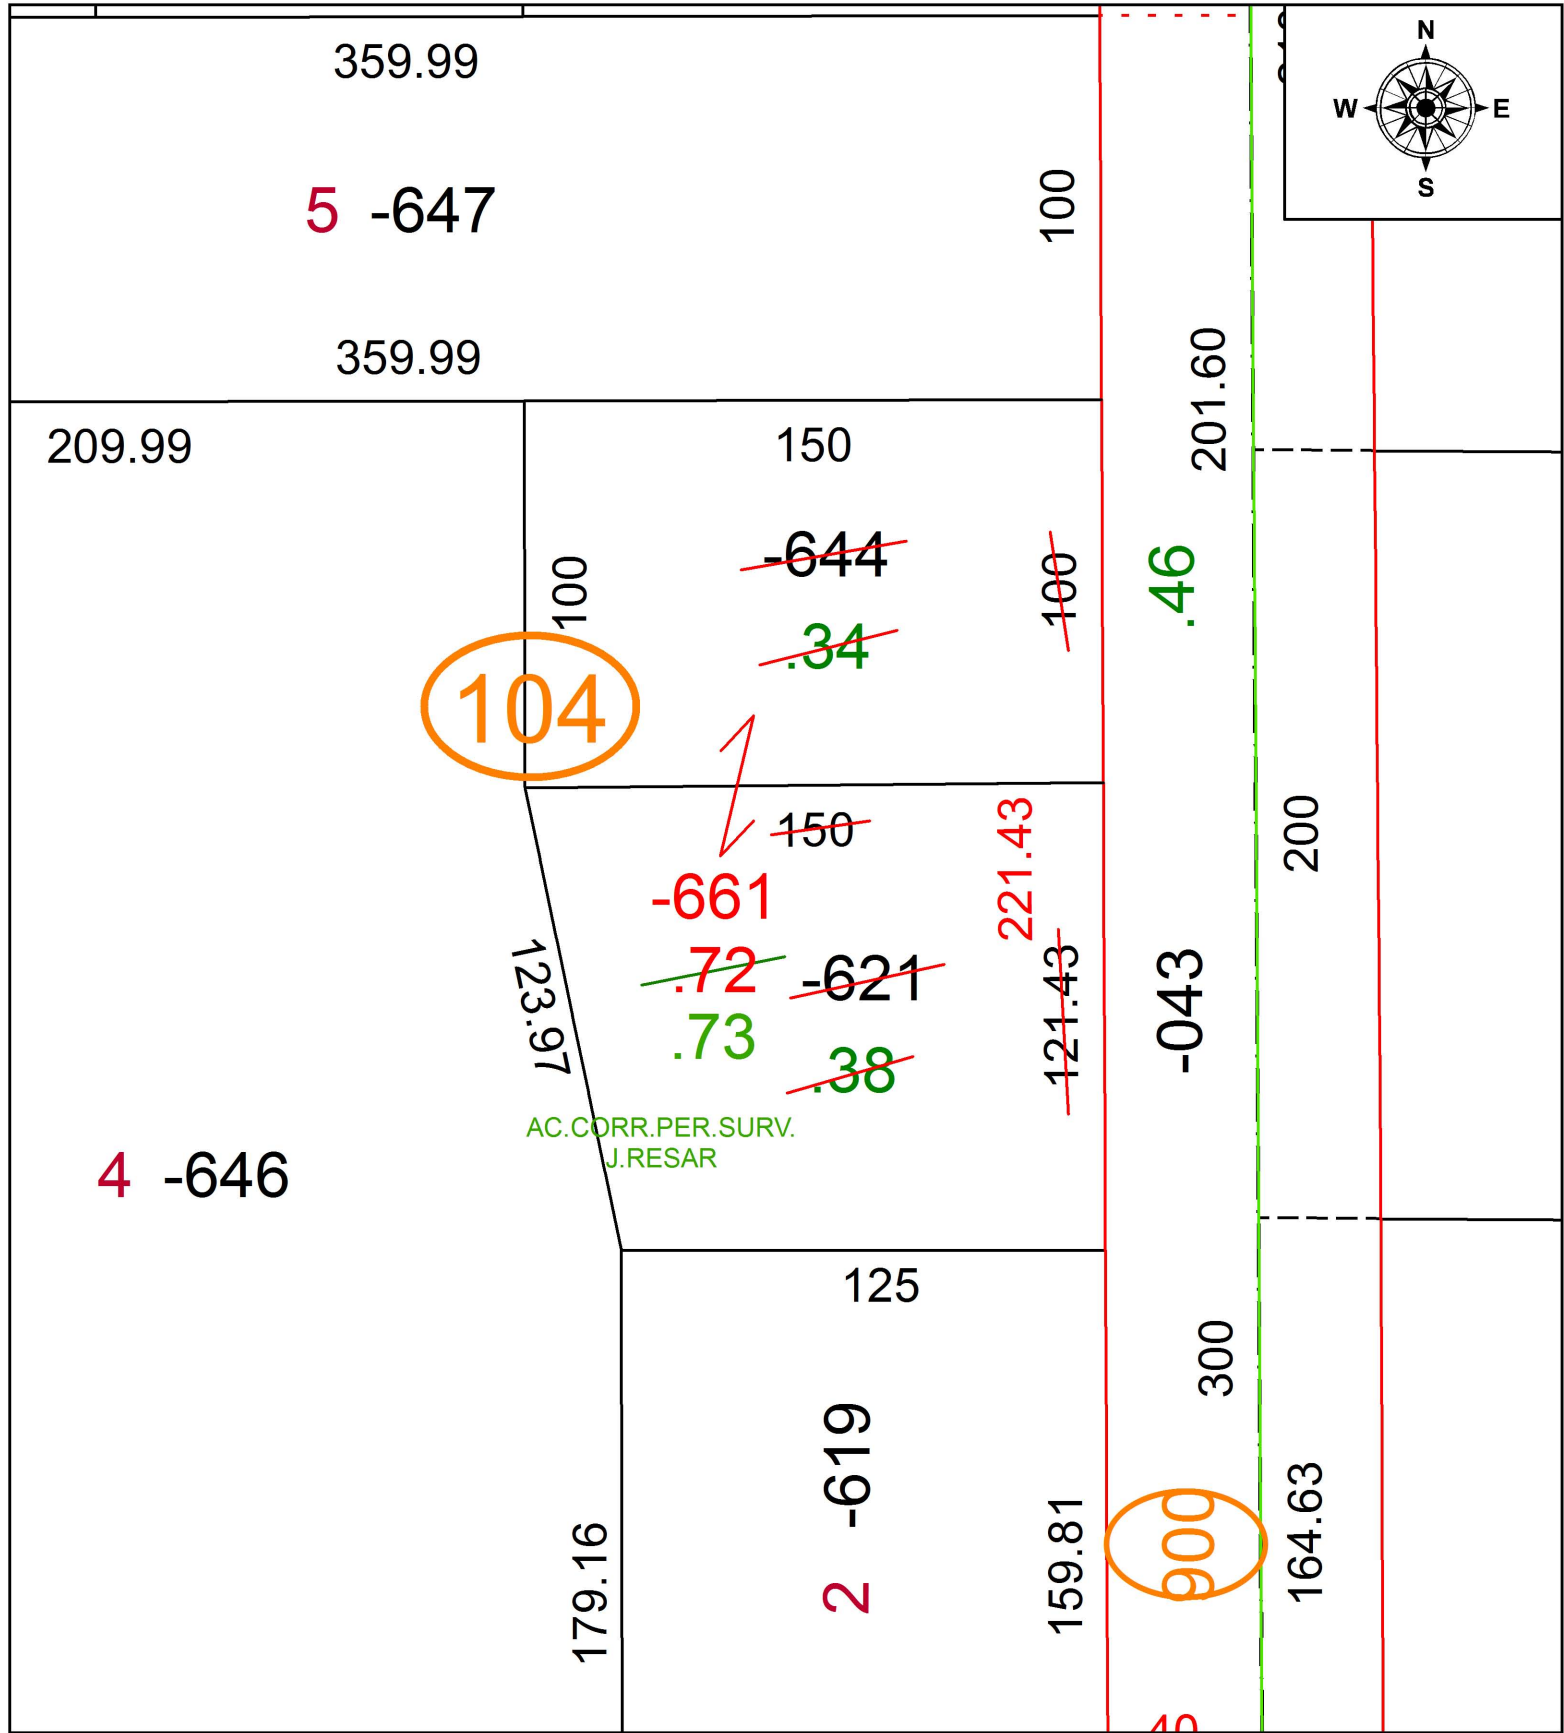

SPLITS/DEEDS PROCESSED
 LORAIN COUNTY TAX MAP DEPARTMENT
 226 MIDDLE AVE. ELYRIA, OH

SURVEYED BY: JAMES RESAR
 CLOSURE: 1:105,268
 MAP PAGE(S): 4-00-020
 APPROVED BY: RRM DATE: 7-15-19
 SCALE: 1" = 50' PRIOR INSTRUMENT: 20190716249