


PARENT PARCEL: 07-00-034-000-007, -008, -133

CHILD PARCEL: 07-00-034-000-135 THRU -137

STARTING POINT: INTESECTION OF C/L OF CENTER RIDGE RD. AND C/L OF RACE RD.

19-03998

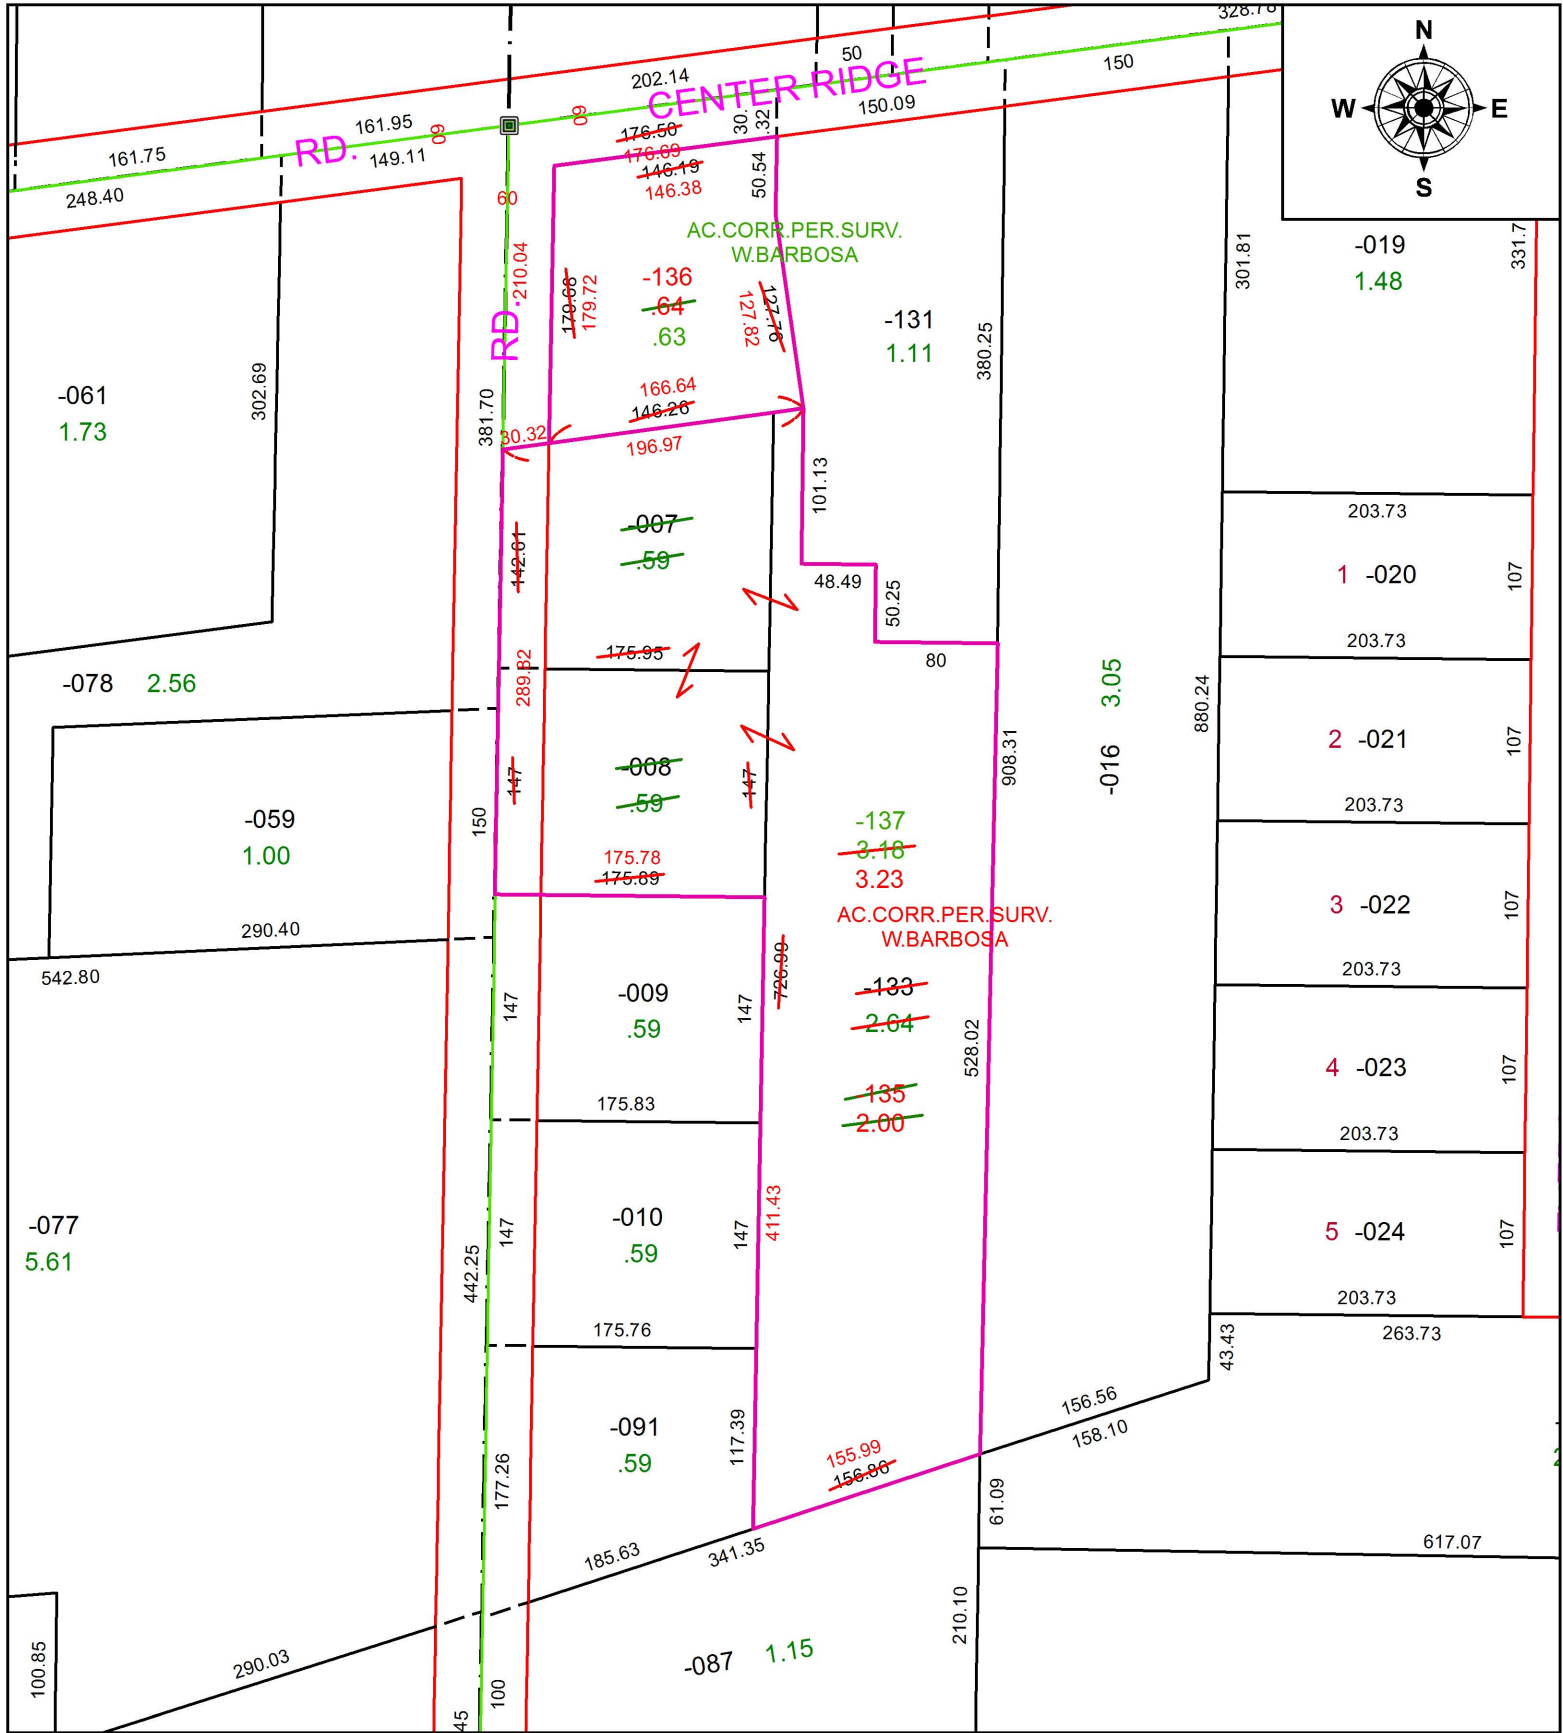

SPLITS/DEEDS PROCESSED
 LORAIN COUNTY TAX MAP DEPARTMENT
 226 MIDDLE AVE. ELYRIA, OH

SURVEYED BY: WILFREDO BARBOSA

CLOSURE: 1:328,342

MAP PAGE(S): 7-00-034

APPROVED BY: RRM DATE: 7-29-19

SCALE: 1" = 125 PRIOR INSTRUMENT: 20170616479