


PARENT PARCEL: 05-00-046-000-063


CHILD PARCEL: PARCEL NO. CORR. TO 05-00-046-000-029

STARTING POINT: CENTERLINE OF OBERLIN NORTH RD. & O.L. 46

NO. 00079

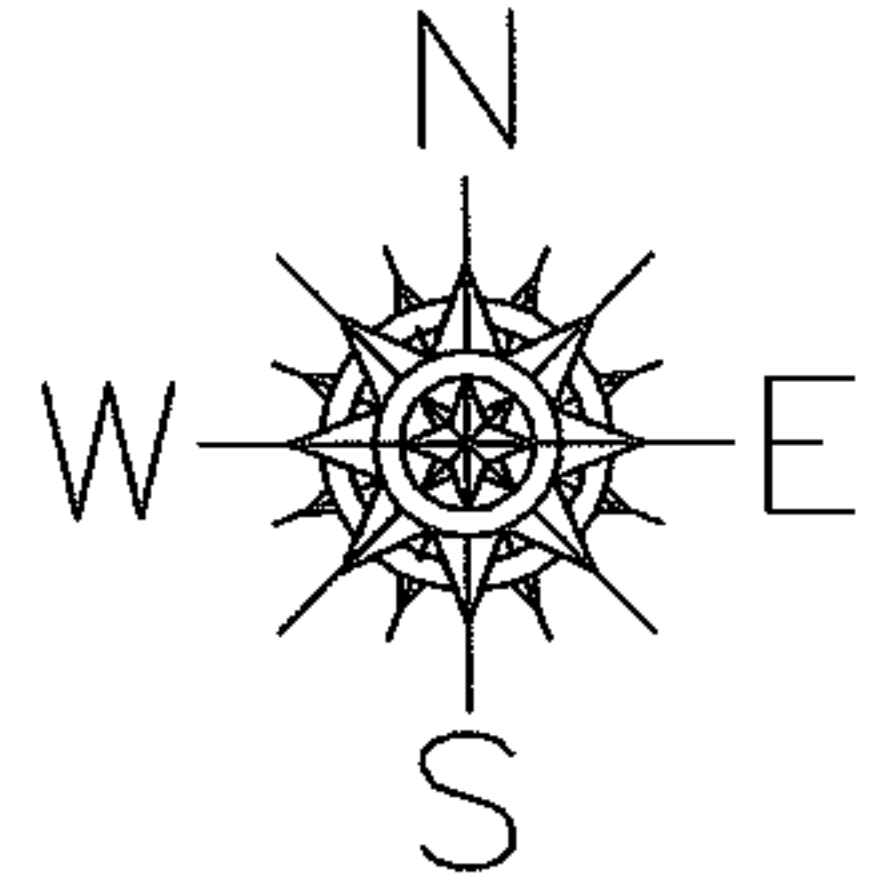

OBERLIN NORTH RD.

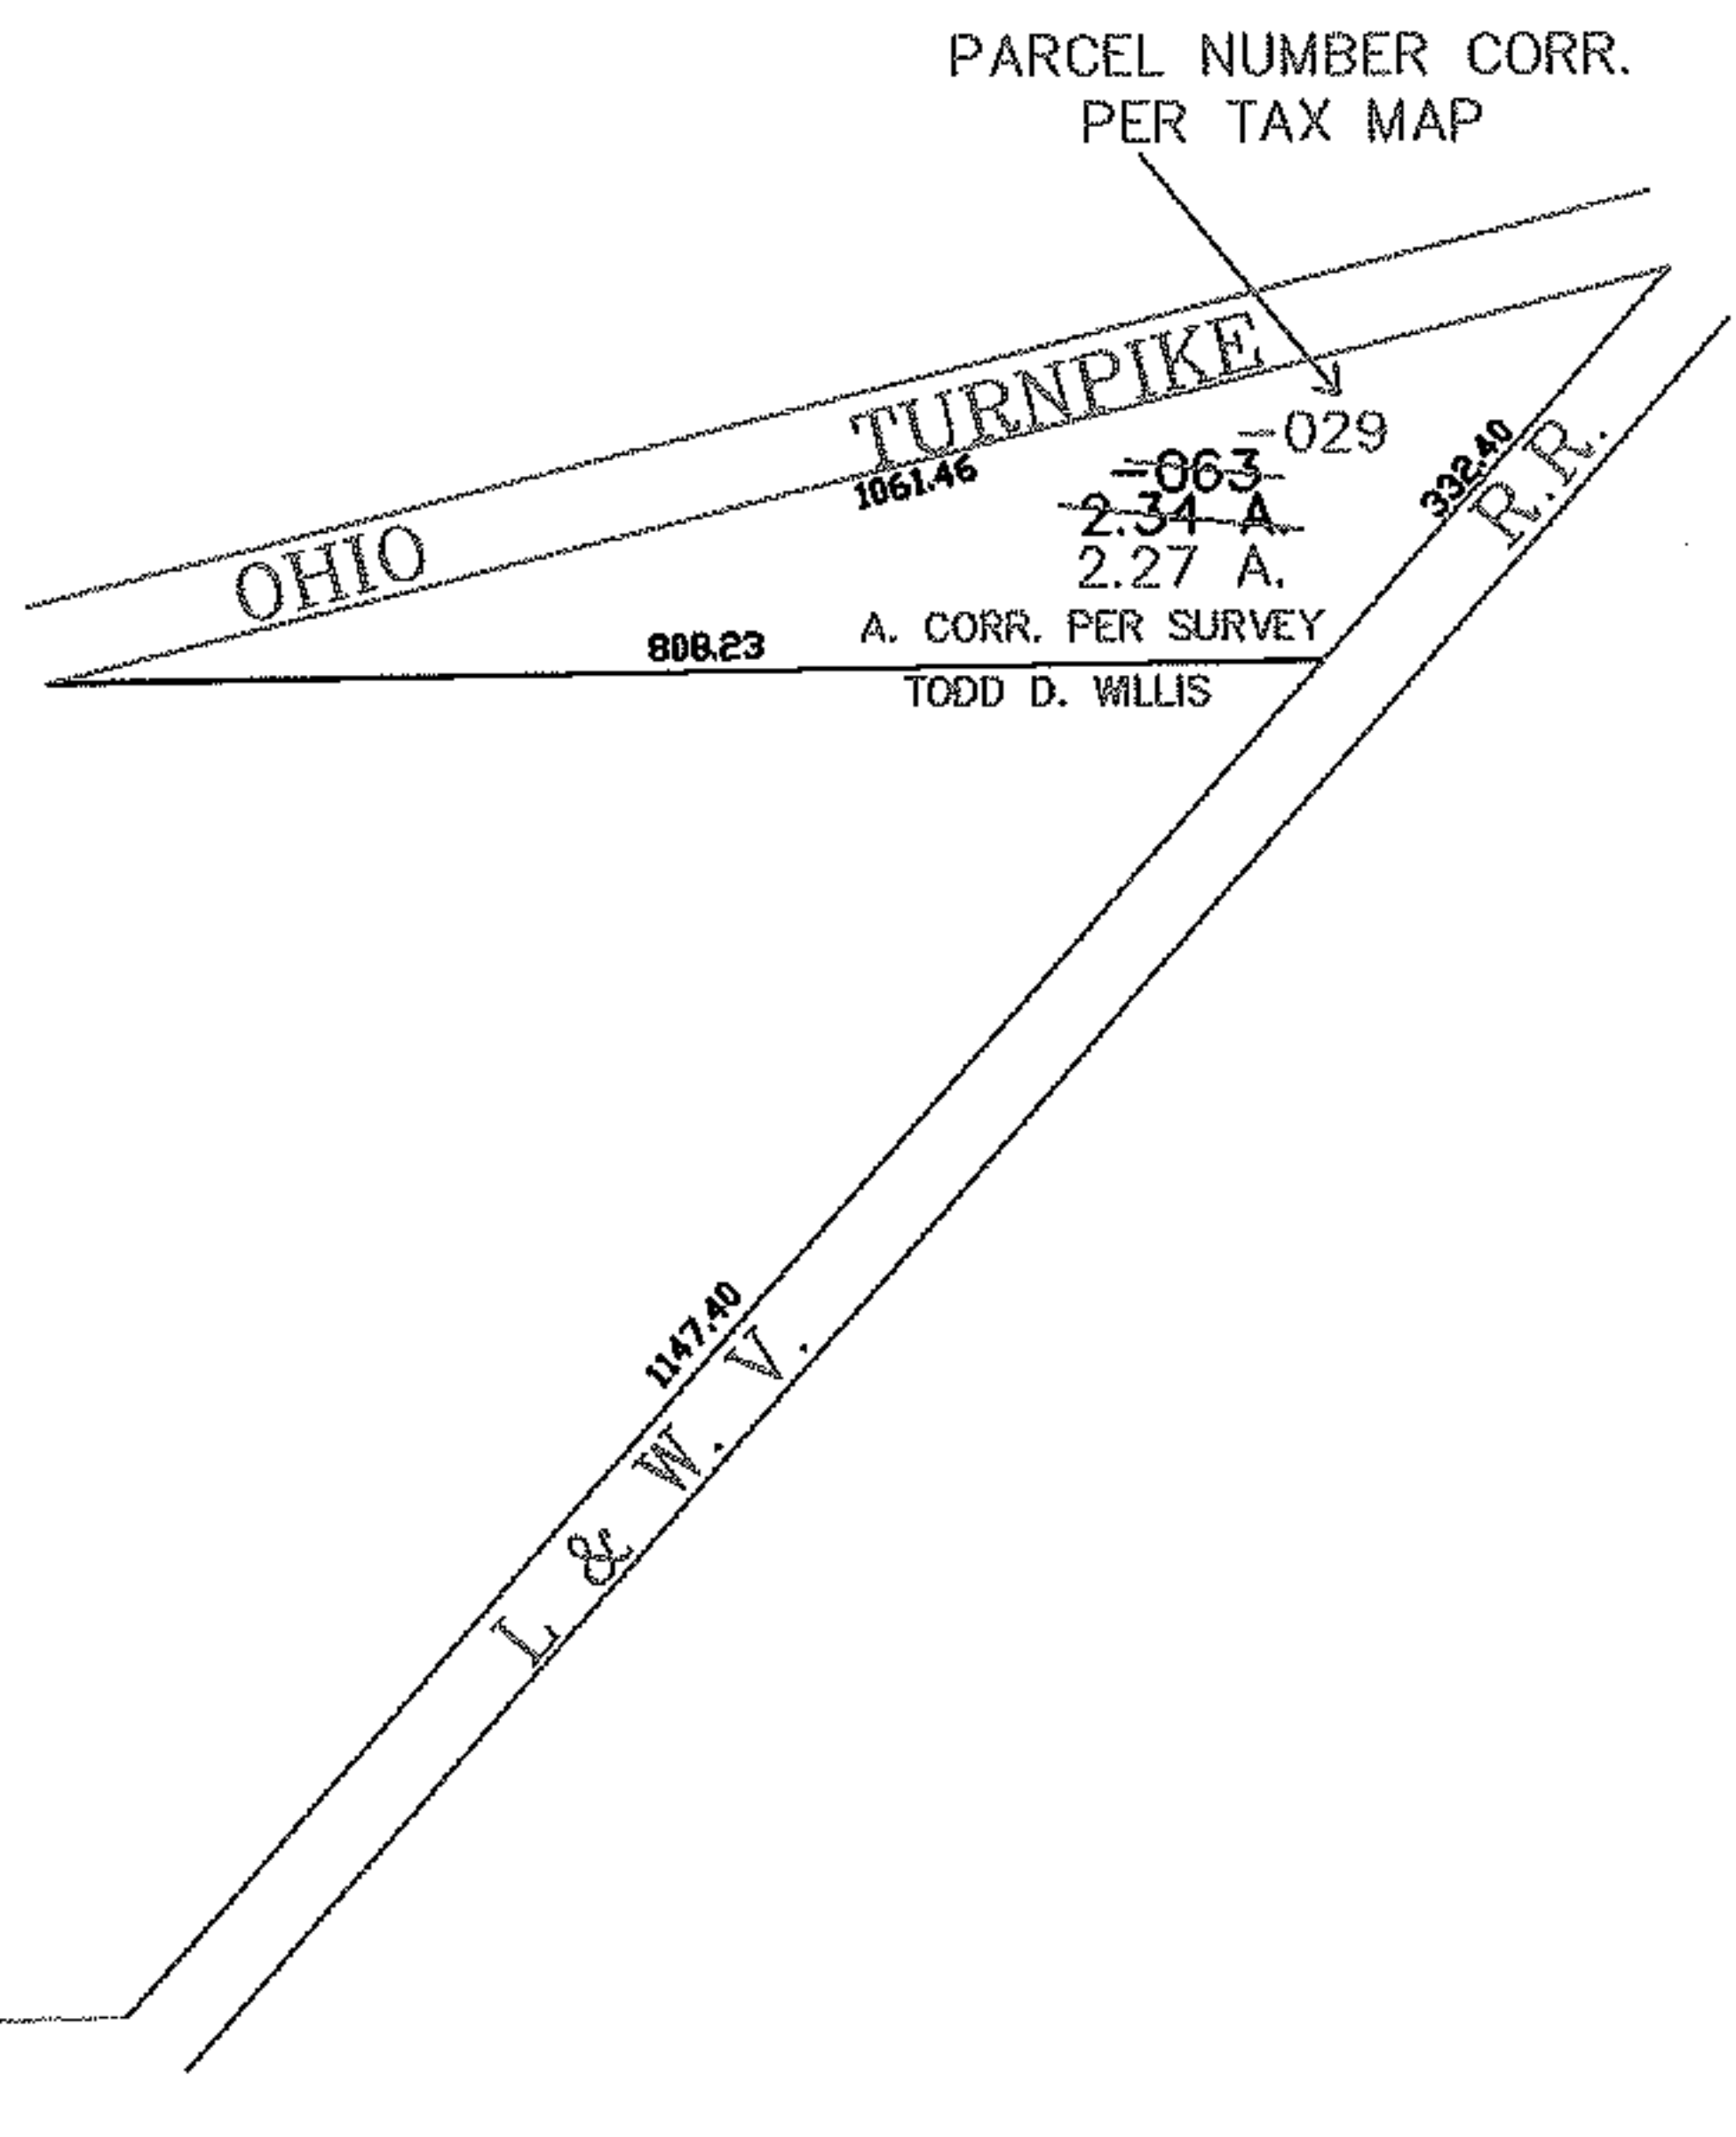

PARCEL NUMBER CORR. PER TAX MAP


TURNPIKE  
1061.46  
-063-029  
2.34 A.  
2.27 A.

808.23 A. CORR. PER SURVEY  
TODD D. WILLIS

882.93 O.L. 46  
O.L. 47

1147.40  
L. & W. V.

332.40  
R.R.

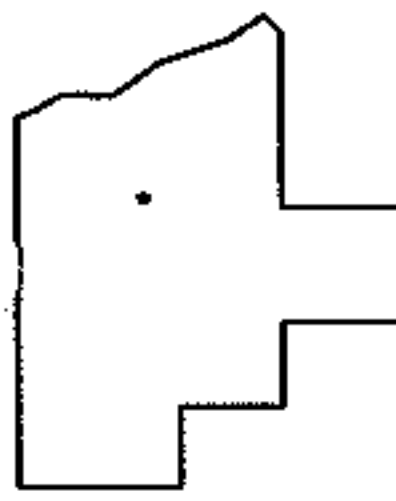

**SPLITS/DEEDS PROCESSED**  
LORAIN COUNTY TAX MAP DEPARTMENT  
226 MIDDLE AVE. ELYRIA, OHIO

SURVEYED BY: TODD D. WILLIS  
CLOSURE: 0.00 : 10.000  
MAP PAGE(S): 05-00-046-B  
APPROVED BY: JAH DATE: 02-10-04  
SCALE: 1" = 300 PRIOR INSTRUMENT: OR 1121/684