
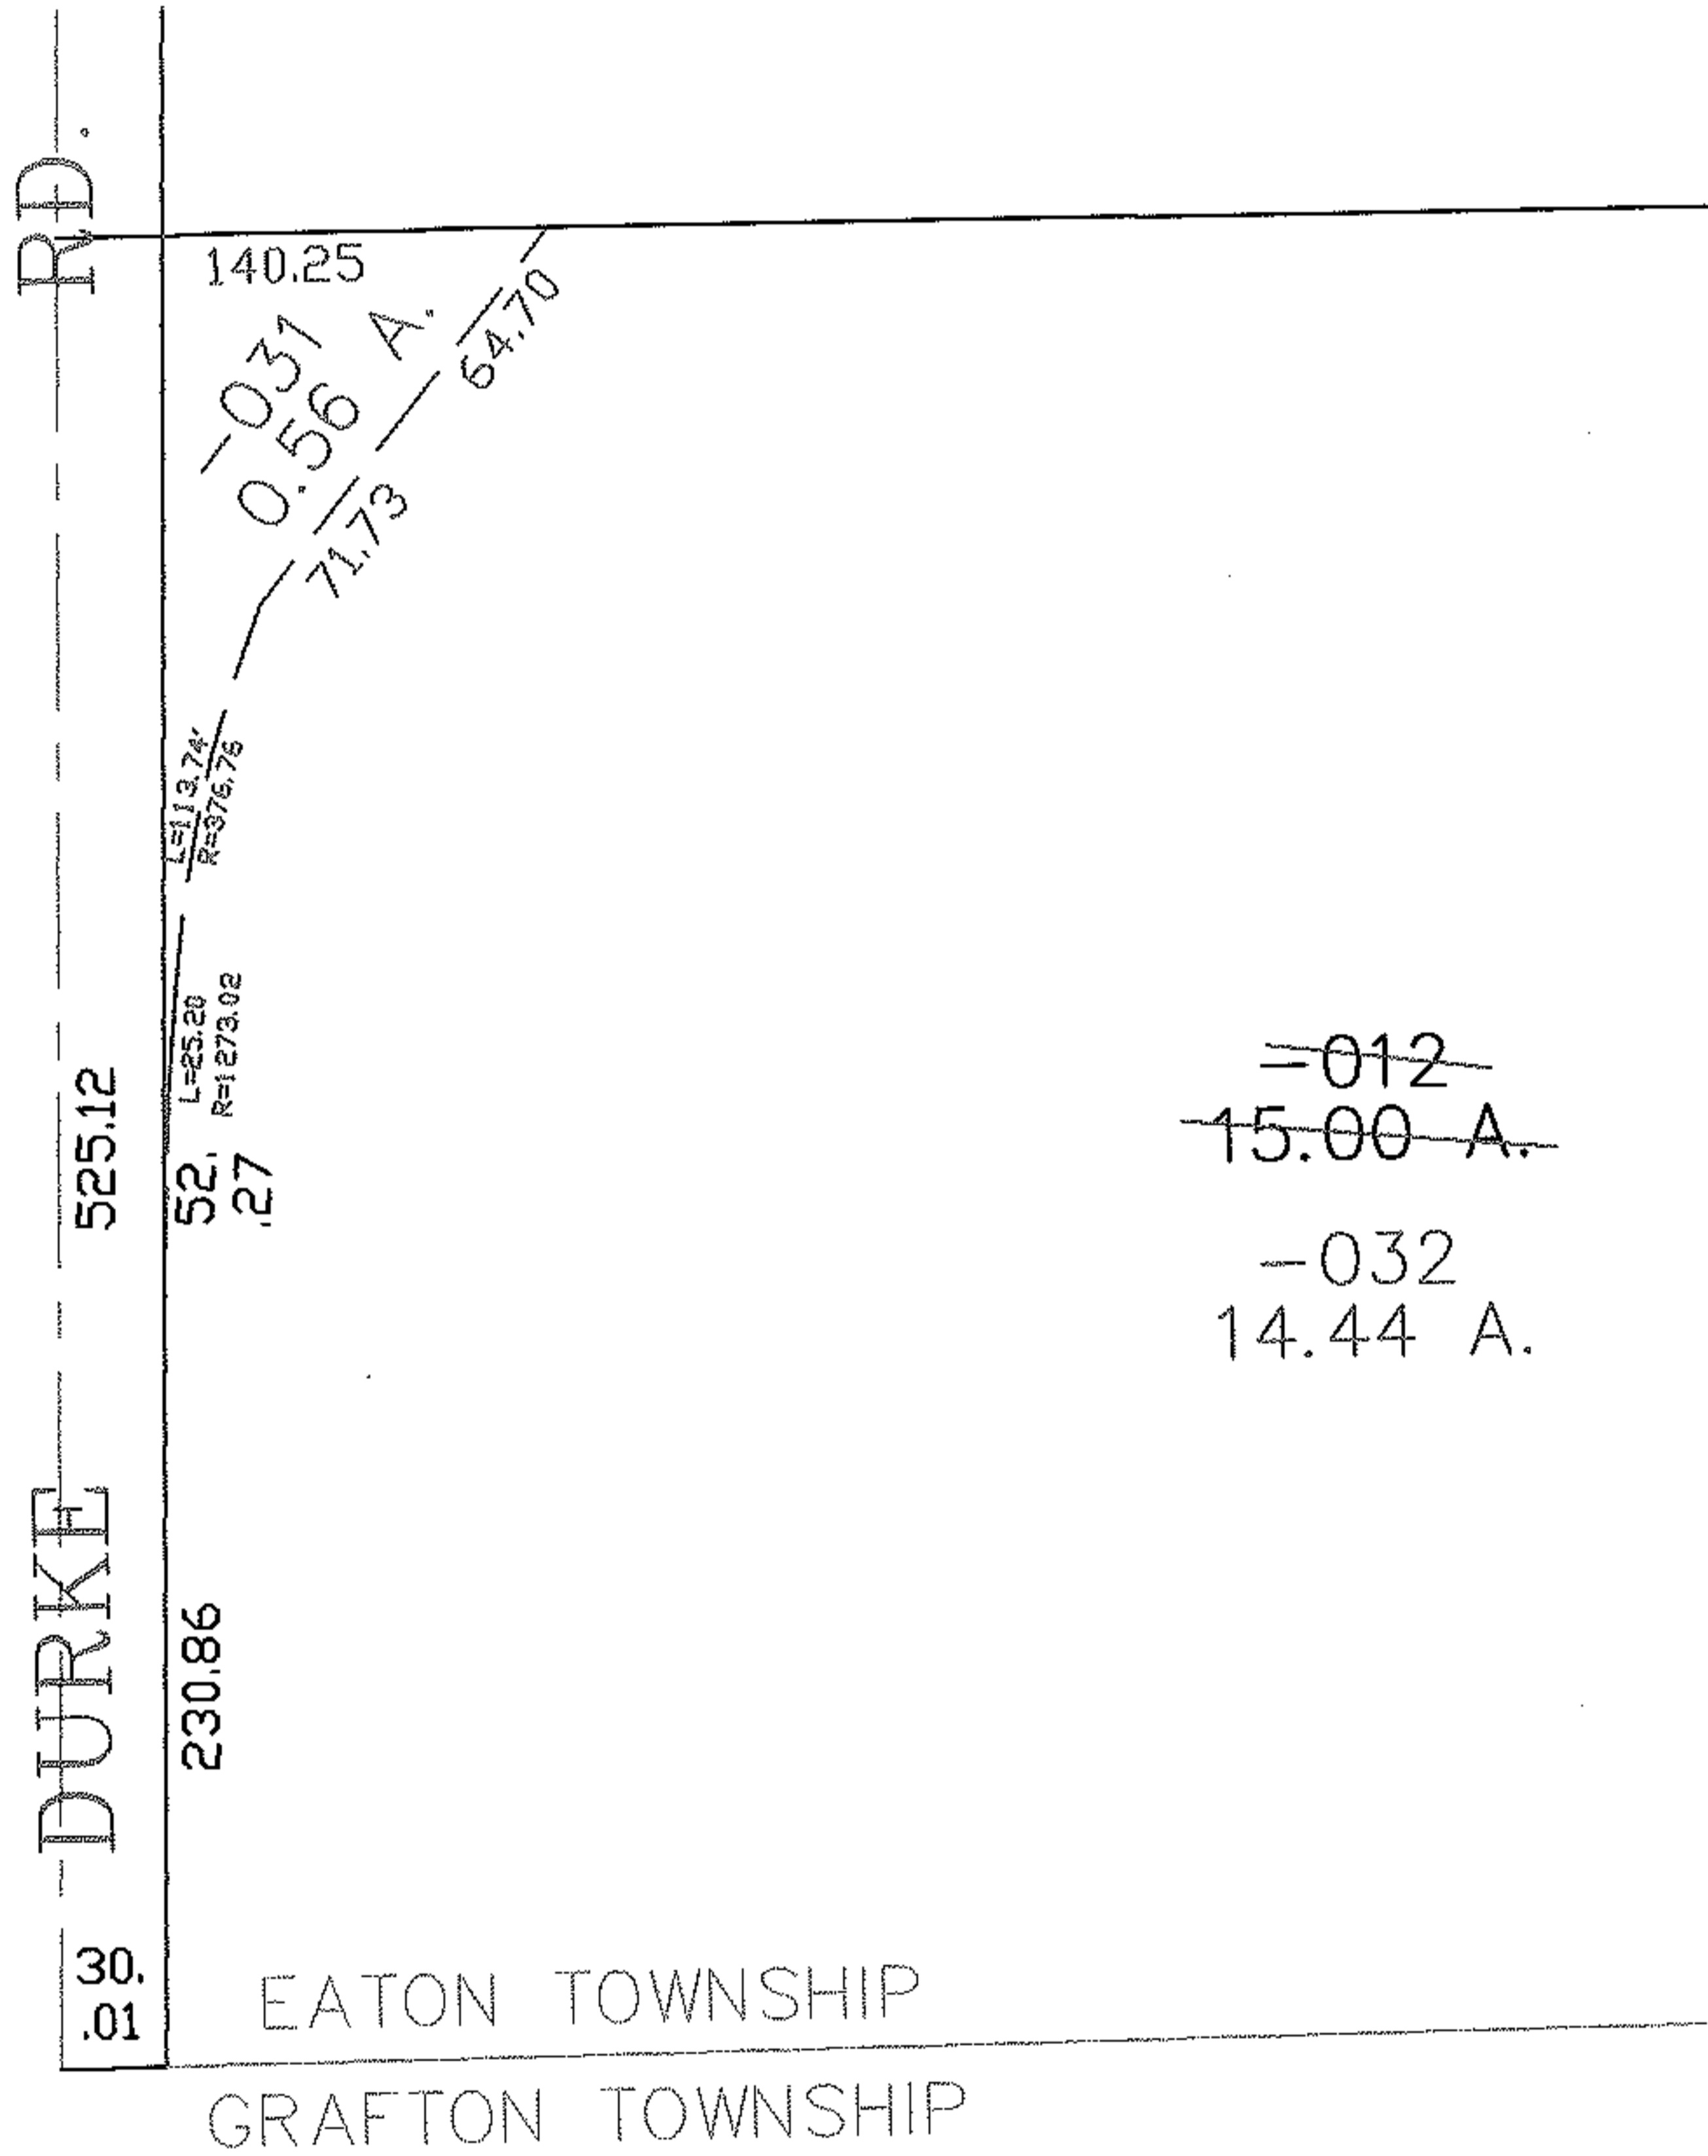


PARENT PARCEL: 11-00-080-000-012


CHILD PARCEL: 11-00-080-000-031, -032

STARTING POINT: CENTERLINE OF DURKEE RD. & O.L. 80

NO. 00081

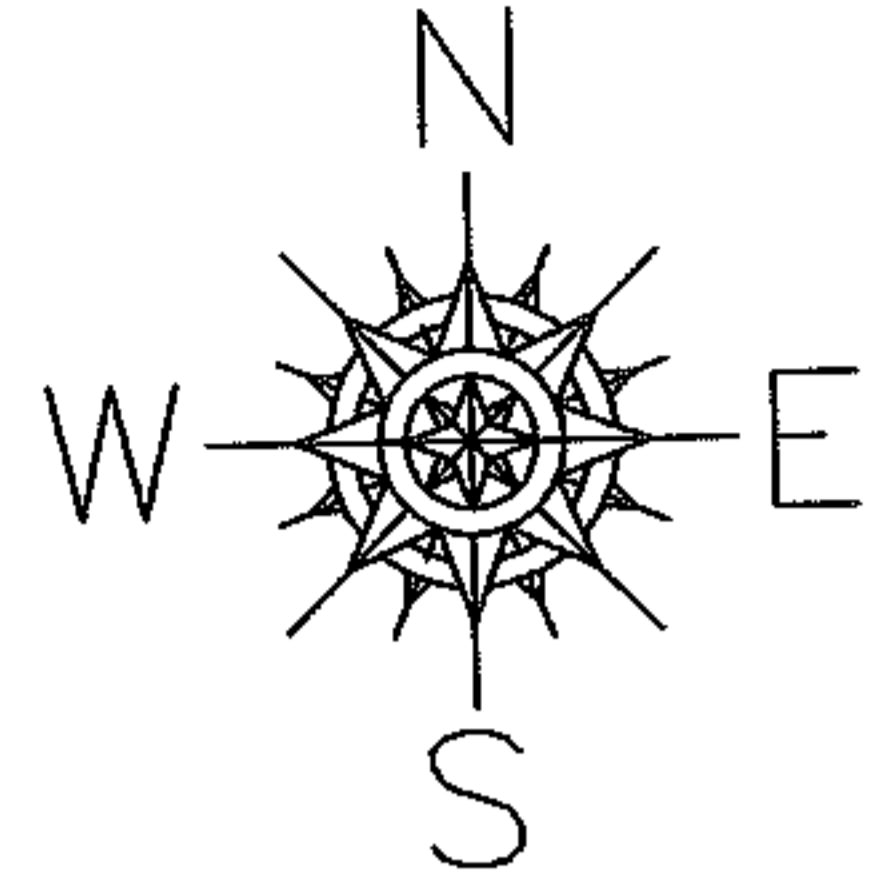

~~-012~~  
~~15.00 A.~~  
~~-032~~  
14.44 A.

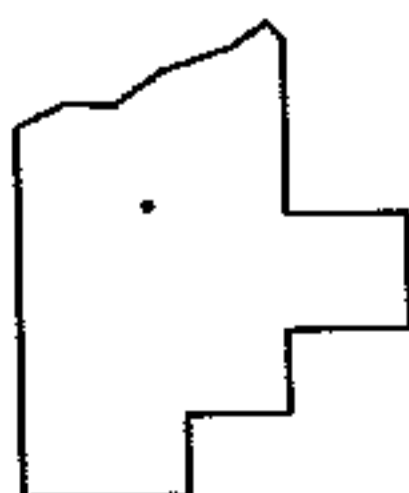

**SPLITS/DEEDS PROCESSED**

LORAIN COUNTY TAX MAP DEPARTMENT  
226 MIDDLE AVE. ELYRIA, OHIO

SURVEYED BY: CHARLES P. UNTERREINER  
CLOSURE: 0.01 : 10,000  
MAP PAGE(S): 11-00-080-A  
APPROVED BY: JAH DATE: 4-6-04  
SCALE: 1" = 100' PRIOR INSTRUMENT: DV 273/384