


PARENT PARCEL: 11-00-080-000-010


CHILD PARCEL: 11-00-080-000-035, -036

STARTING POINT: CENTERLINE OF DURKEE RD. & O.L. 80

NO. 00087

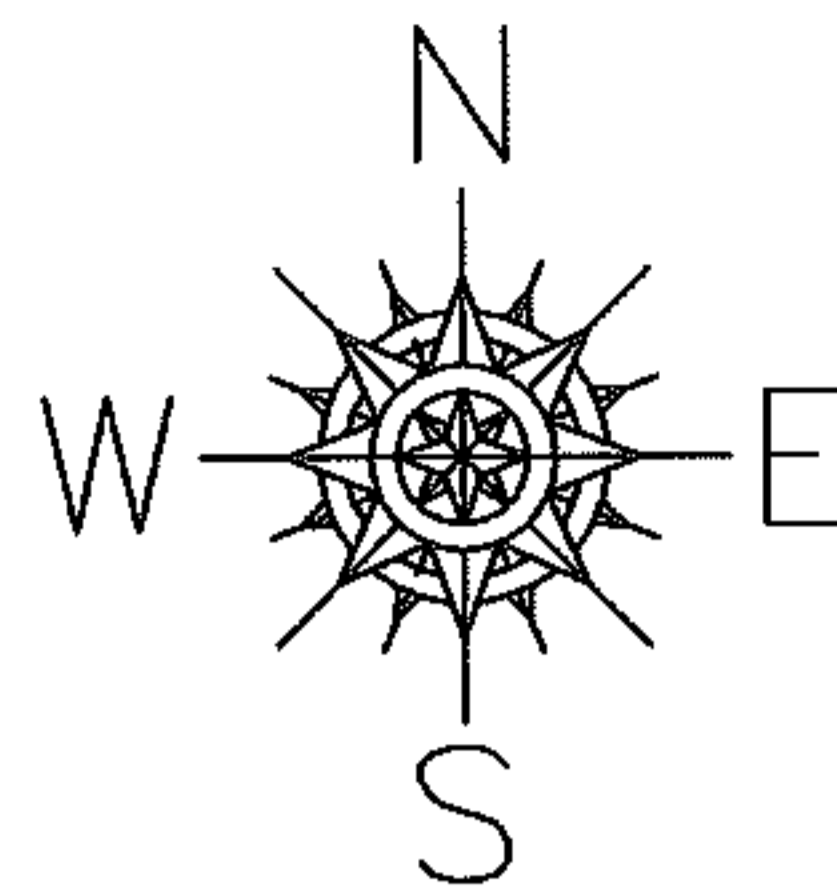

DURKEE RD.

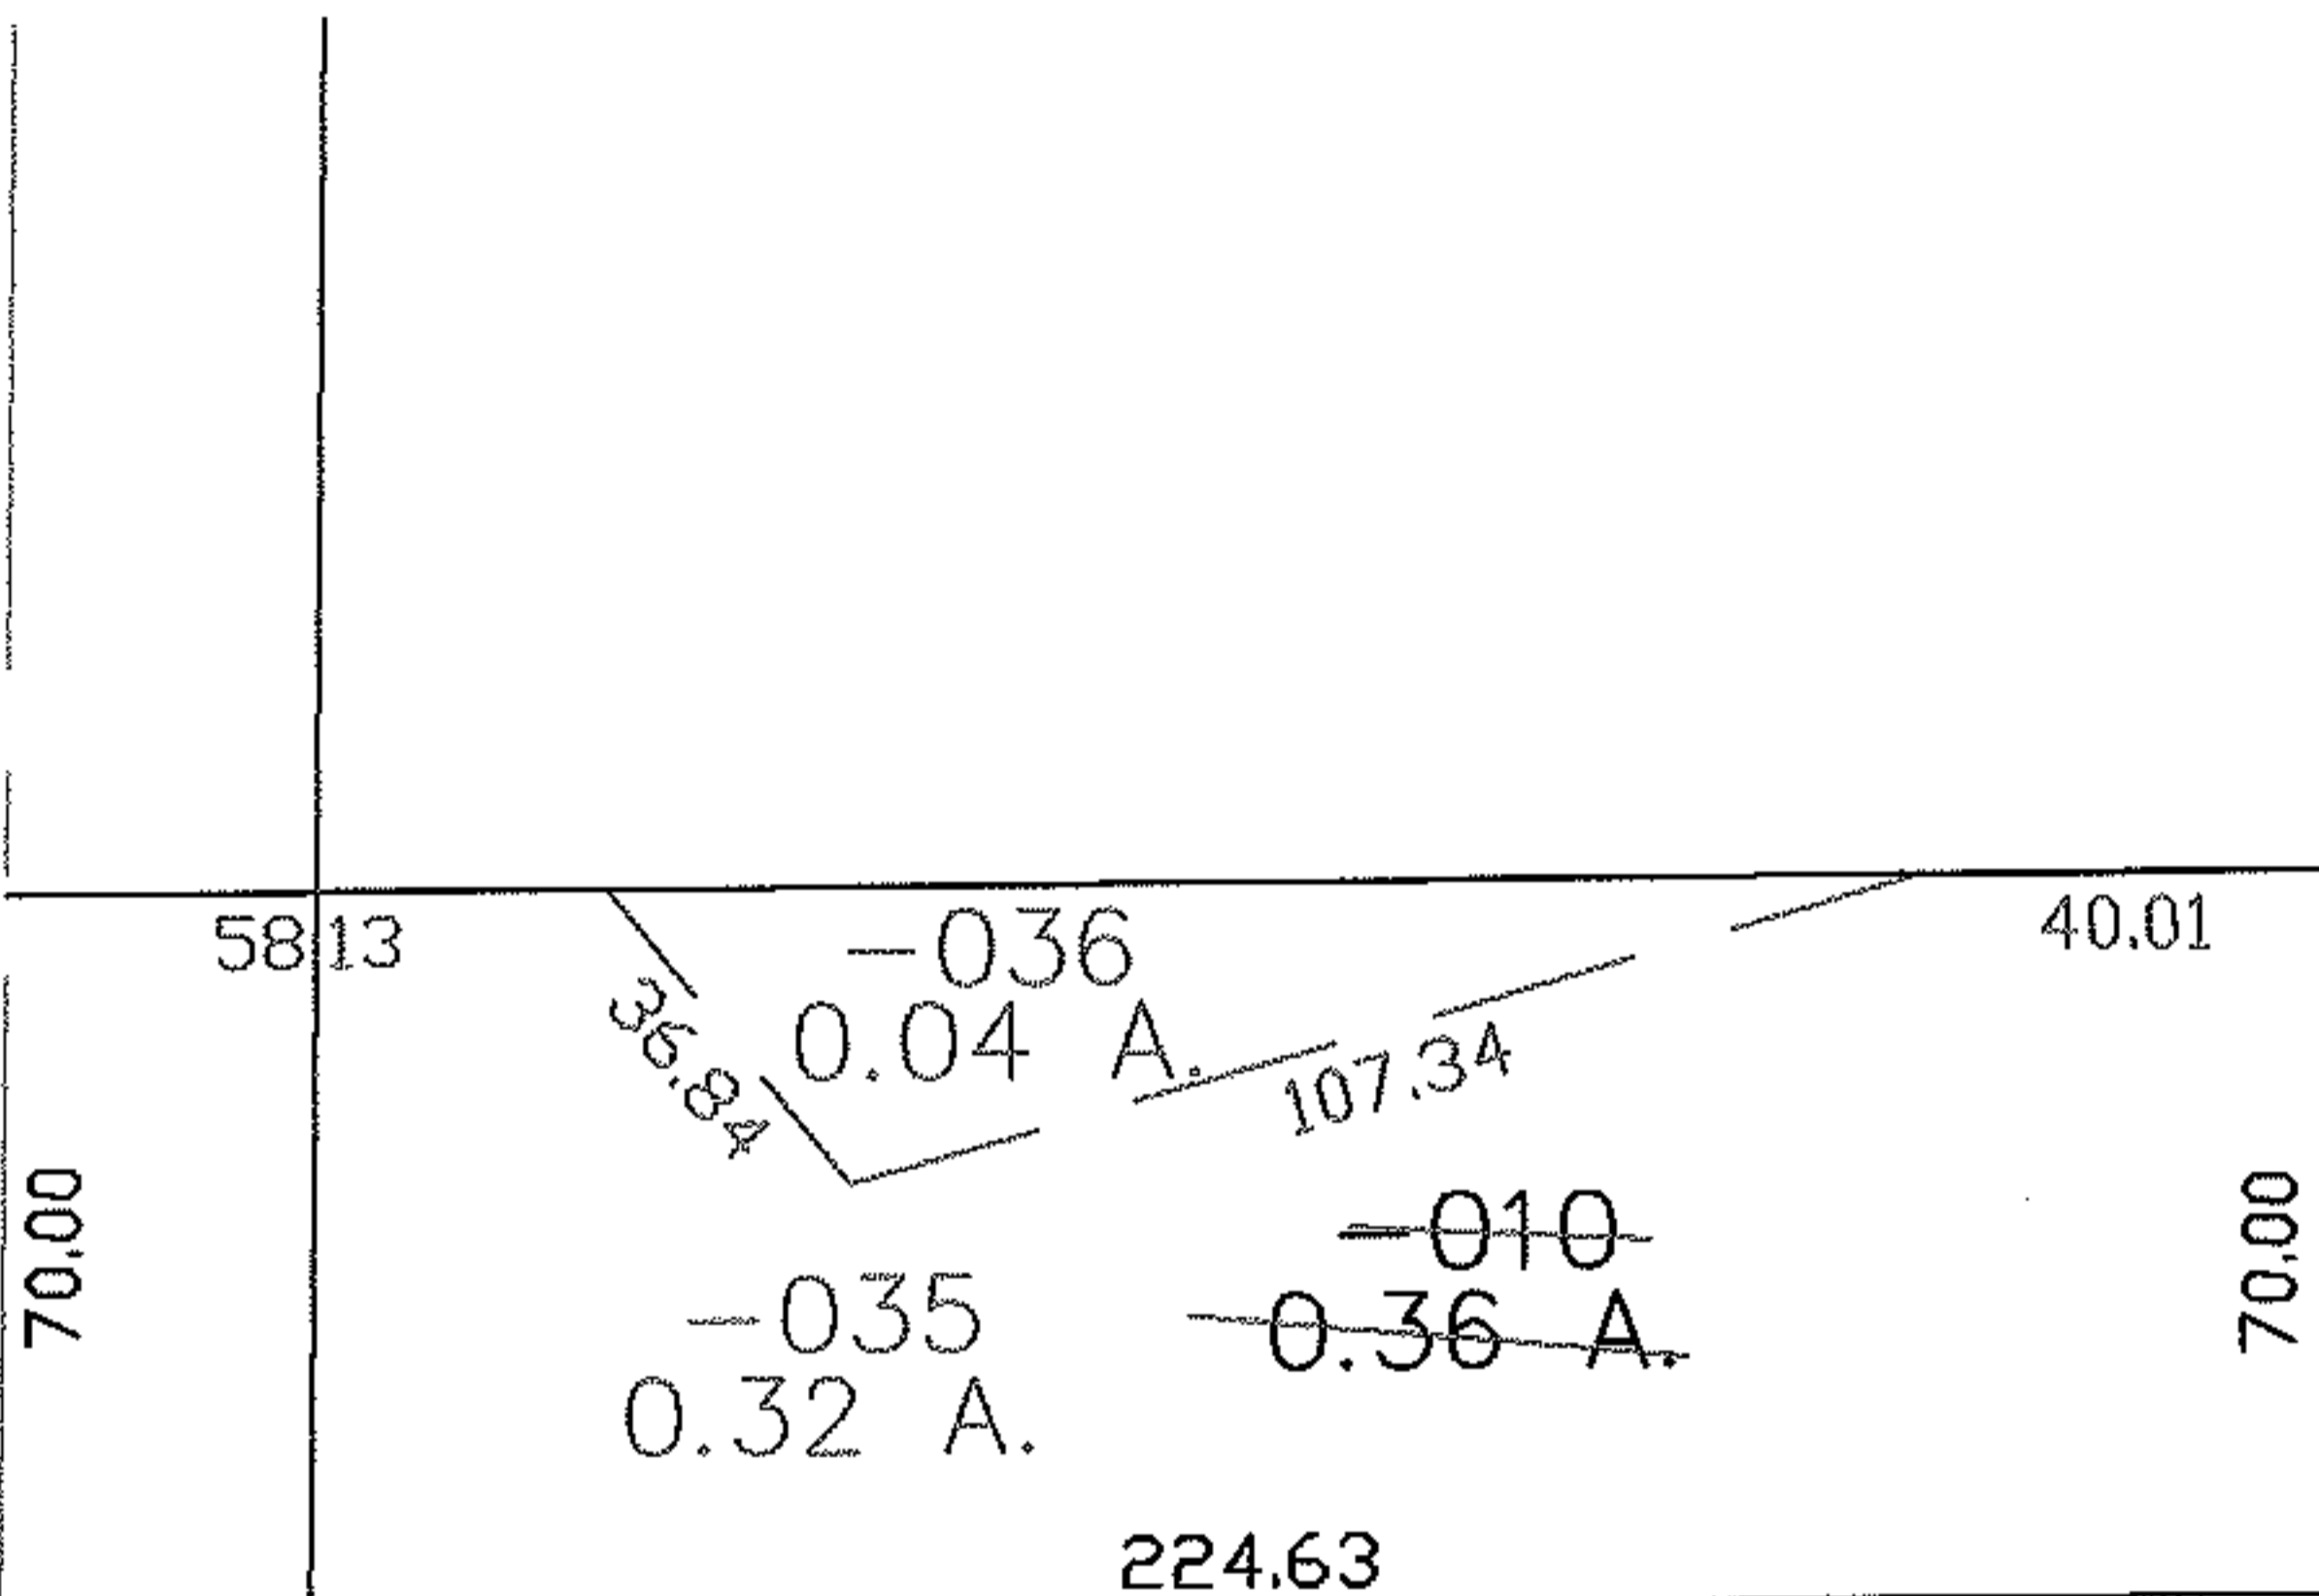

DURKEE

605.12

EATON TOWNSHIP

GRAFTON TOWNSHIP

**SPLITS/DEEDS PROCESSED**

LORAIN COUNTY TAX MAP DEPARTMENT  
226 MIDDLE AVE. ELYRIA, OHIO

SURVEYED BY: CHARLES P. UNTEERREINER

CLOSURE: 0.00 : 10.000

MAP PAGE(S): 11-00-080-A

APPROVED BY: JAH DATE: 4-22-04

SCALE: 1" = 100 PRIOR INSTRUMENT: 20000696857