
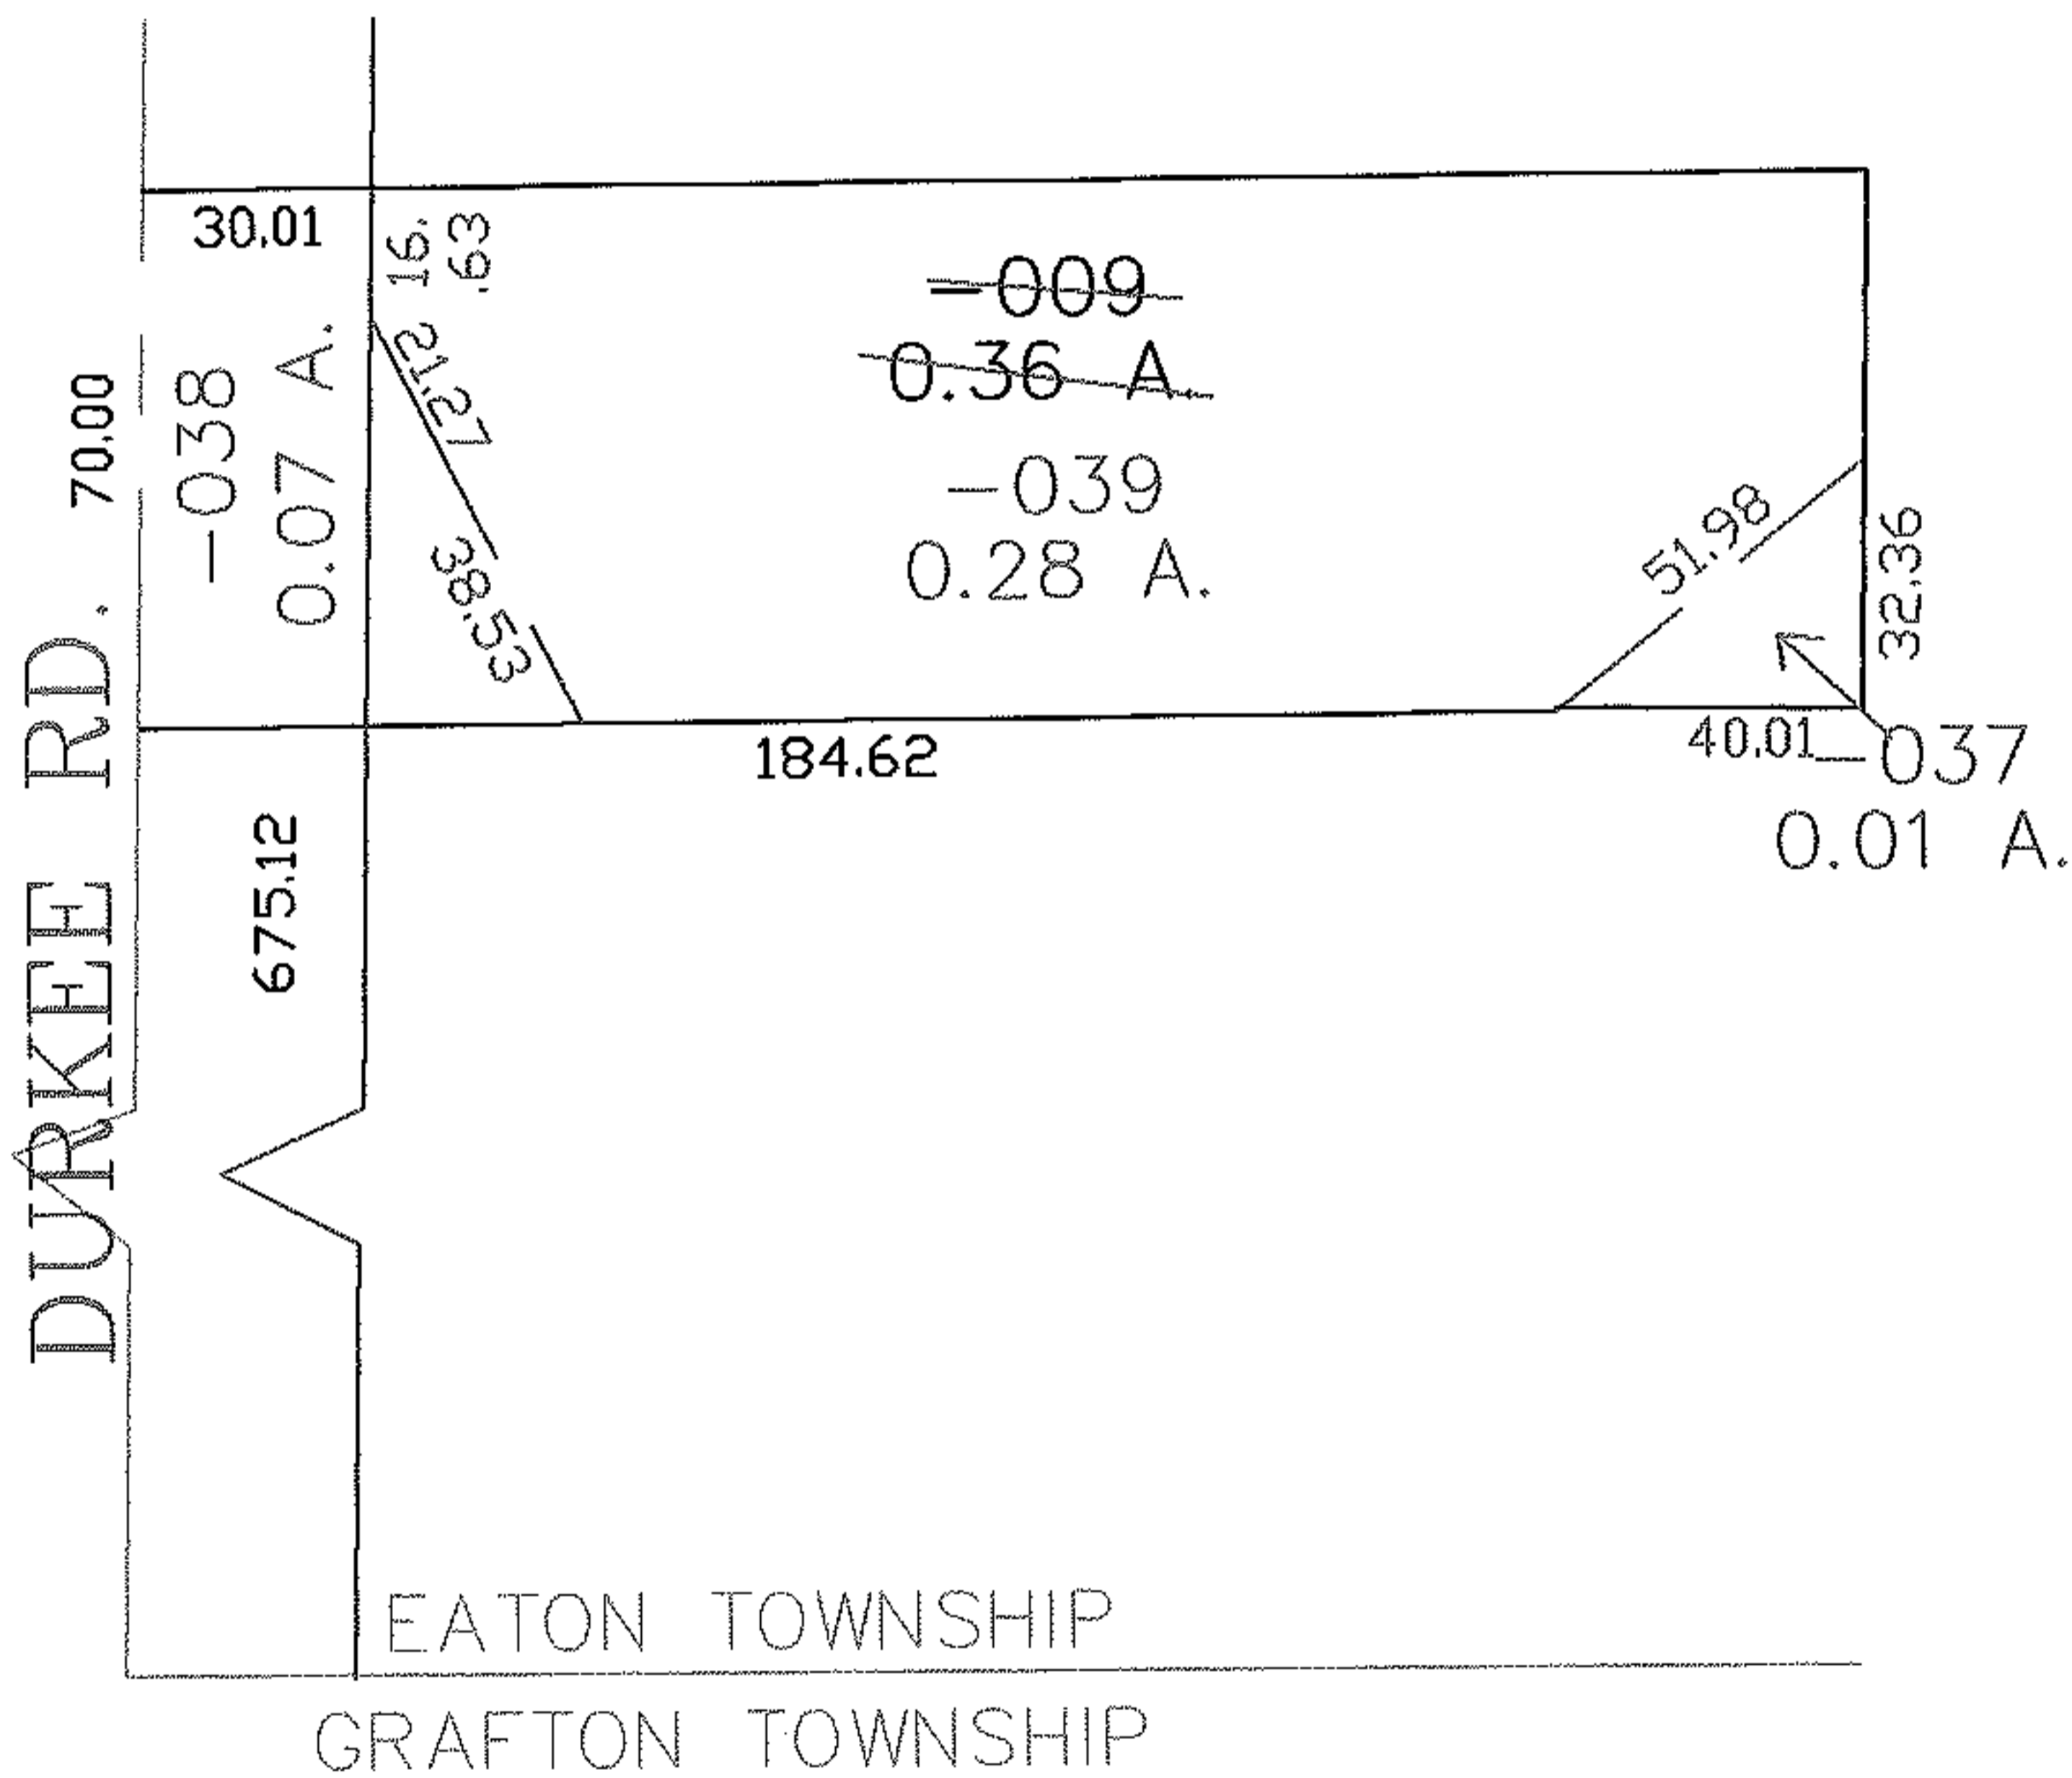


PARENT PARCEL: 11-00-080-000-009

CHILD PARCEL: 11-00-080-000-037 THRU -039

STARTING POINT: CENTERLINE OF DURKEE RD. & O.L. 80

NO. 00088

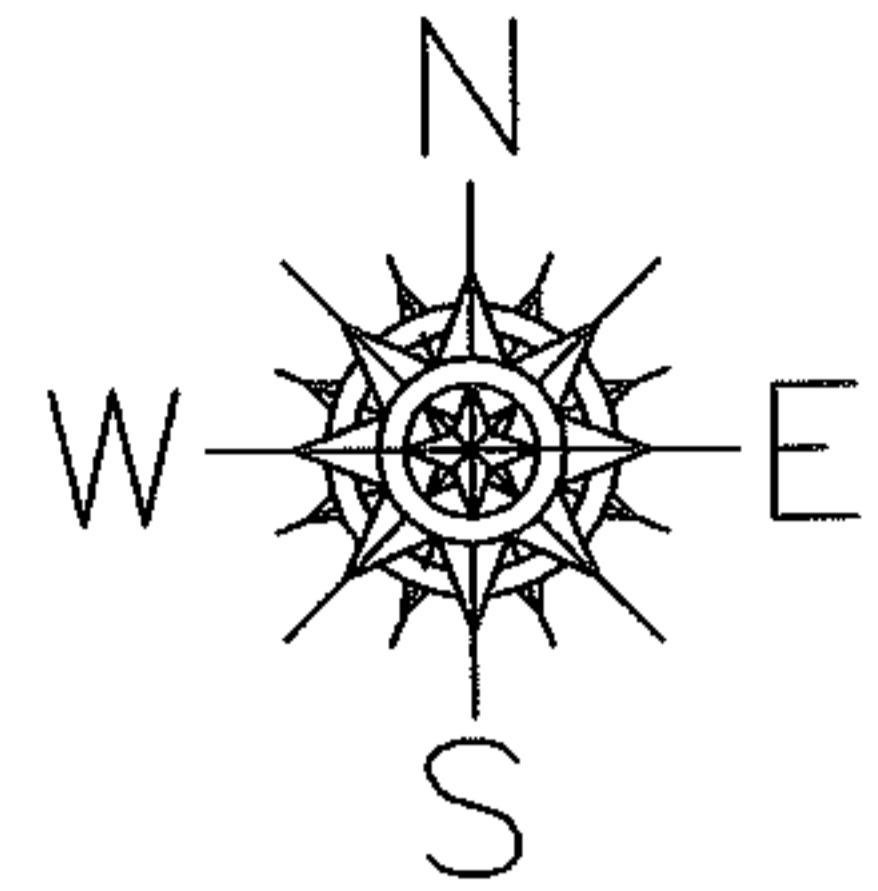

SPLITS/DEEDS PROCESSED

LORAIN COUNTY TAX MAP DEPARTMENT
226 MIDDLE AVE. ELYRIA, OHIO

SURVEYED BY: CHARLES P. UNTERREINER

CLOSURE: 0.00 : 10.000

MAP PAGE(S): 11-00-080-A

APPROVED BY: JAH DATE: 4-22-04

SCALE: 1" = 100' PRIOR INSTRUMENT: DV 1422/637