



PARENT PARCEL: 11-00-080-000-020  
CHILD PARCEL: 11-00-080-000-054 THRU -056  
STARTING POINT: CENTERLINE OF DURKEE RD. & O.L. 80

NO. 0009Z

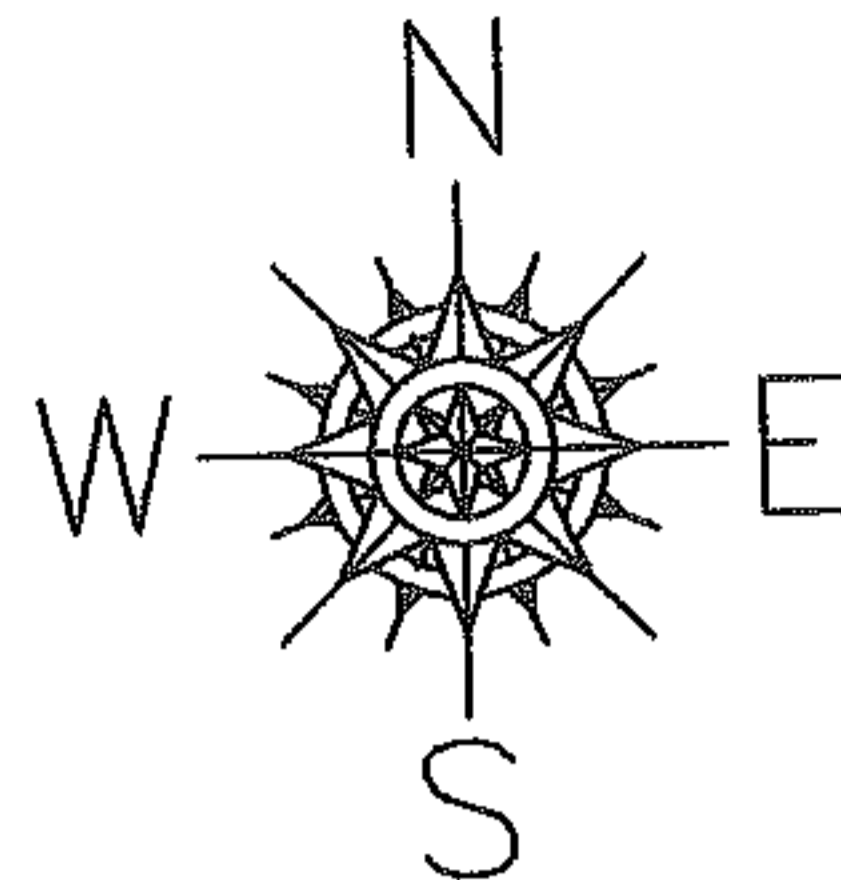

DURKEE RD.

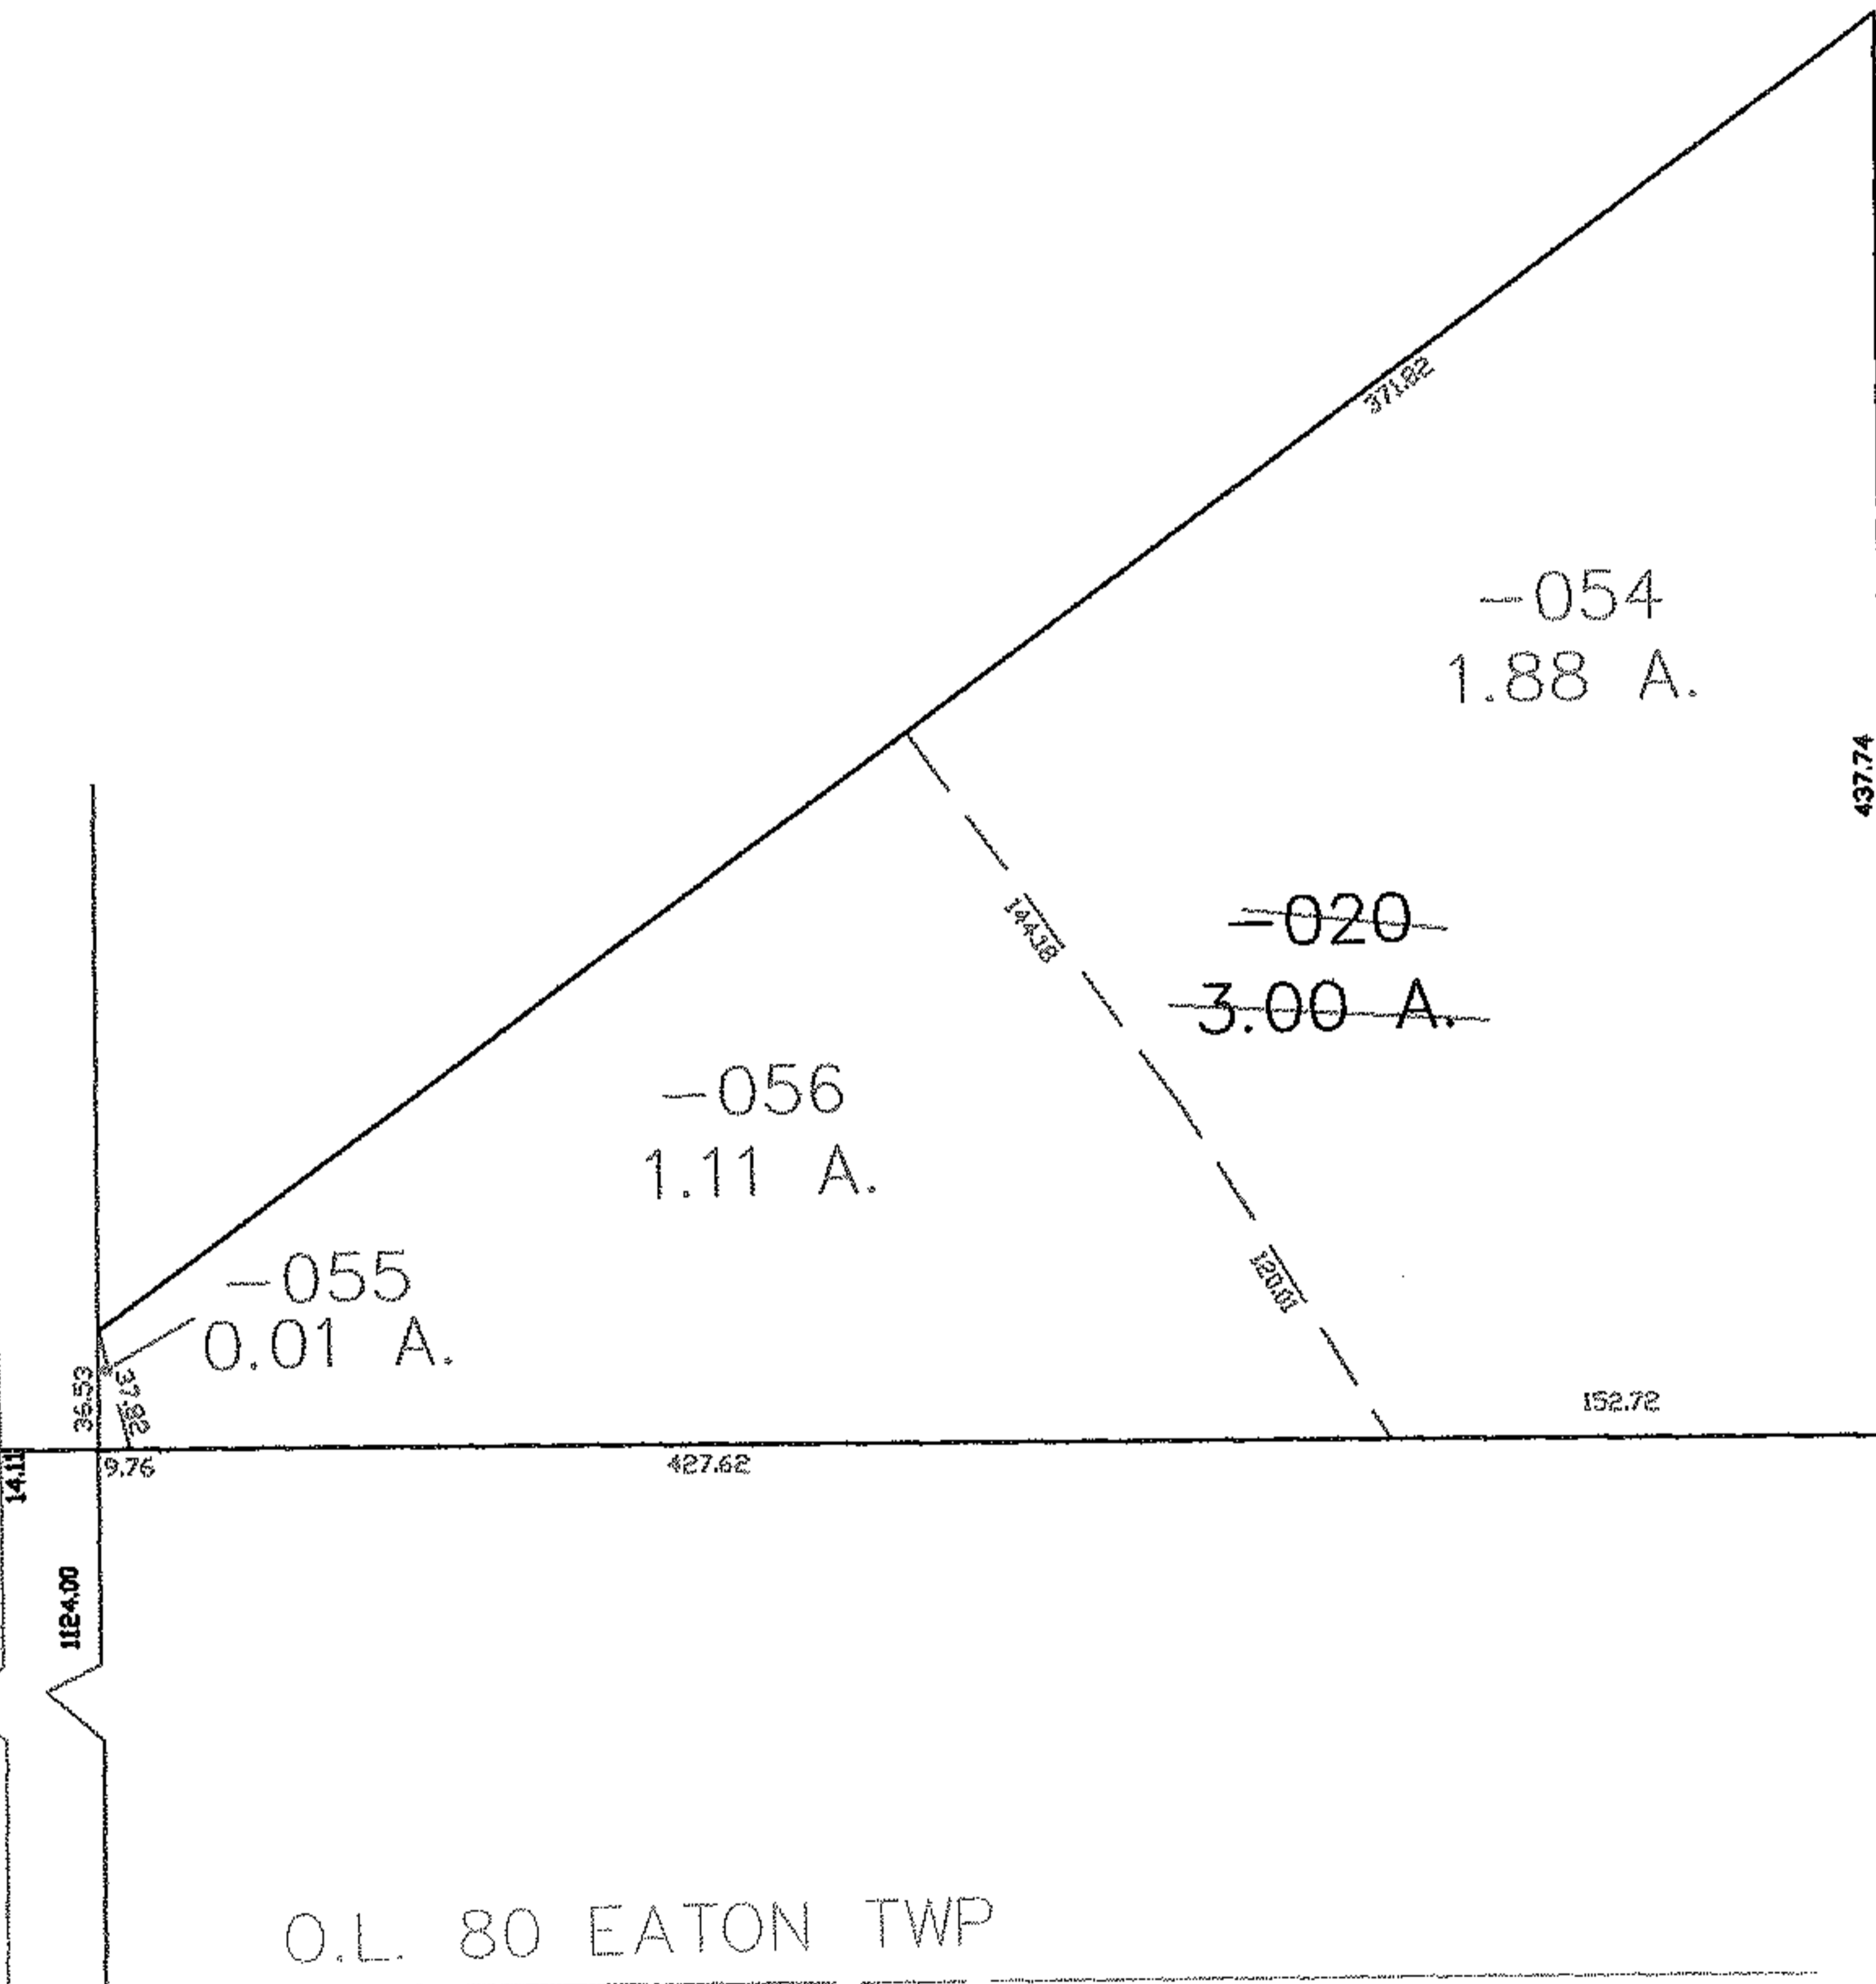

O.L. 80 EATON TWP  
O.L. 3 GRAFTON TWP.

SPLITS/DEEDS PROCESSED

LORAIN COUNTY TAX MAP DEPARTMENT  
226 MIDDLE AVE. ELYRIA, OHIO

SURVEYED BY: CHARLES P. UNTERREINER  
CLOSURE: 0.00 : 10.000  
MAP PAGE(S): 11-00-080-A  
APPROVED BY: JAH DATE: 11-19-04  
SCALE: 1" = 100 PRIOR INSTRUMENT: OR 1101/180