
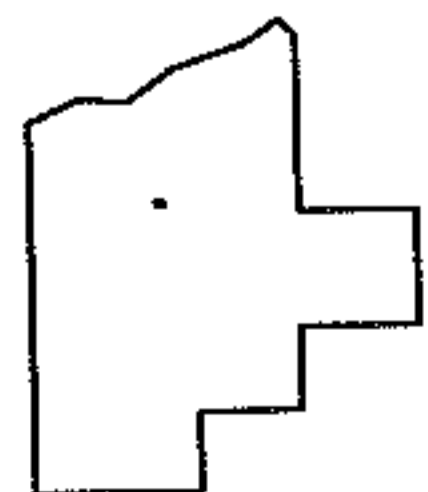
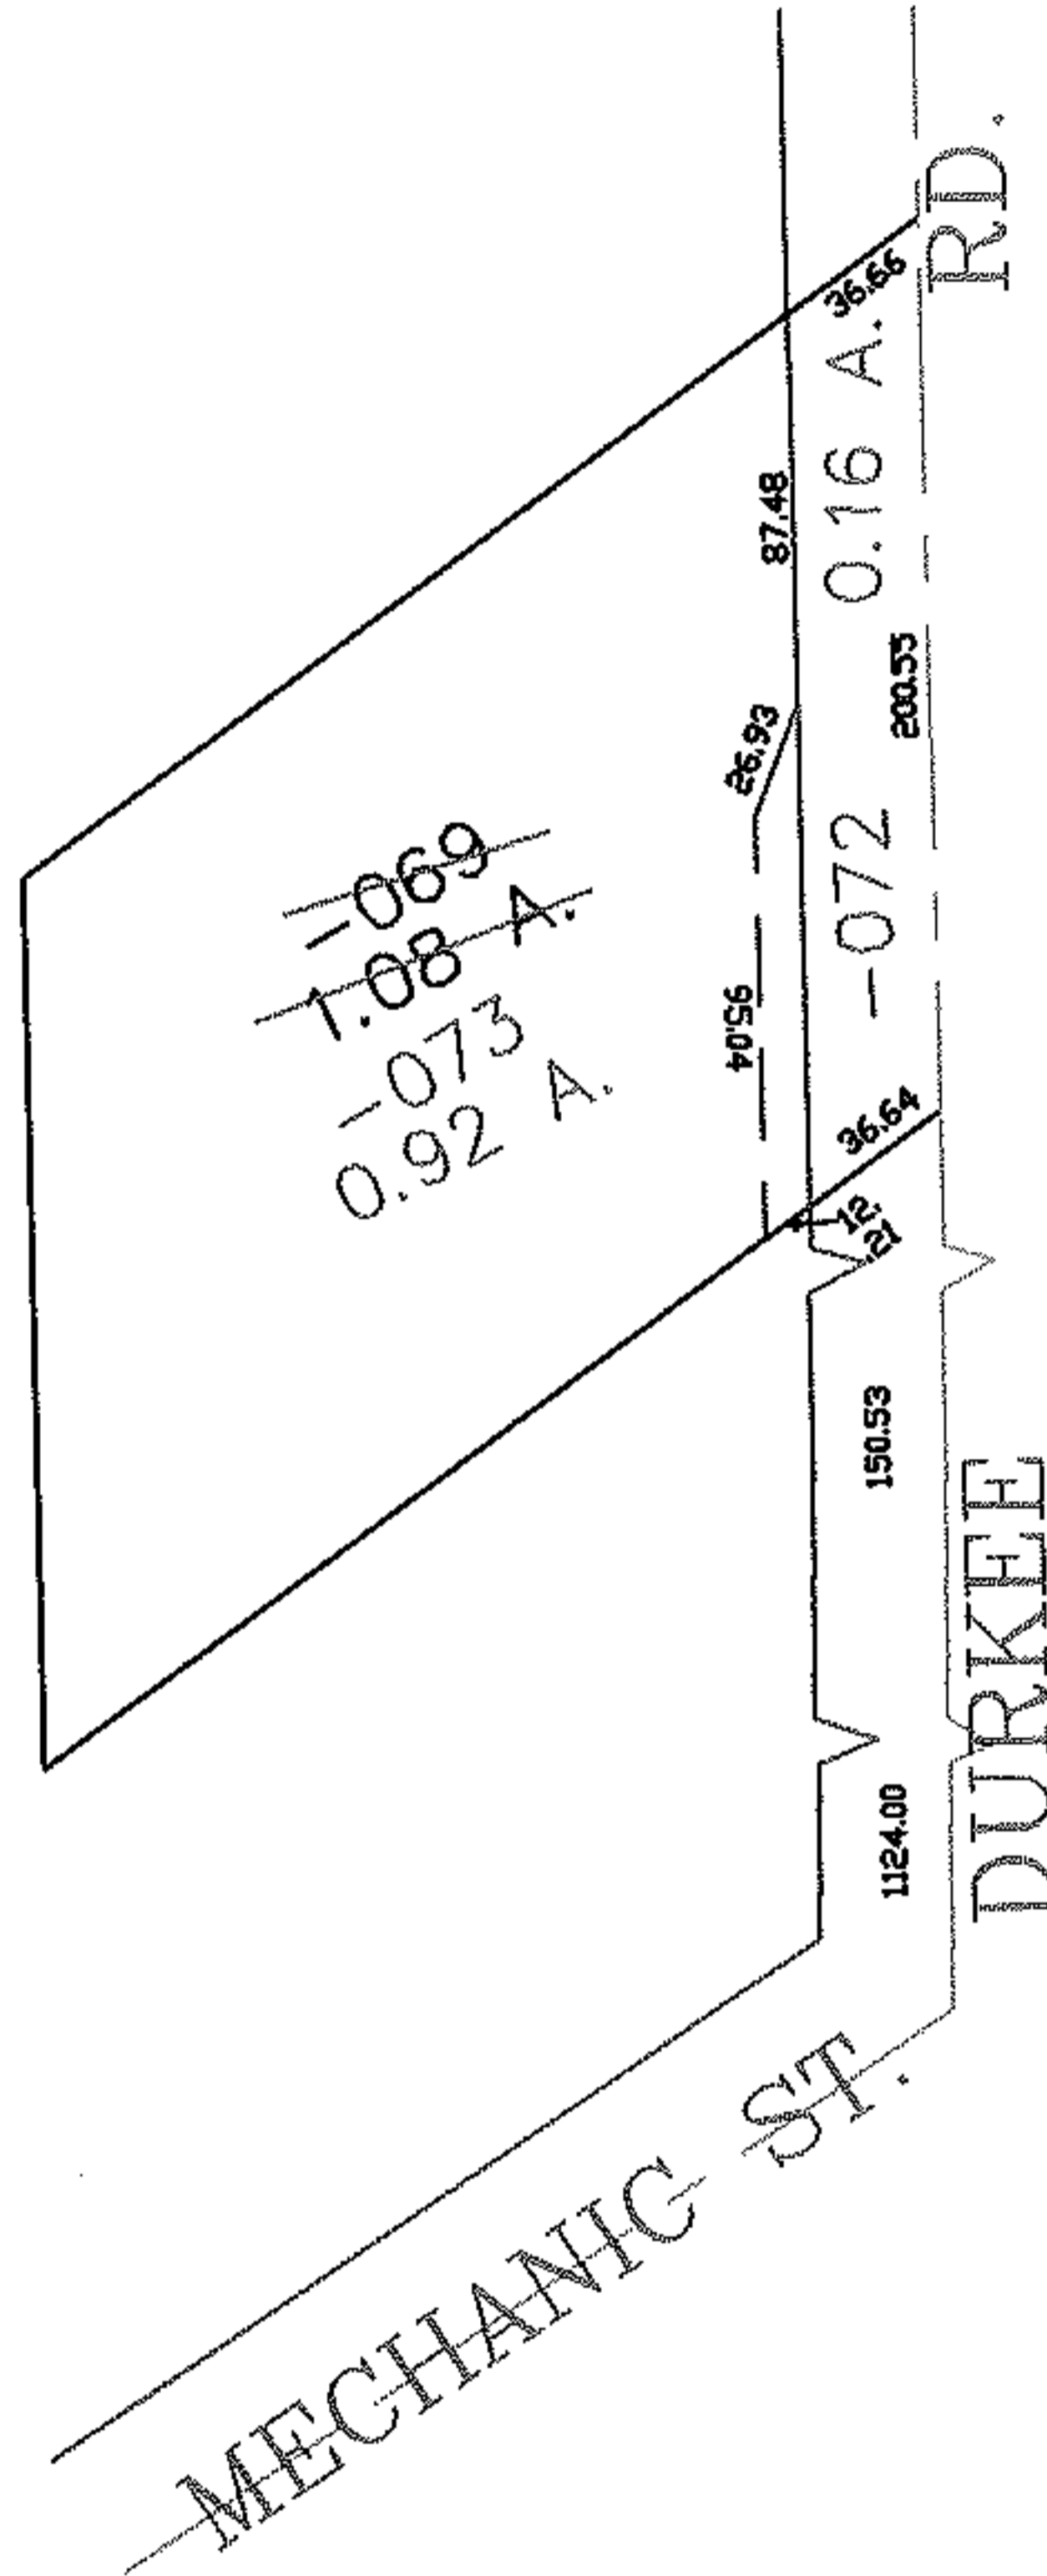


PARENT PARCEL: 11-00-081-102-069

CHILD PARCEL: 11-00-081-102-072, -073

STARTING POINT: CENTERLINE OF MECHANIC ST. & DURKEE RD.

NO. 00093

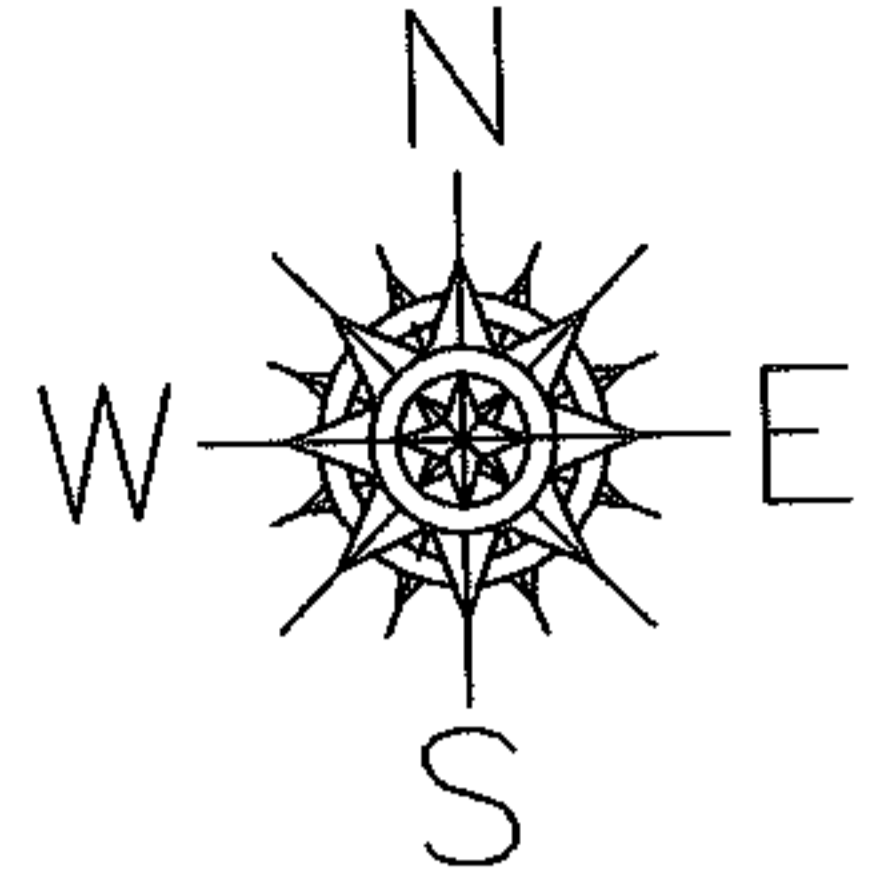

SPLITS/DEEDS PROCESSED

LORAIN COUNTY TAX MAP DEPARTMENT
226 MIDDLE AVE. ELYRIA, OHIO

SURVEYED BY: CHARLES P. UNTERREINER
 CLOSURE: 0.00 : 10.000
 MAP PAGE(S): 11-00-081
 APPROVED BY: JAH DATE: 4-27-04
 SCALE: 1" = 100 PRIOR INSTRUMENT: 20000693705