
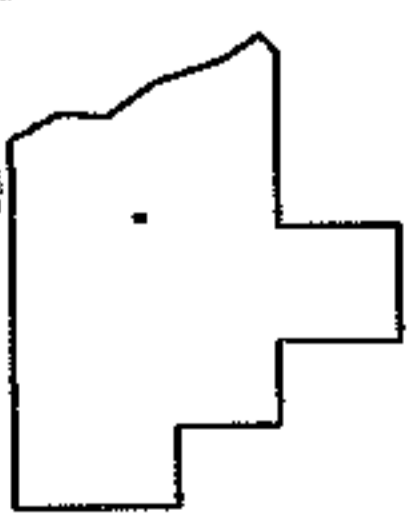
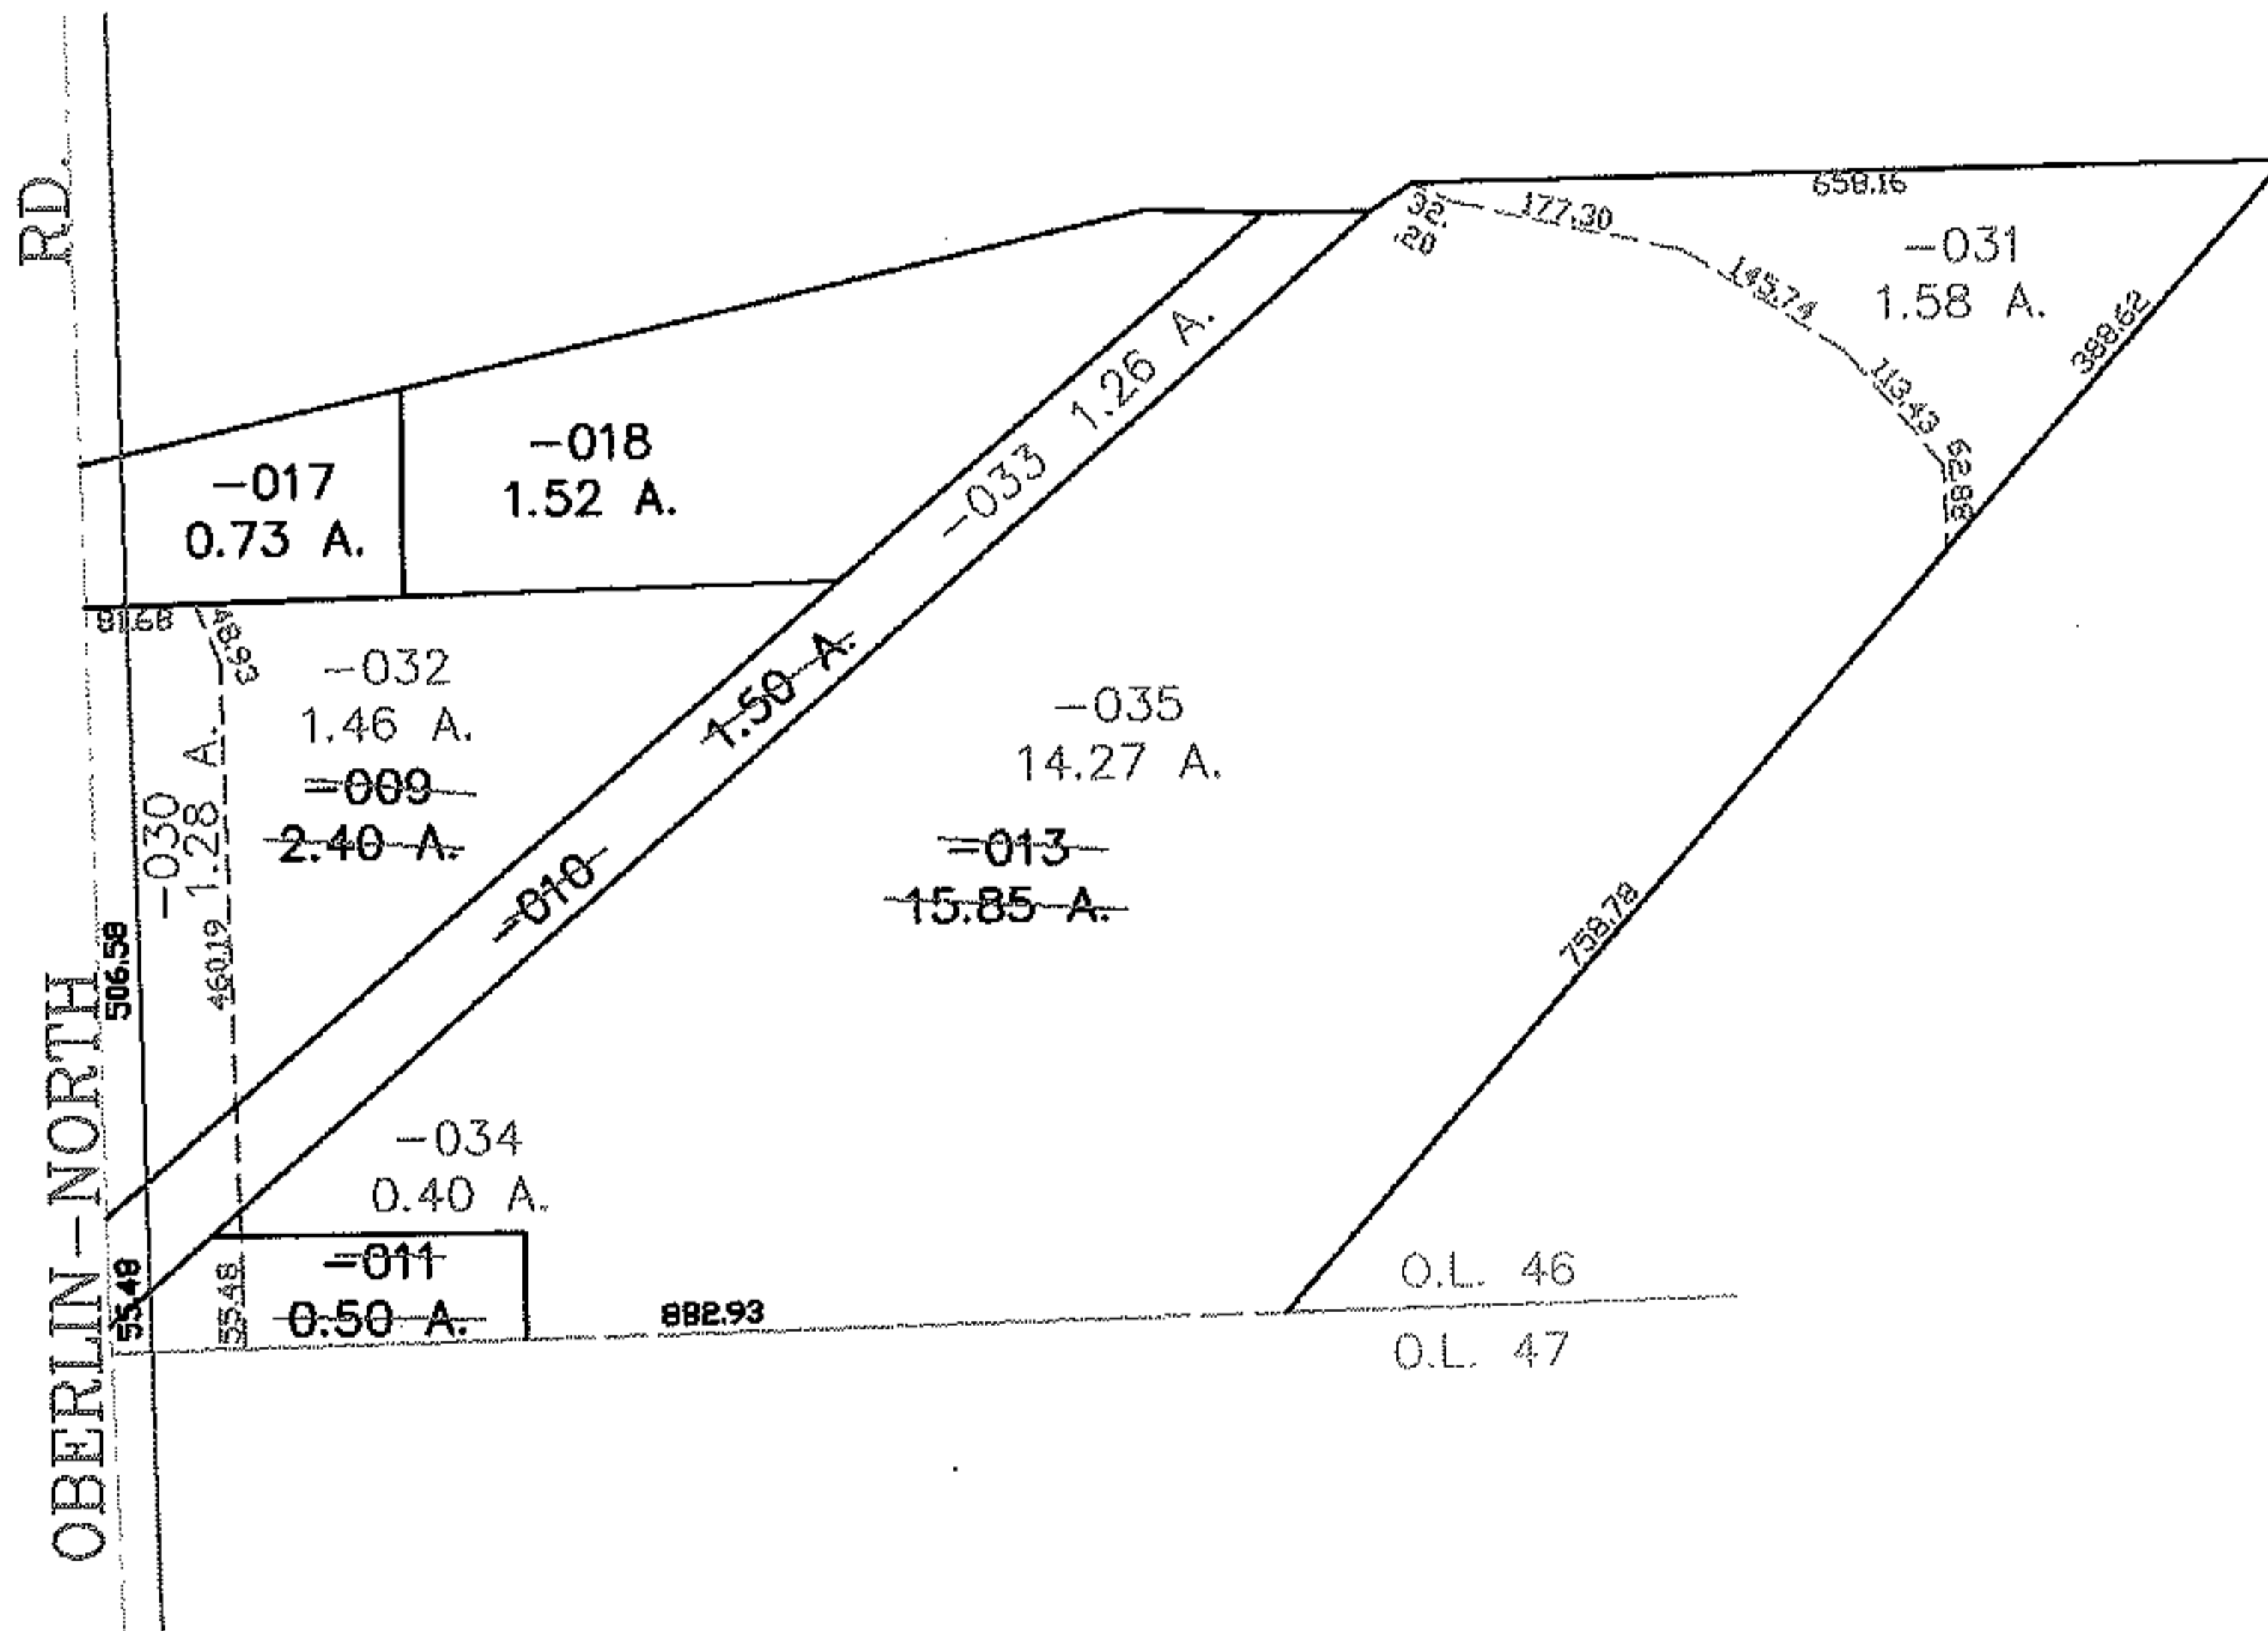


PARENT PARCEL: 05-00-046-000-013, -009, -010, -011
 CHILD PARCEL: 05-00-046-000-030 THRU -035
 STARTING POINT: CENTERLINE OF OBERLIN-NORTH RD. & O.L. 46

NO. 00097

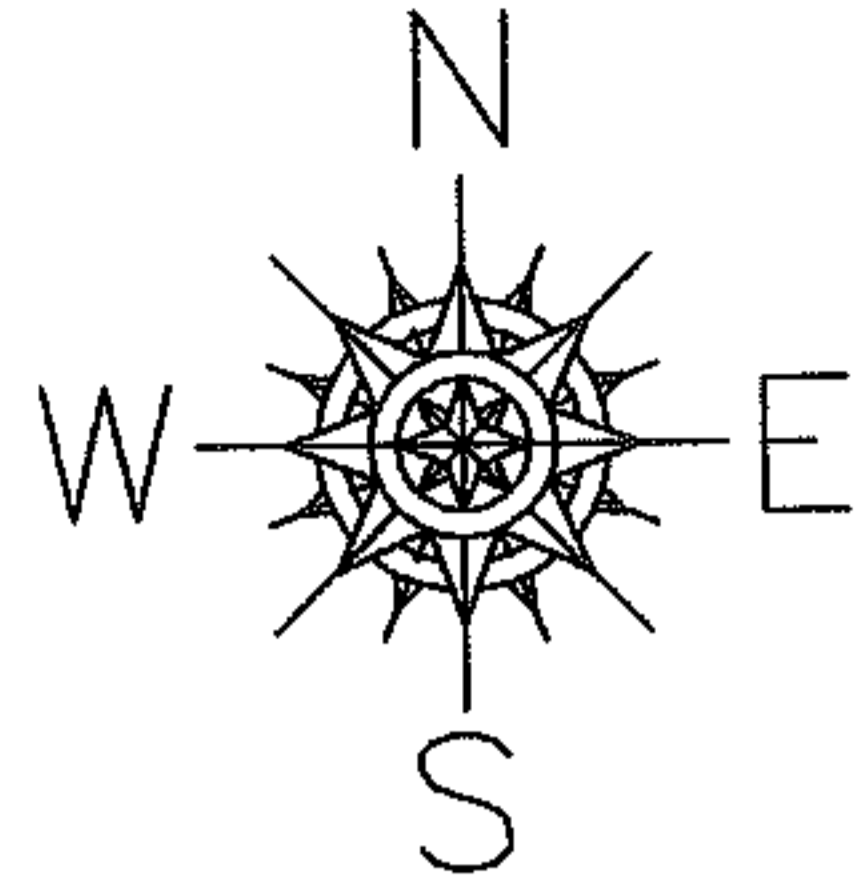

SPLITS/DEEDS PROCESSED
 LORAIN COUNTY TAX MAP DEPARTMENT
 226 MIDDLE AVE. ELYRIA, OHIO

SURVEYED BY: JOSEPH WILIN
 CLOSURE: 0.00 : 10.000
 MAP PAGE(S): 5-6
 APPROVED BY: JAH DATE: 10-18-04
 SCALE: 1" = 300' PRIOR INSTRUMENT: DV 758/801