
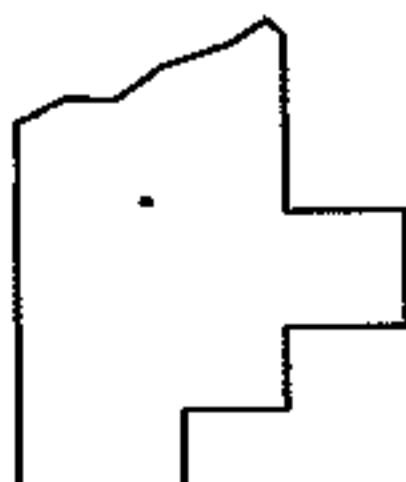
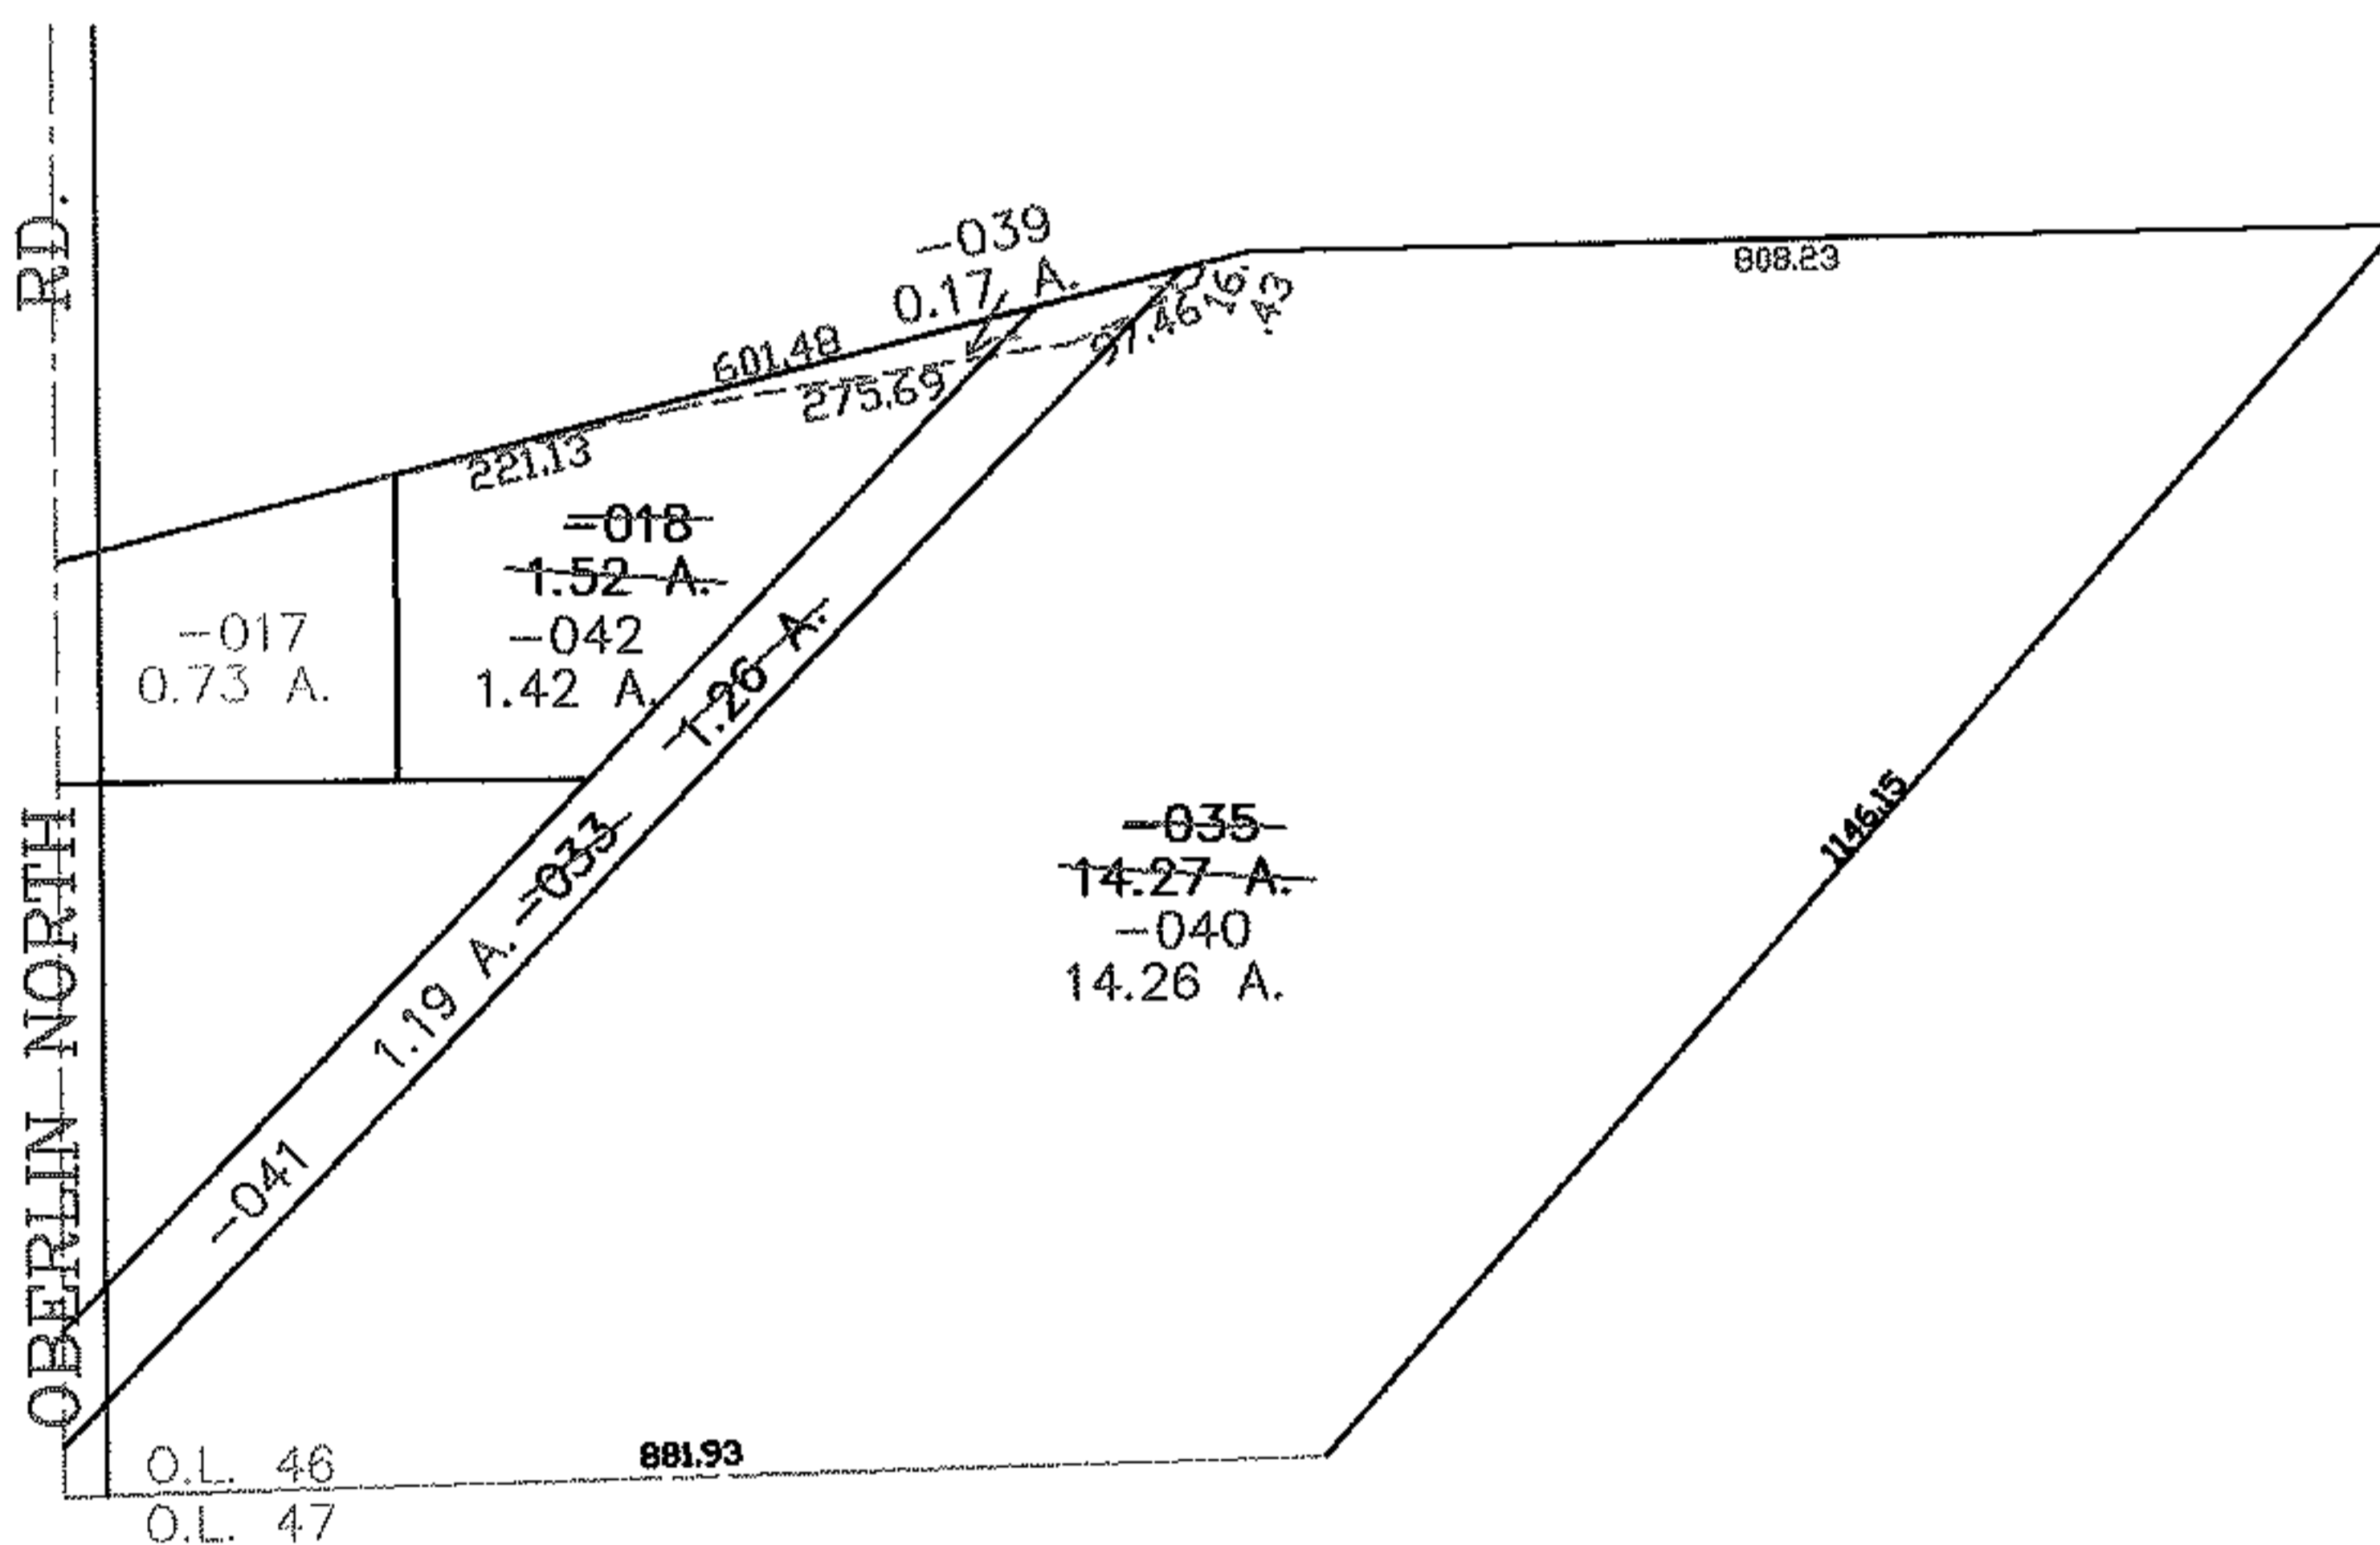


PARENT PARCEL: 05-00-046-000-018, -013, -010

CHILD PARCEL: 05-00-046-000-039 THRU -042

STARTING POINT: CENTERLINE OF OBERLIN NORTH RD. & O.L. 46

04-00098

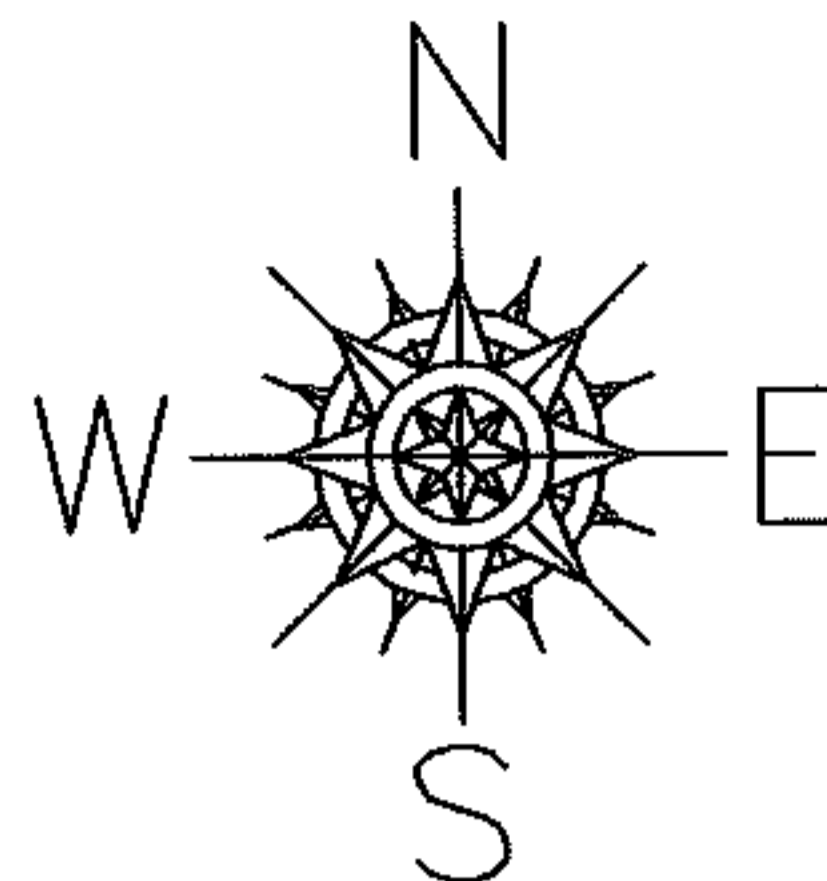

SPLITS/DEEDS PROCESSED
LORAIN COUNTY TAX MAP DEPARTMENT
226 MIDDLE AVE. ELYRIA, OHIO

SURVEYED BY: JOSEPH WILIN
 CLOSURE: 0.00 : 10,000
 MAP PAGE(S): 5-G
 APPROVED BY: JAH DATE: 11-7-05
 SCALE: 1" = 300' PRIOR INSTRUMENT: OR 1416/4