
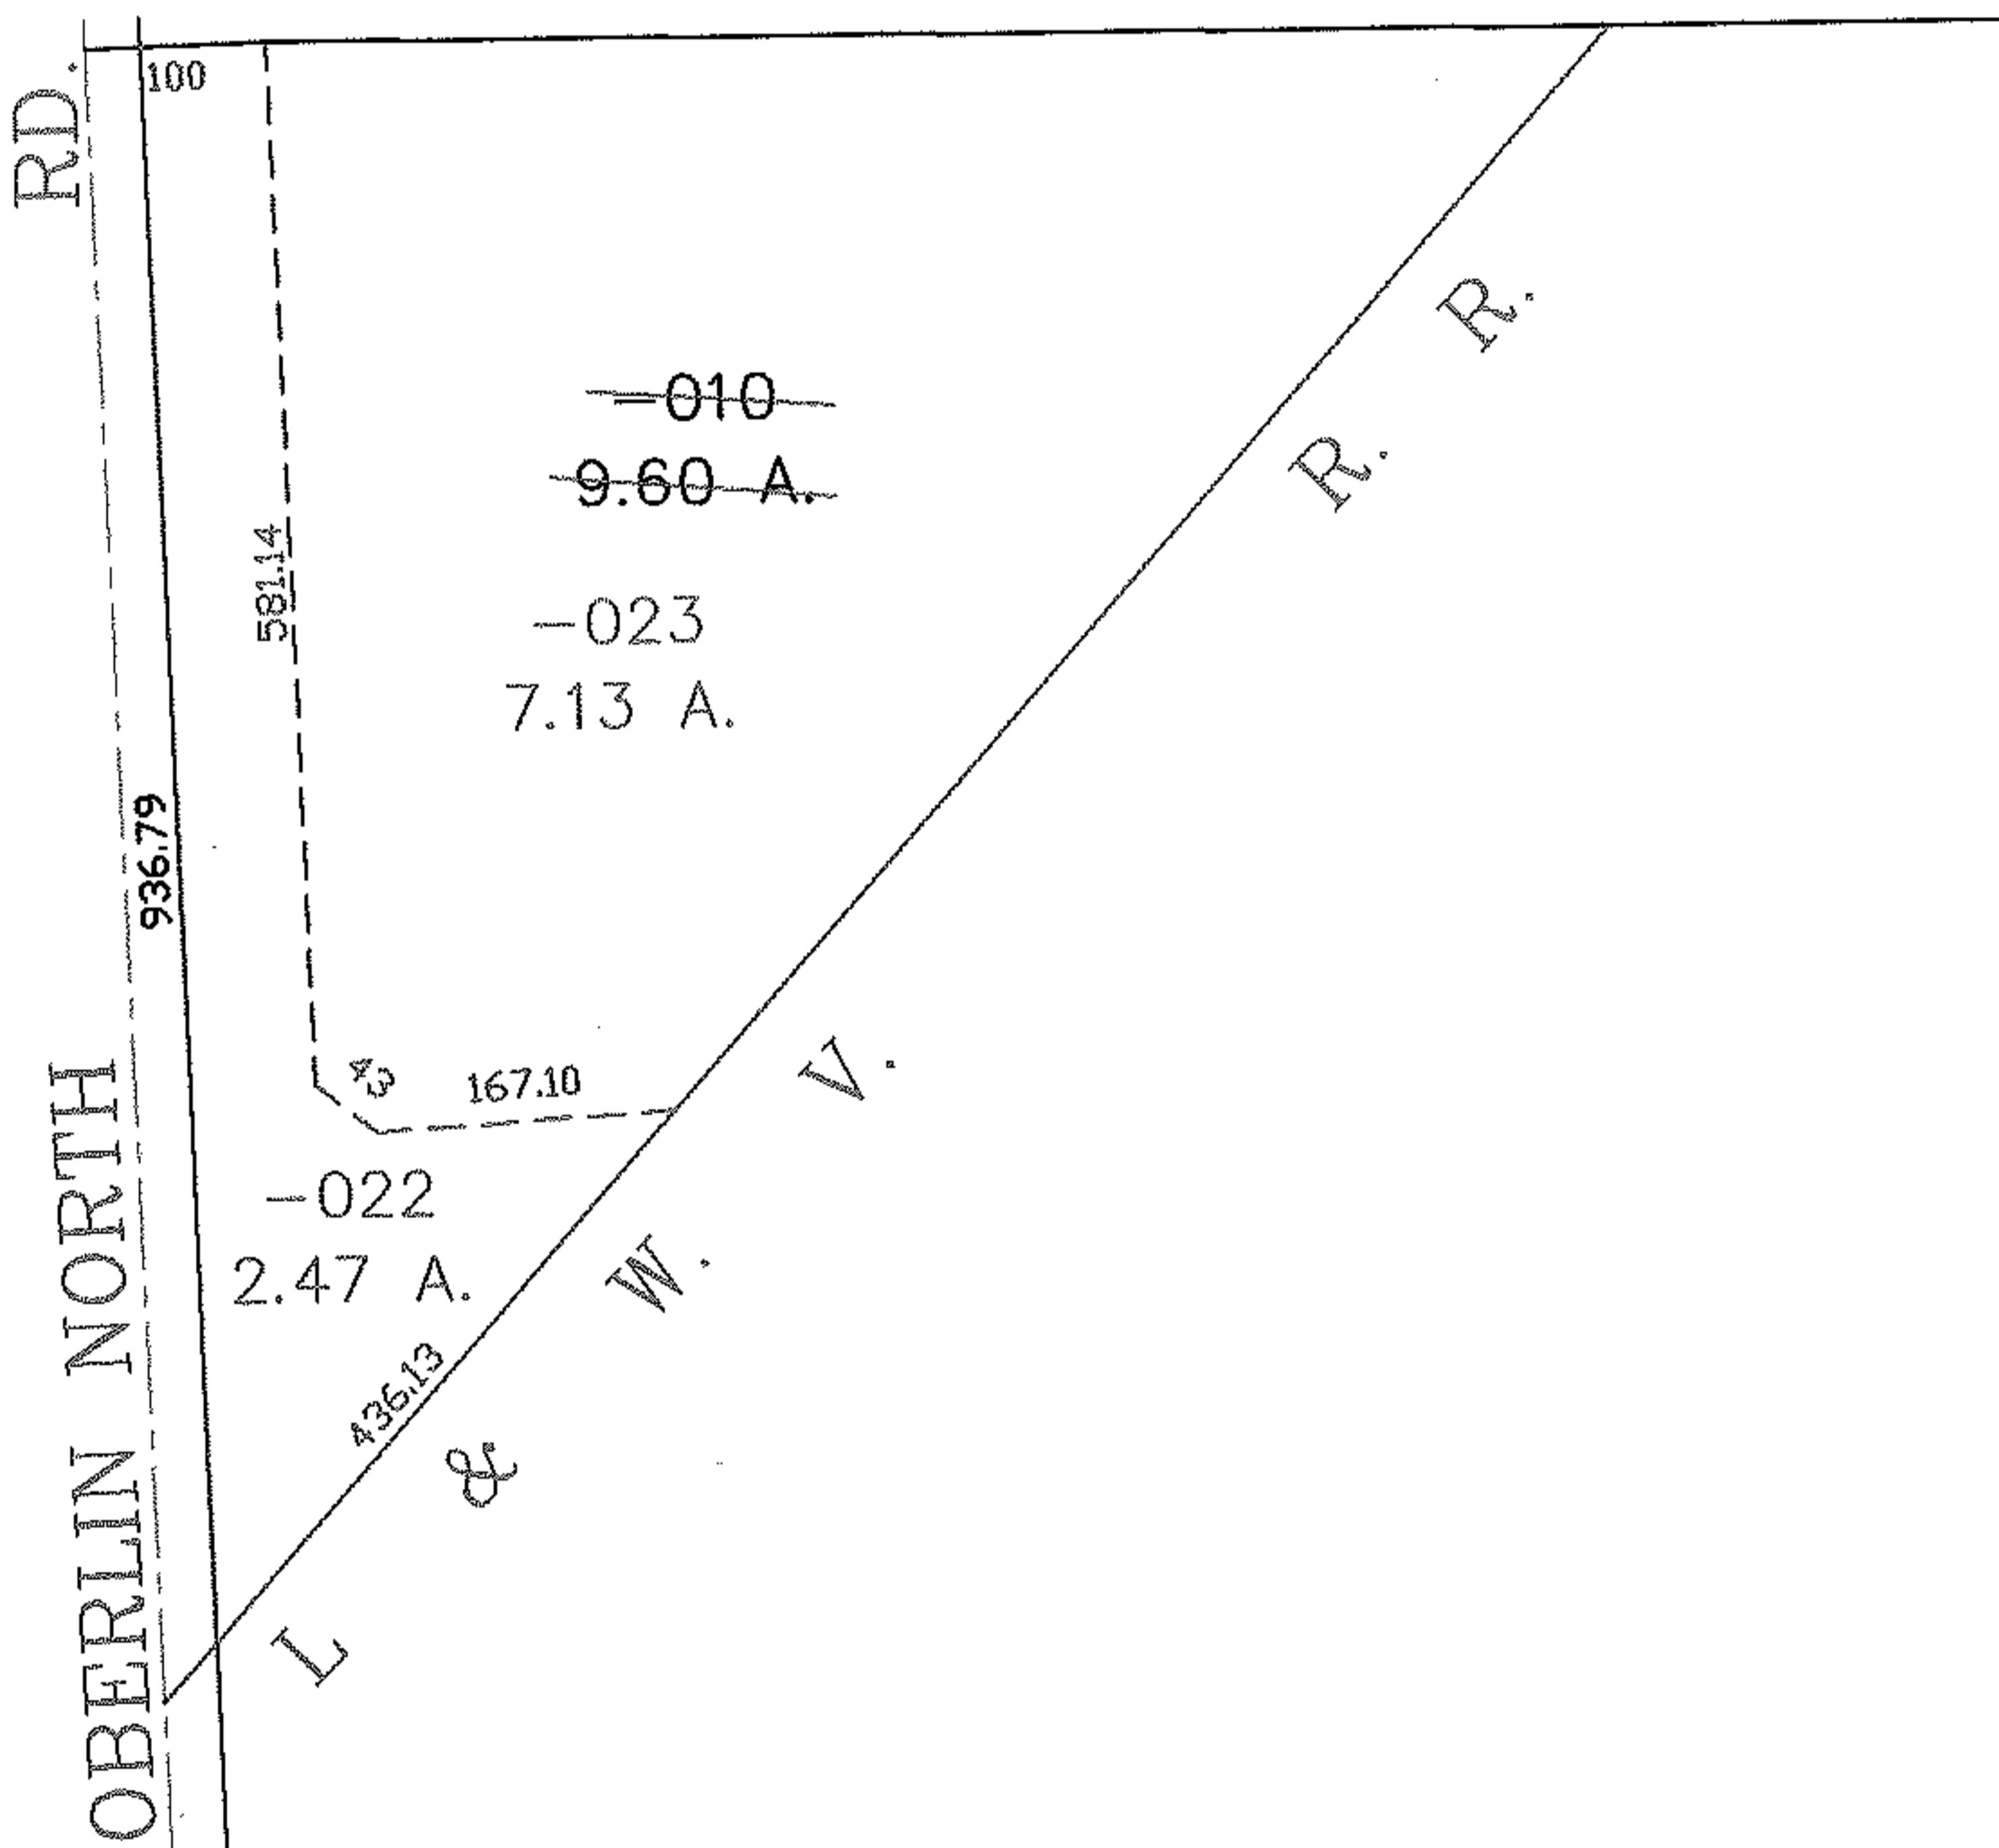


PARENT PARCEL: 05-00-047-000-010

CHILD PARCEL: 05-00-047-000-022, -023

STARTING POINT: CENTERLINE OF OBERLIN-NORTH RD. & O.L. 47

NO. 00099

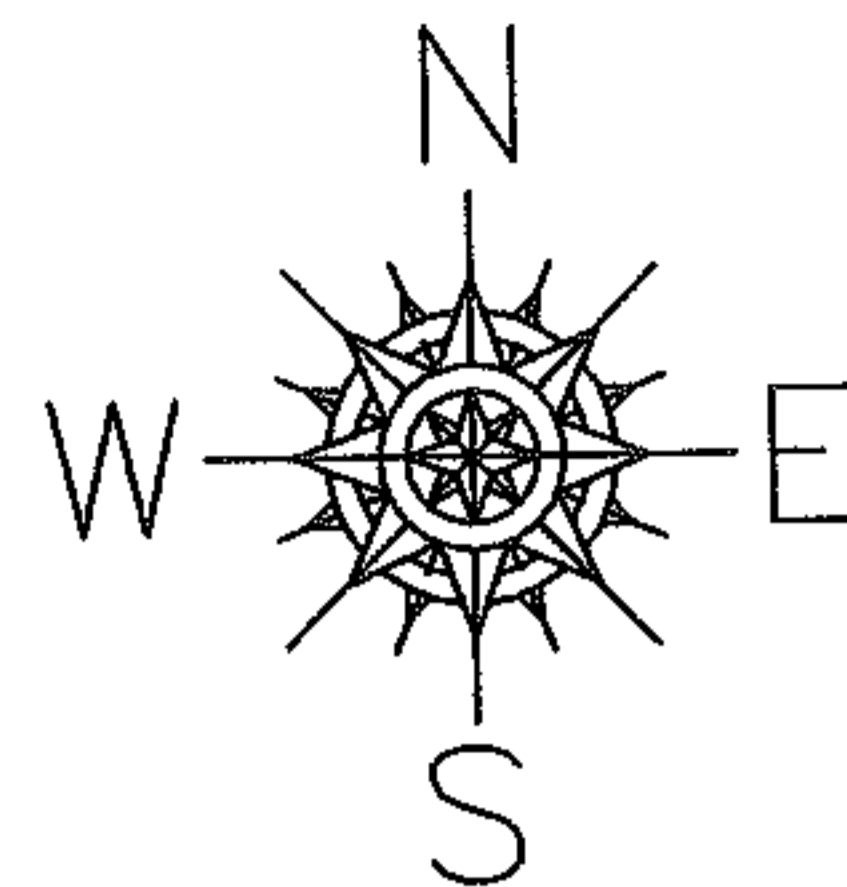

**SPLITS/DEEDS PROCESSED**  
 LORAIN COUNTY TAX MAP DEPARTMENT  
 226 MIDDLE AVE. ELYRIA, OHIO

SURVEYED BY: JOSEPH WILIN  
 CLOSURE: 0.00 : 10,000  
 MAP PAGE(S): 5-G  
 APPROVED BY: JAH DATE: 5-18-04  
 SCALE: 1" = 200' PRIOR INSTRUMENT: OR 1416/0001