
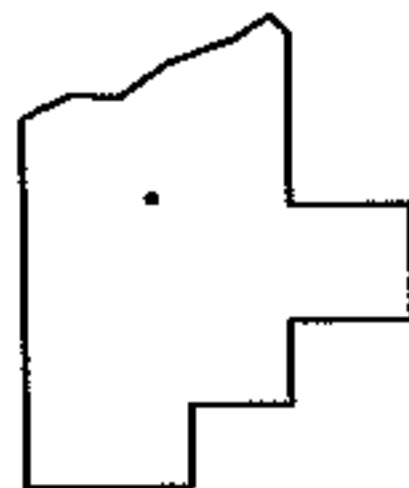
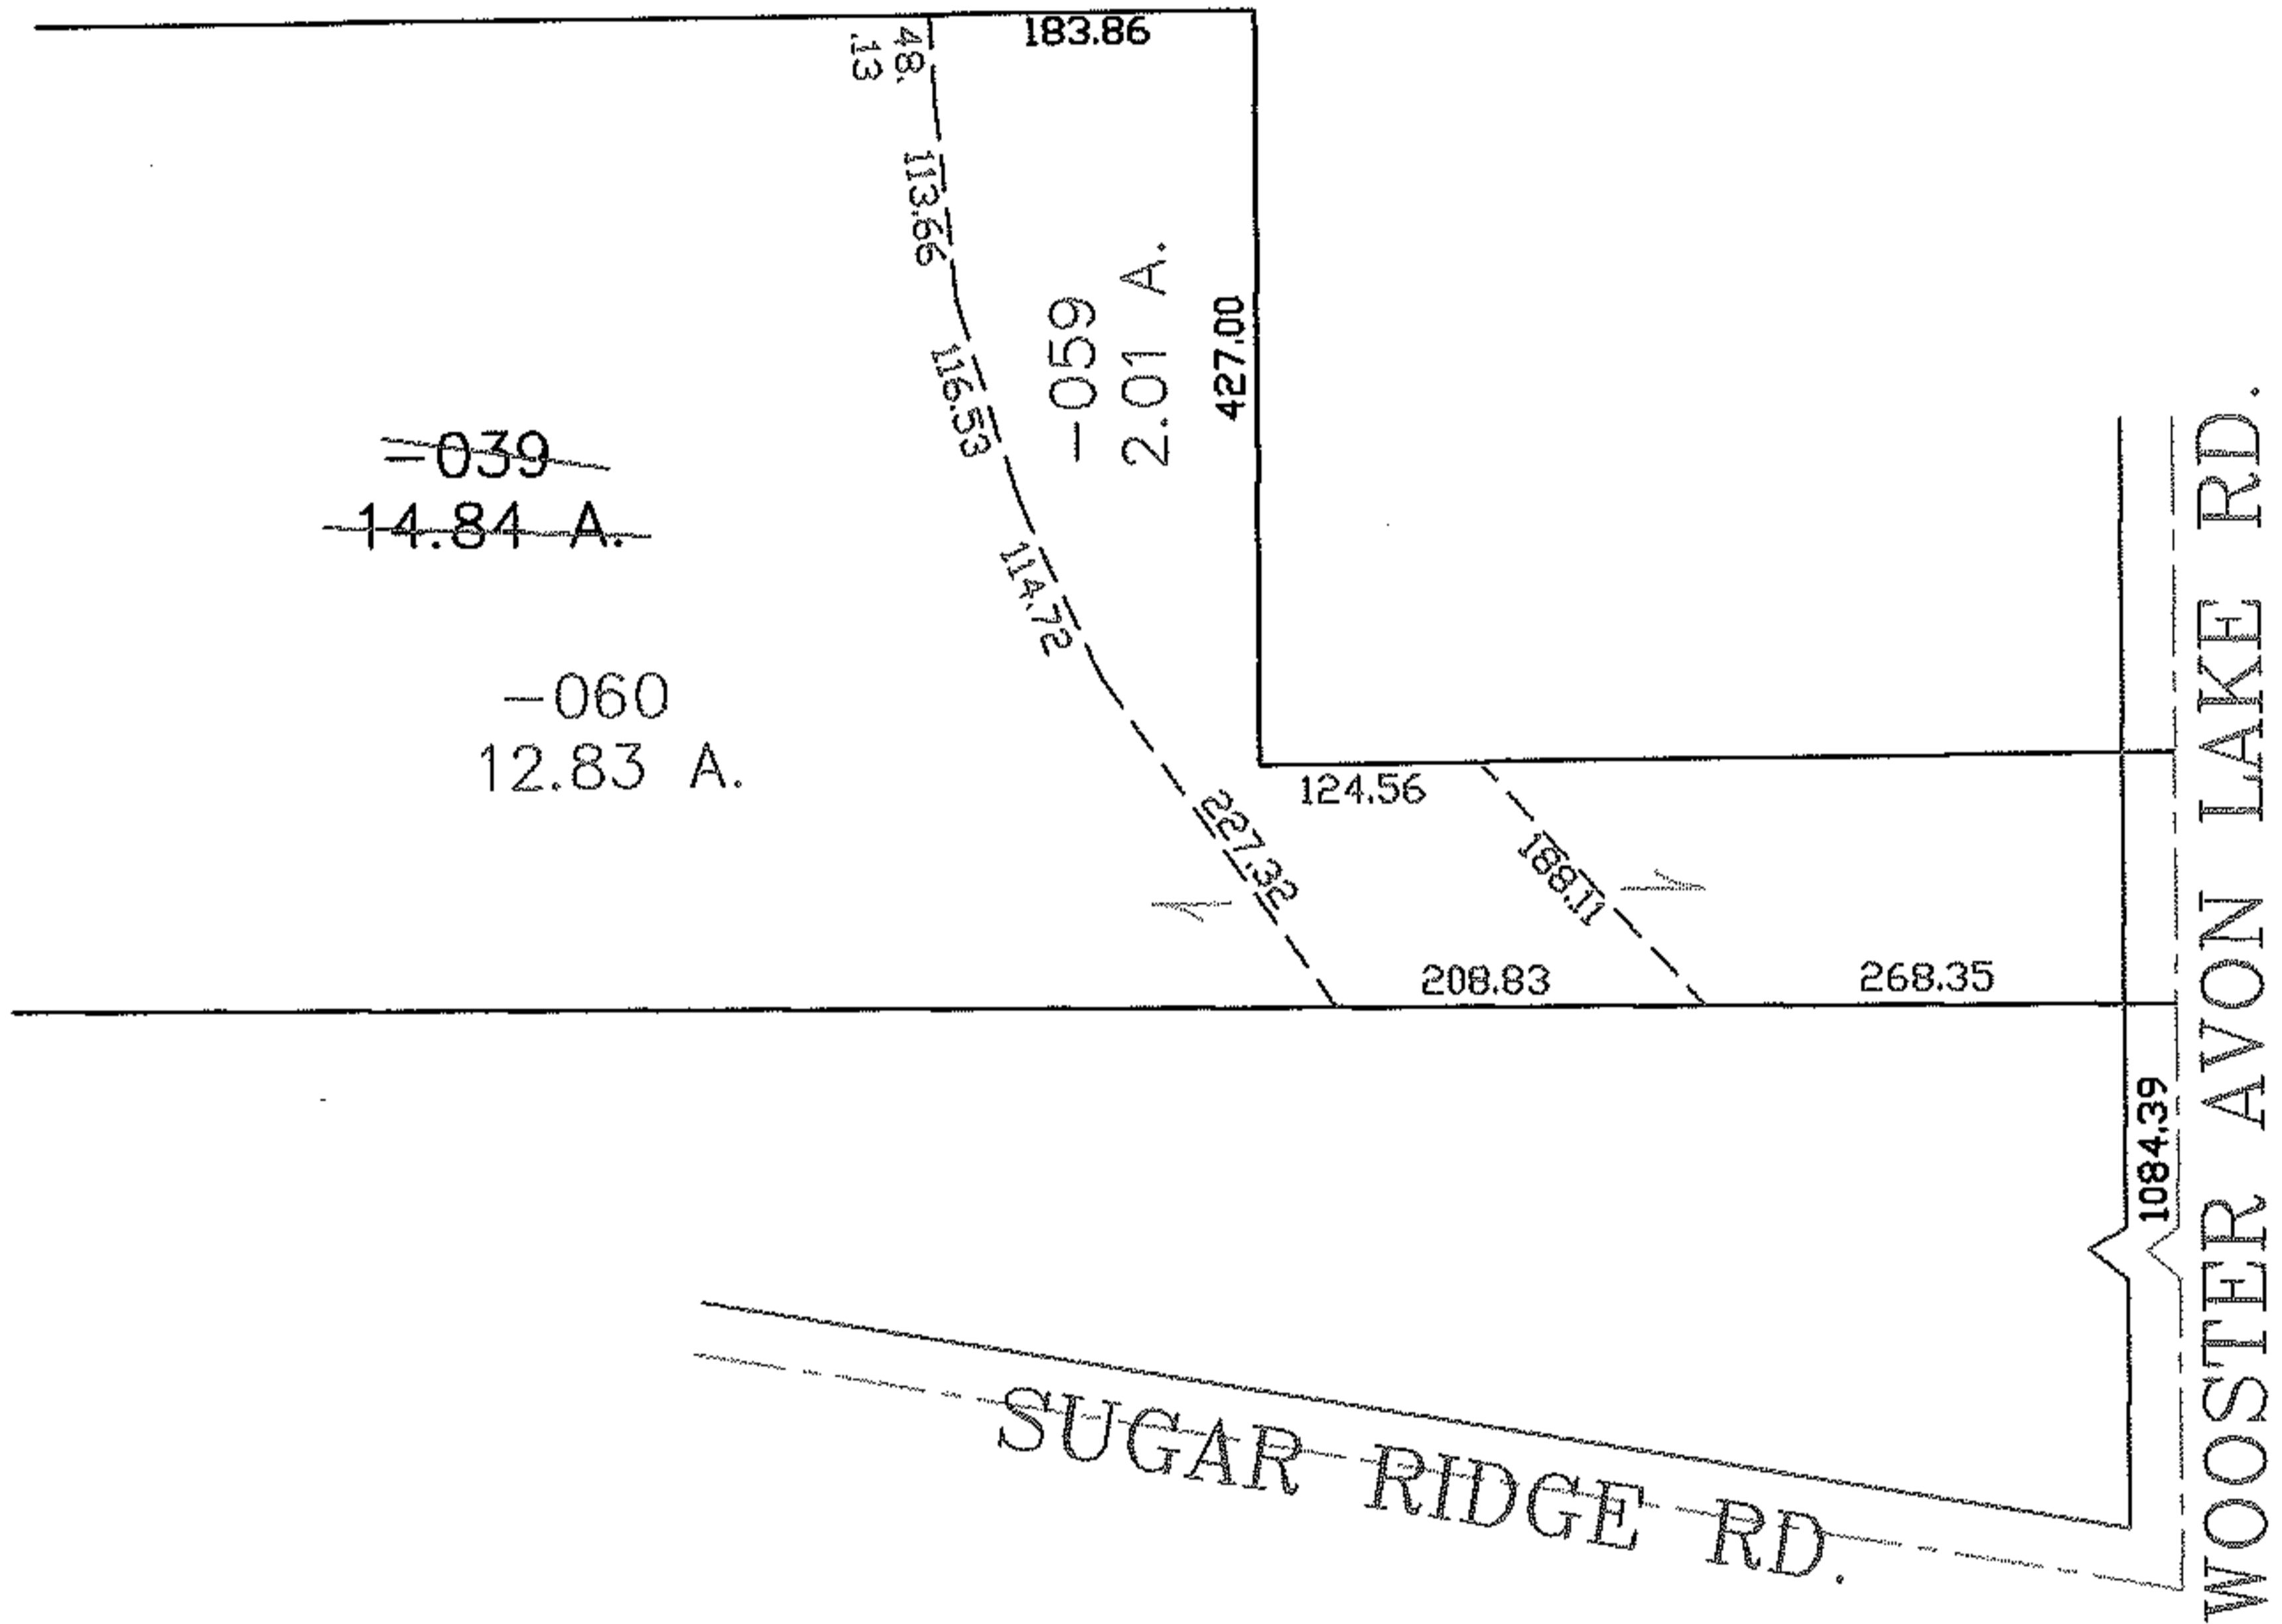


PARENT PARCEL: 07-00-026-101-039

CHILD PARCEL: 07-00-026-101-059, -060

STARTING POINT: CENTERLINE OF SUGAR RIDGE RD. & WOOSTER AVON LAKE RD.

NO. 00101

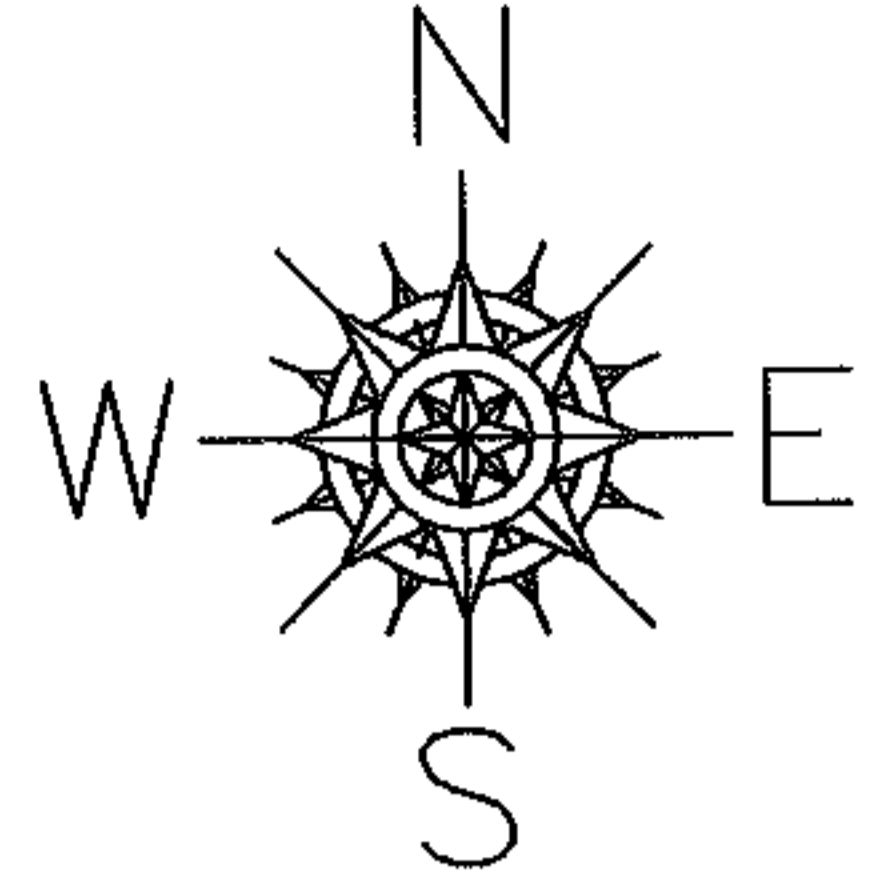

SPLITS/DEEDS PROCESSED
 LORAIN COUNTY TAX MAP DEPARTMENT
 226 MIDDLE AVE. ELYRIA, OHIO

SURVEYED BY: ROBERT J. MCAULEY
 CLOSURE: 0.00 : 10.000
 MAP PAGE(S): 07-00-026-B
 APPROVED BY: JAH DATE: 4-29-04
 SCALE: 1" = 200' PRIOR INSTRUMENT: DV 1370/340