
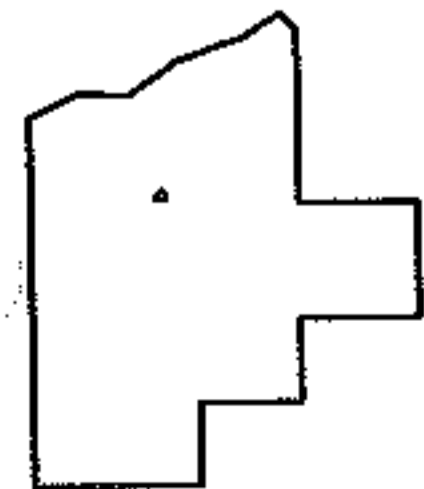
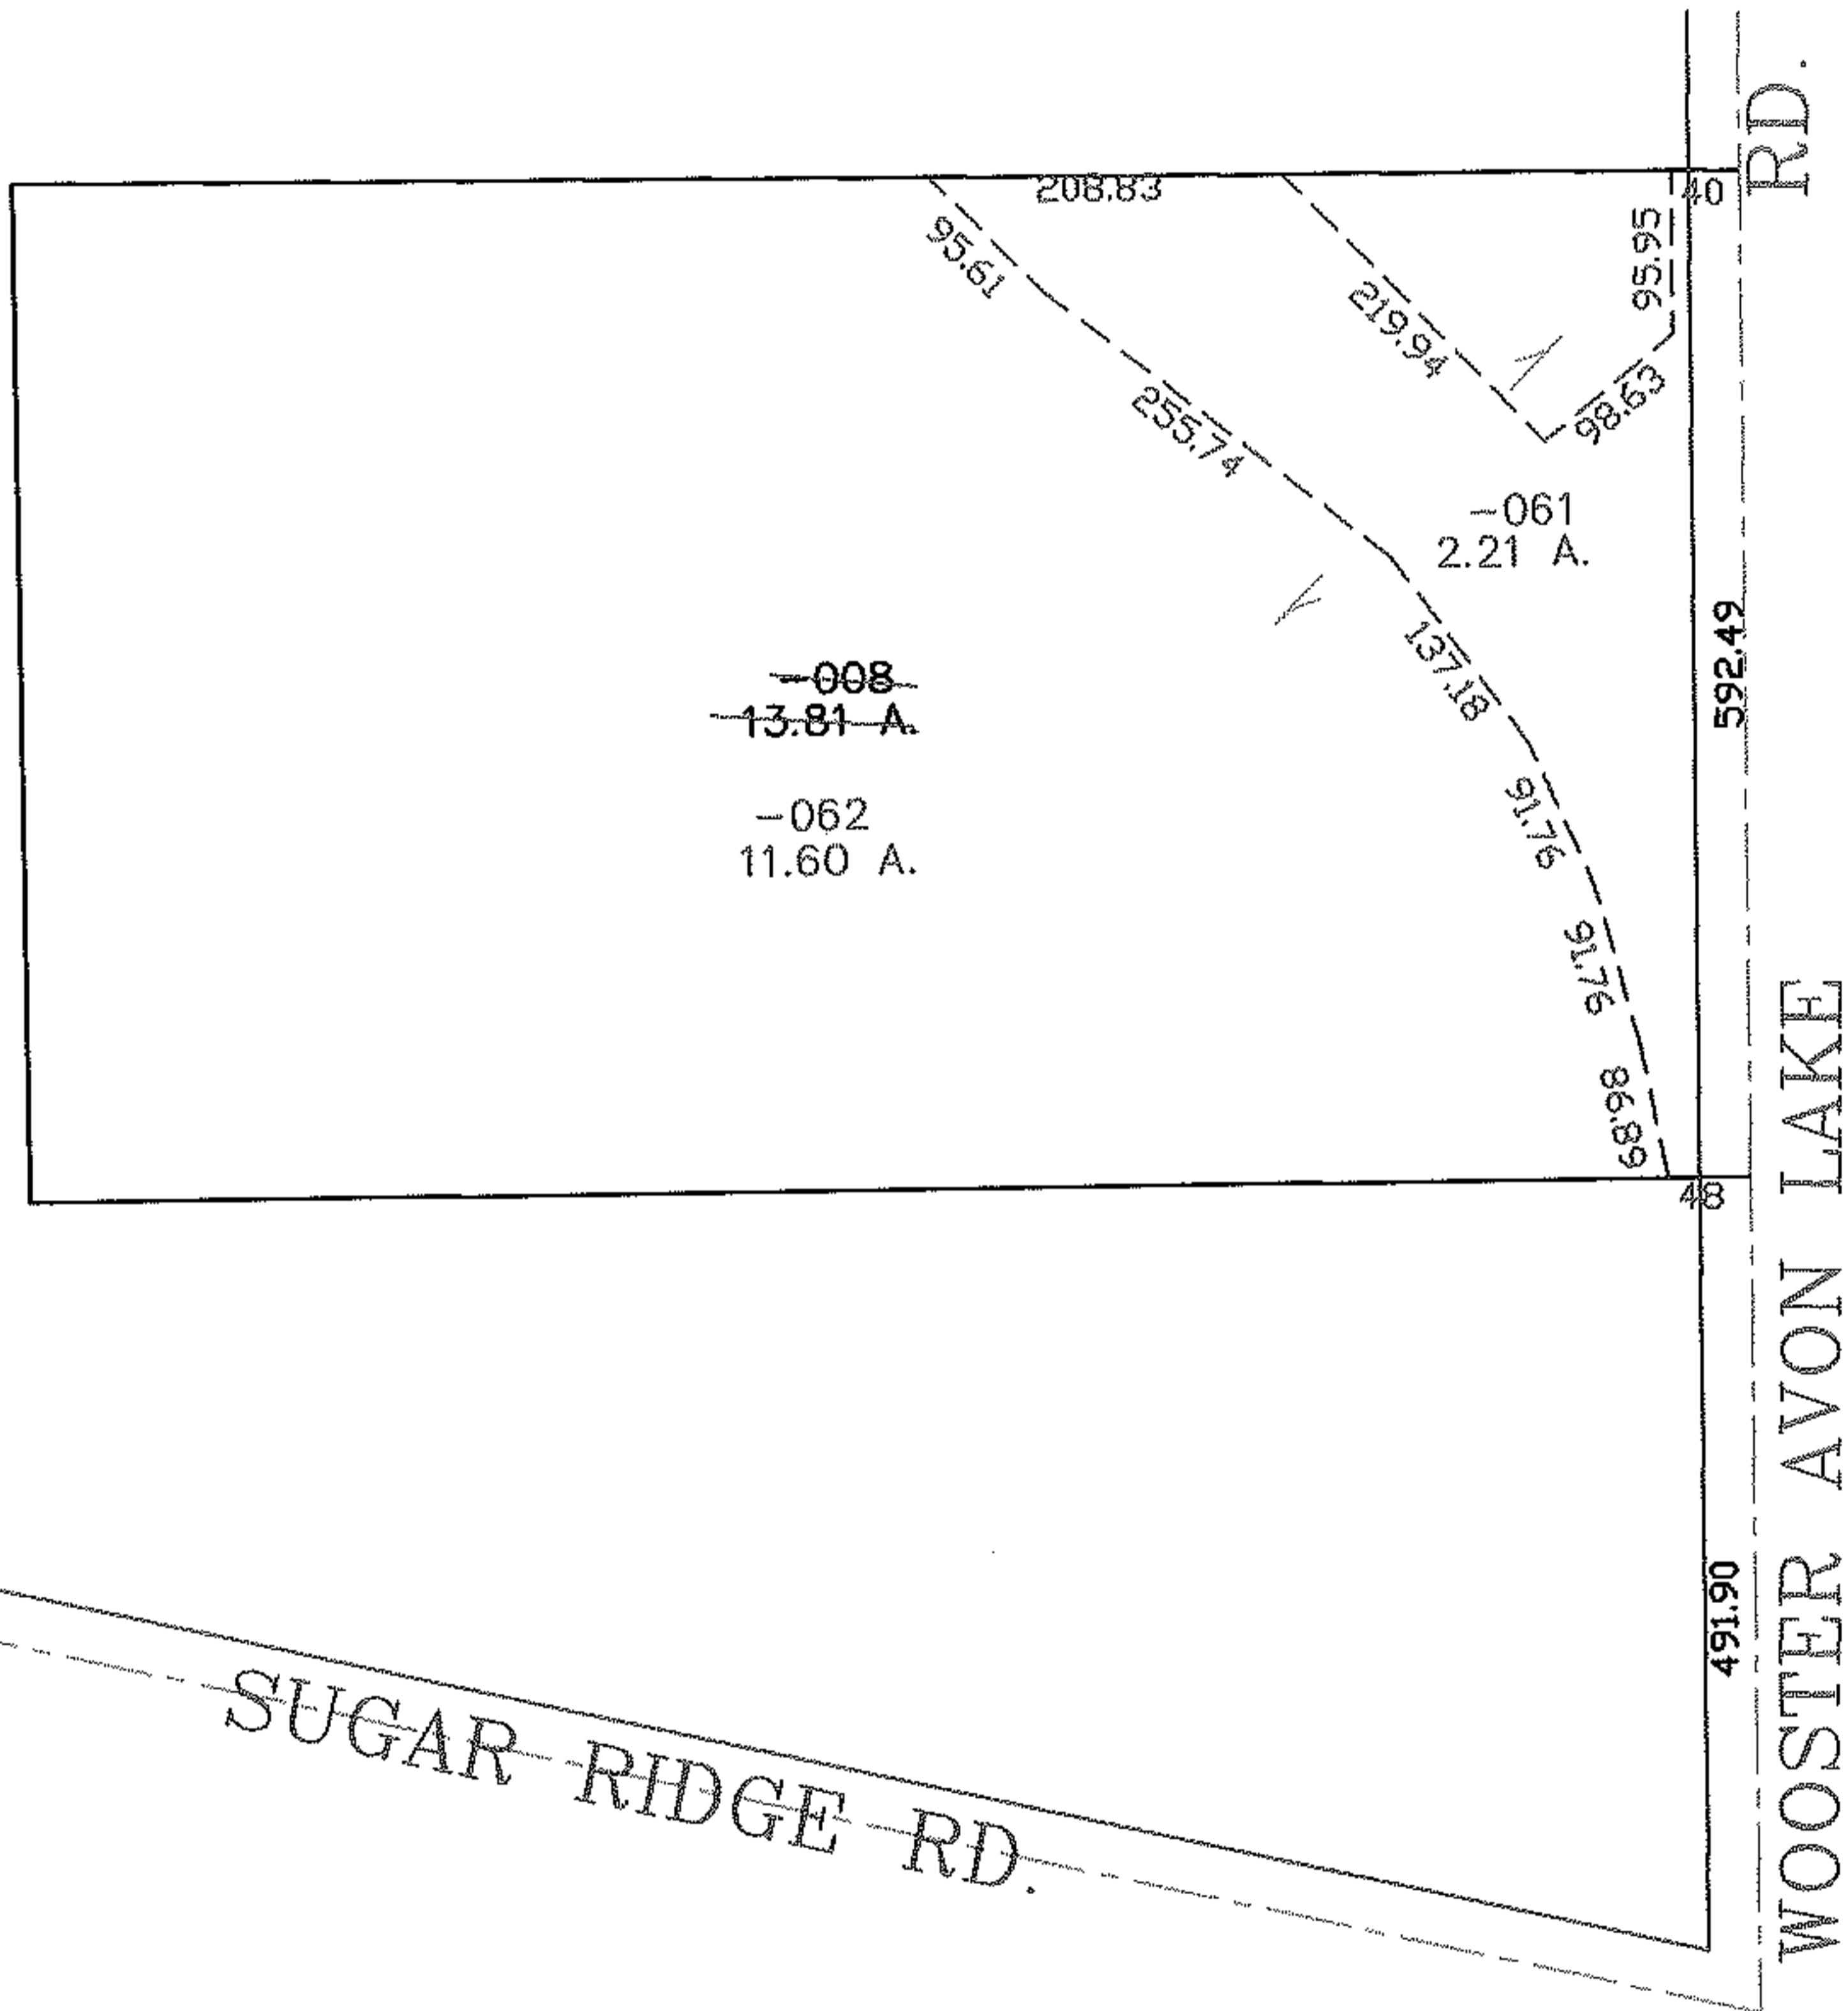


PARENT PARCEL: 07-00-026-101-008

CHILD PARCEL: 07-00-026-101-061, -062

STARTING POINT: CENTERLINE OF SUGAR RIDGE RD. & WOOSTER AVON LAKE RD.

NO. 00102

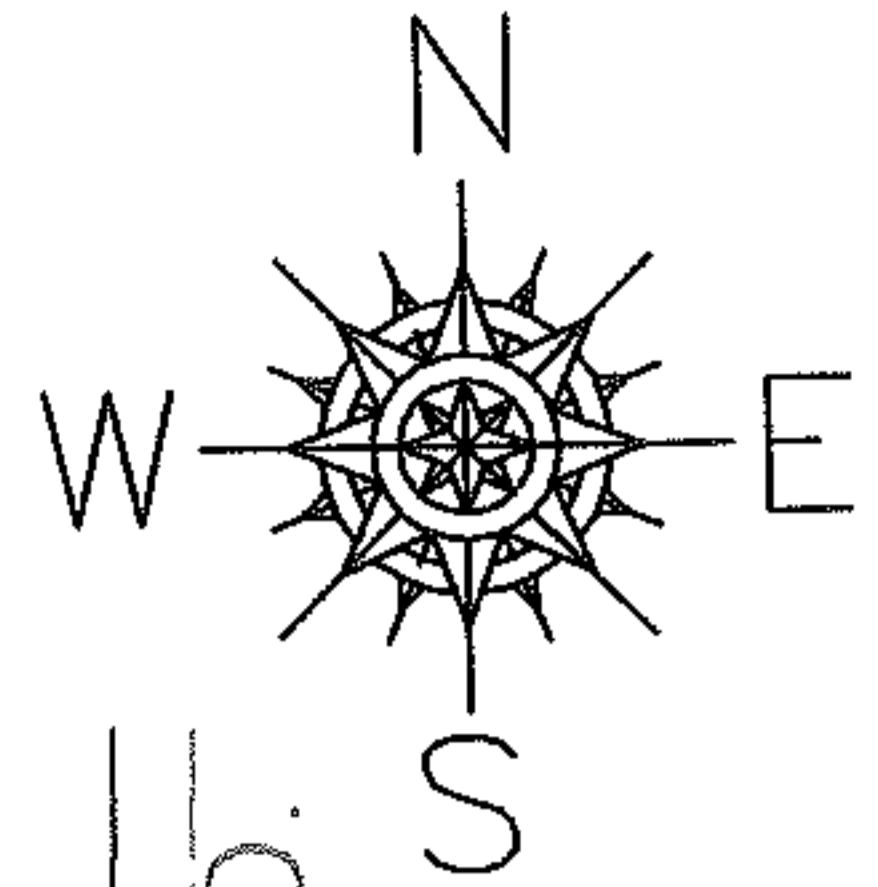

SPLITS/DEEDS PROCESSED
 LORAIN COUNTY TAX MAP DEPARTMENT
 226 MIDDLE AVE. ELYRIA, OHIO

SURVEYED BY: ROBERT J. MCAULEY
 CLOSURE: 0.00 : 10.000
 MAP PAGE(S): 07-00-026-B
 APPROVED BY: JAH DATE: 4-30-04
 SCALE: 1" = 200 PRIOR INSTRUMENT: DV 804/283