
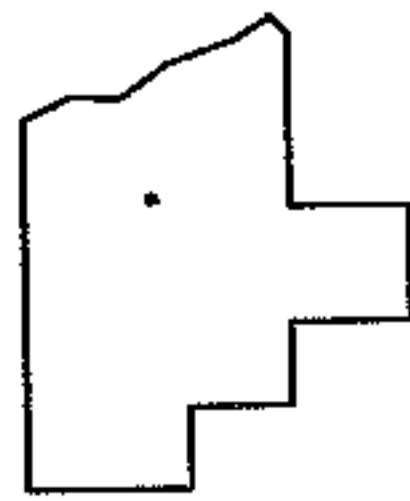
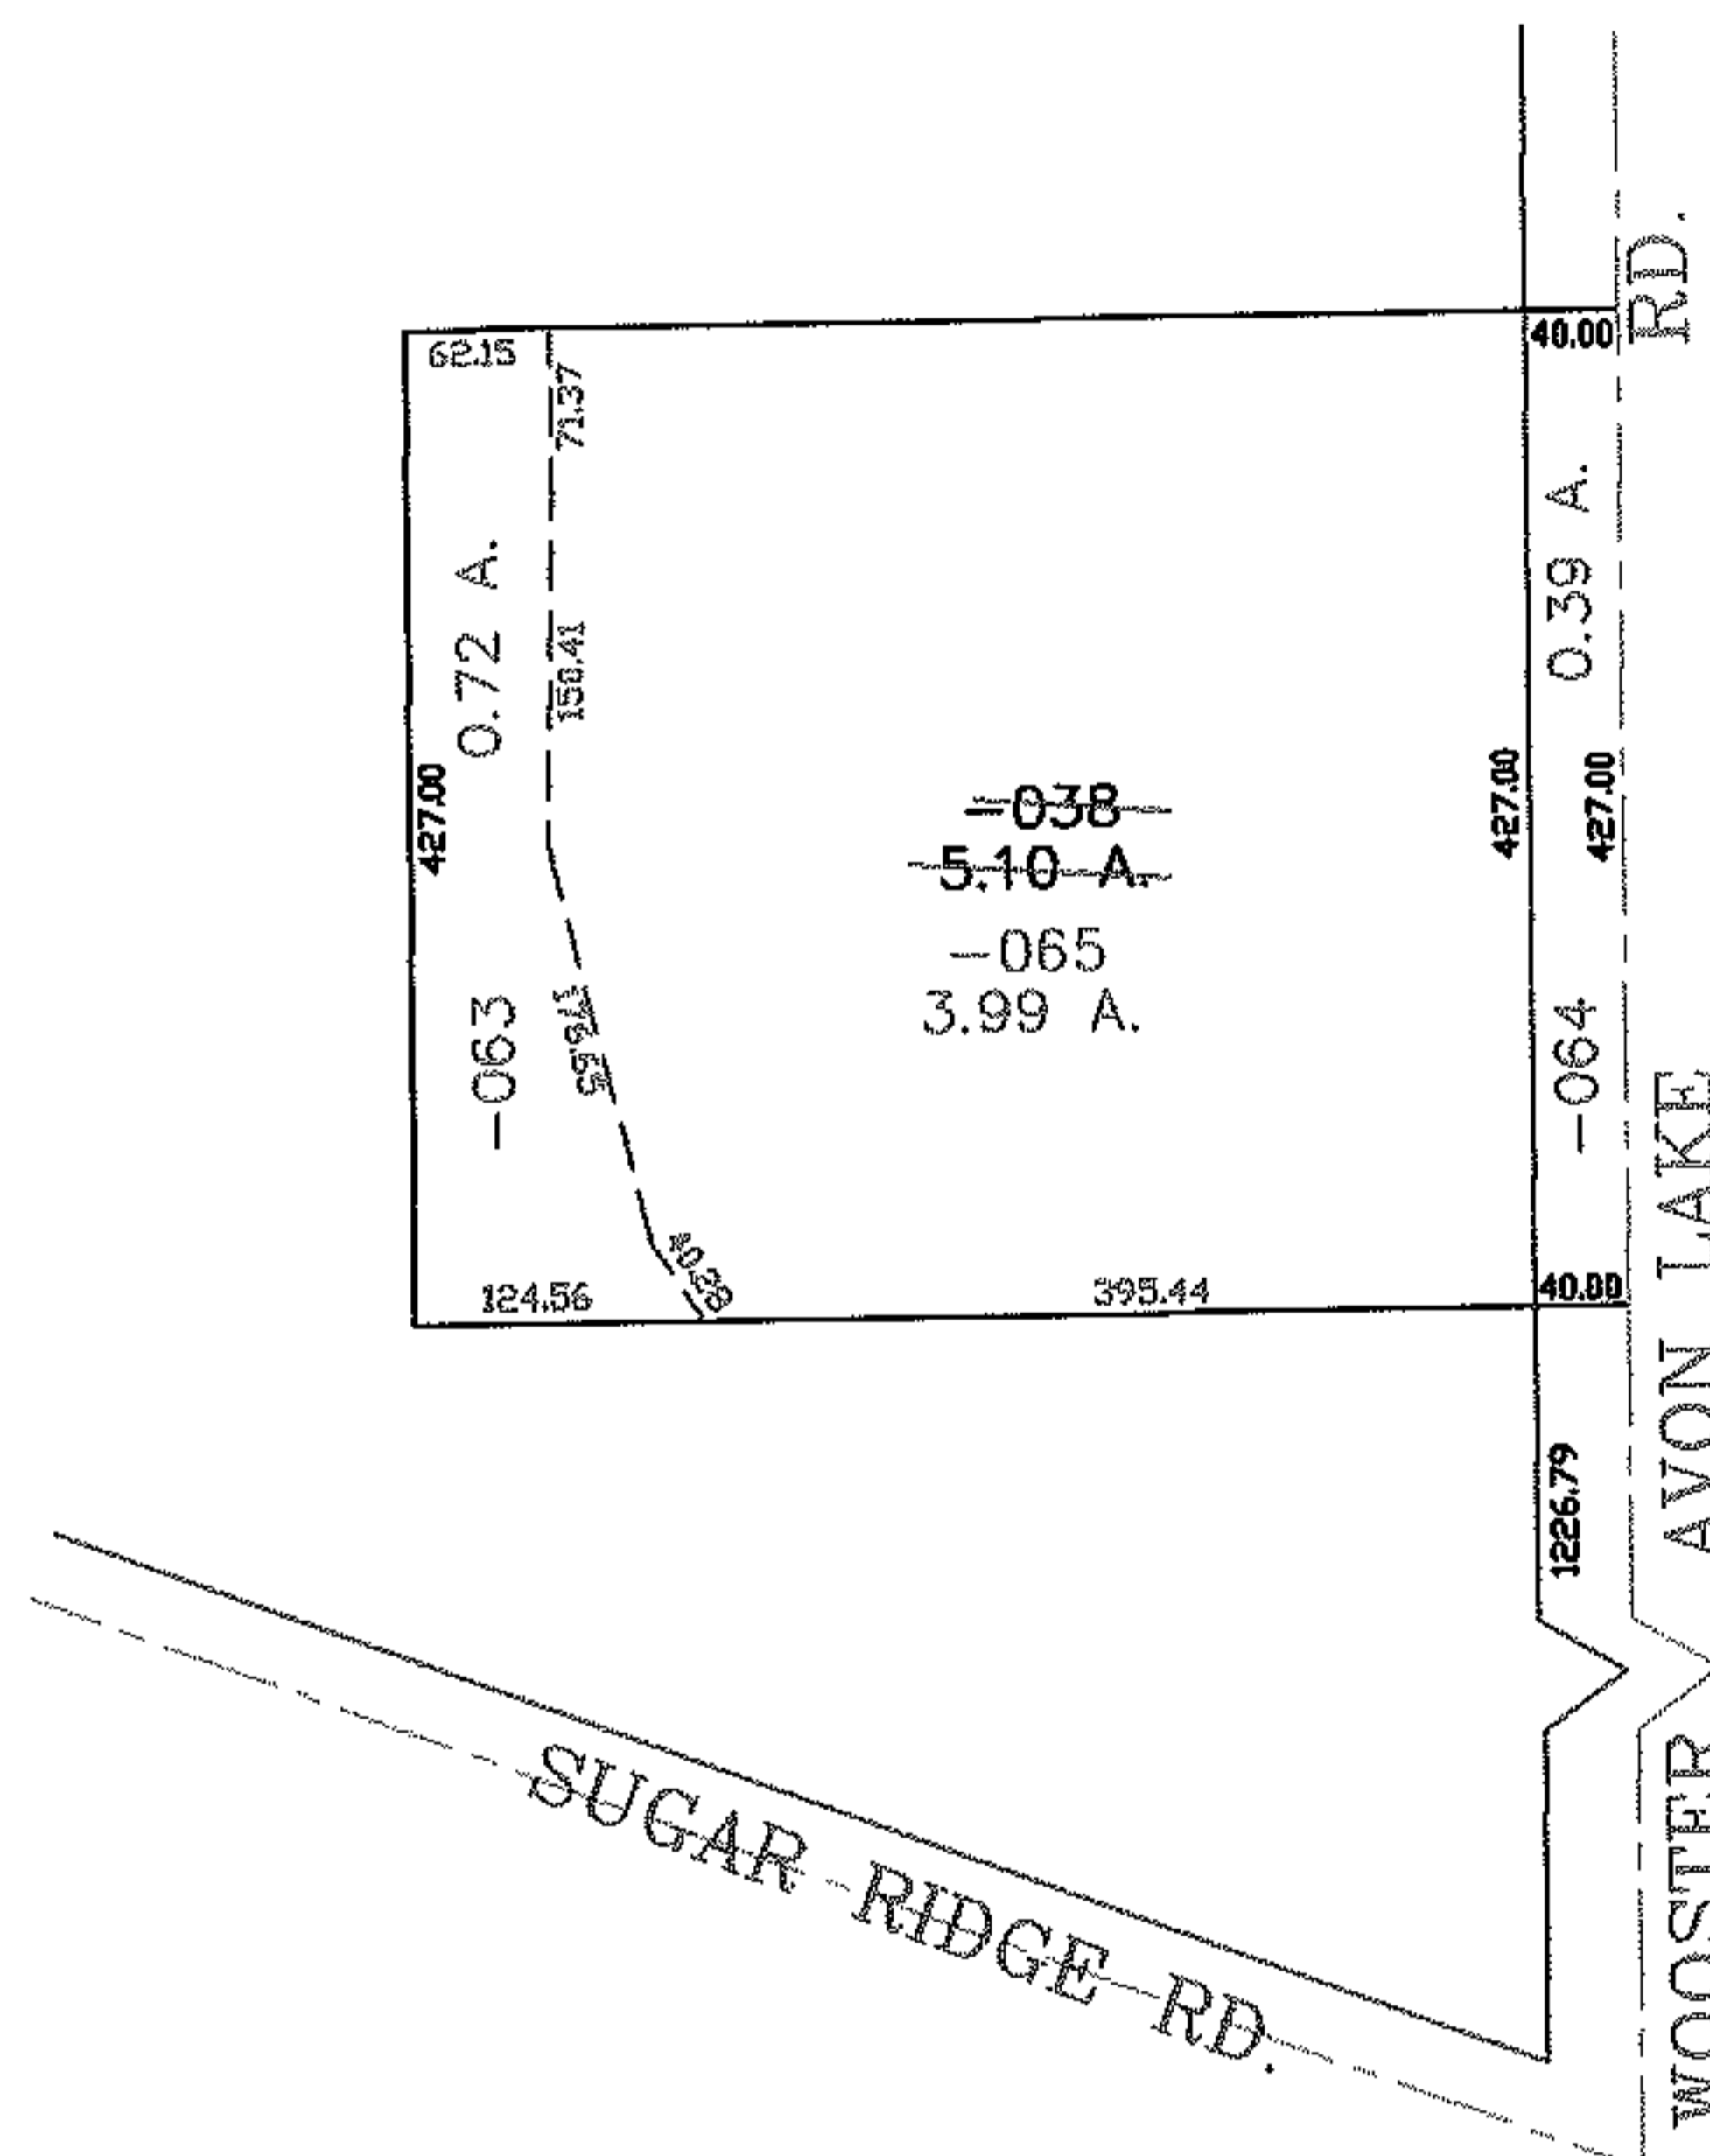


PARENT PARCEL: 07-00-026-101-038

CHILD PARCEL: 07-00-026-101-063 THRU -065

STARTING POINT: CENTERLINE OF SUGAR RIDGE RD. & WOOSTER AVON LAKE RD.

NO. 00103

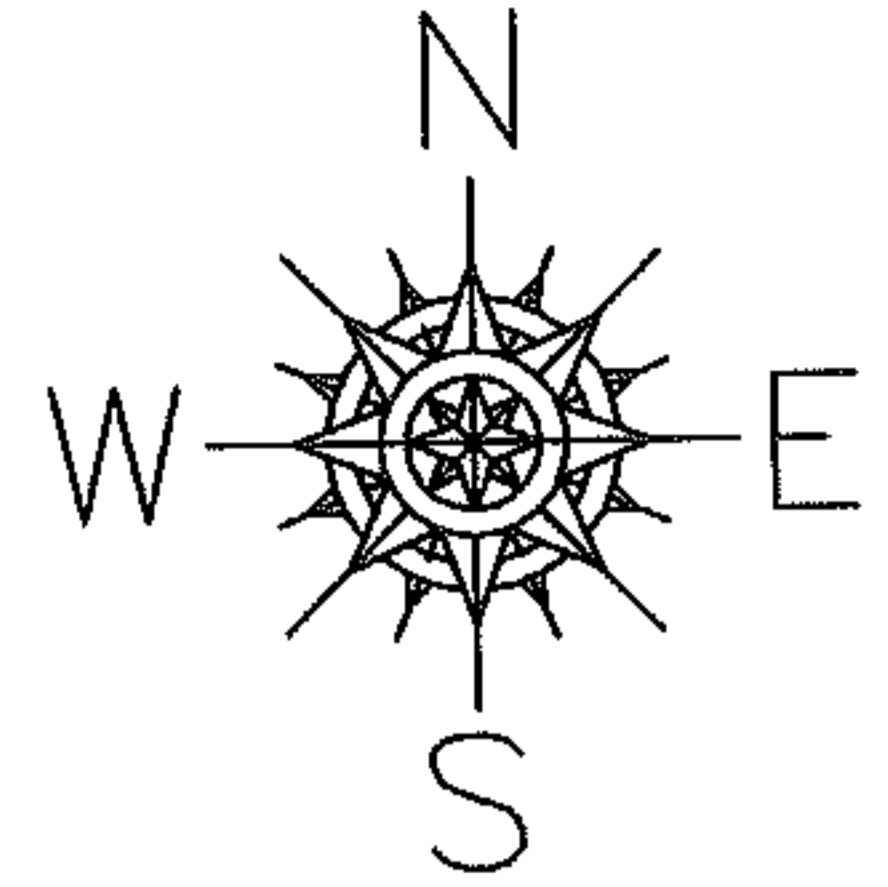

SPLITS/DEEDS PROCESSED
LORAIN COUNTY TAX MAP DEPARTMENT
226 MIDDLE AVE. ELYRIA, OHIO

SURVEYED BY: ROBERT J. MCAULEY
CLOSURE: 0.00 ; 10.000
MAP PAGE(S): 07-00-026-B
APPROVED BY: JAH DATE: 5-3-04
SCALE: 1" = 200 PRIOR INSTRUMENT: OR 591/533