


PARENT PARCEL: 07-00-023-101-002


CHILD PARCEL: 07-00-023-101-099, -100

STARTING POINT: CENTERLINE OF AVON BELDEN RD. & O.L. 23

NO. 00104

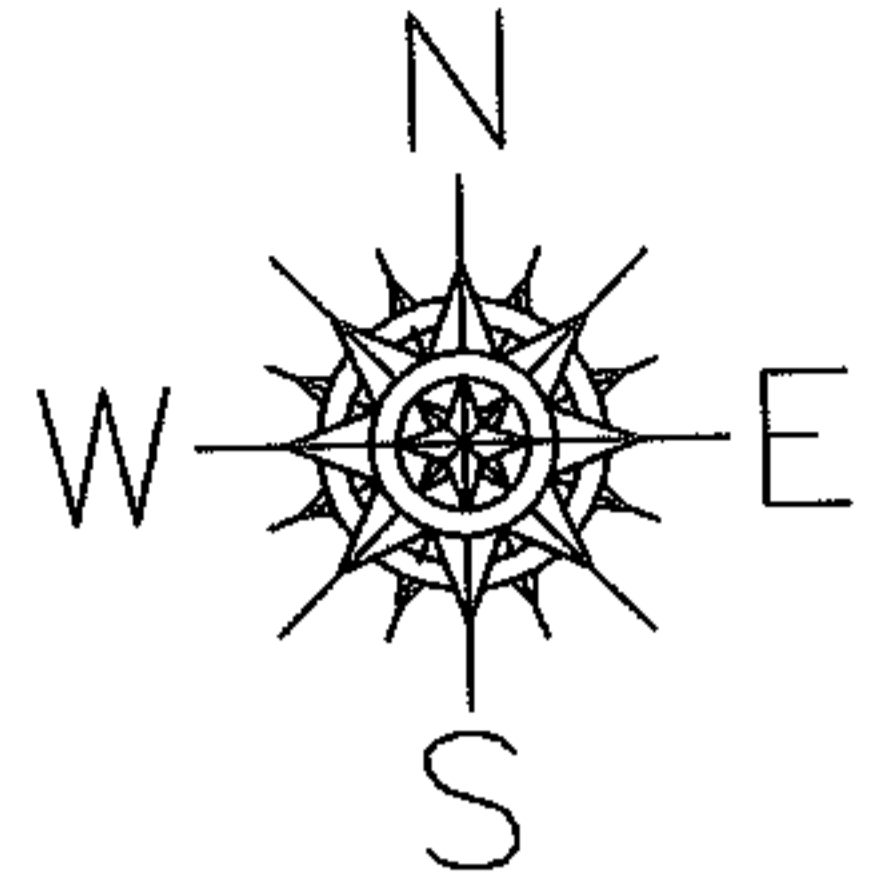

AVON BELDEN RD.

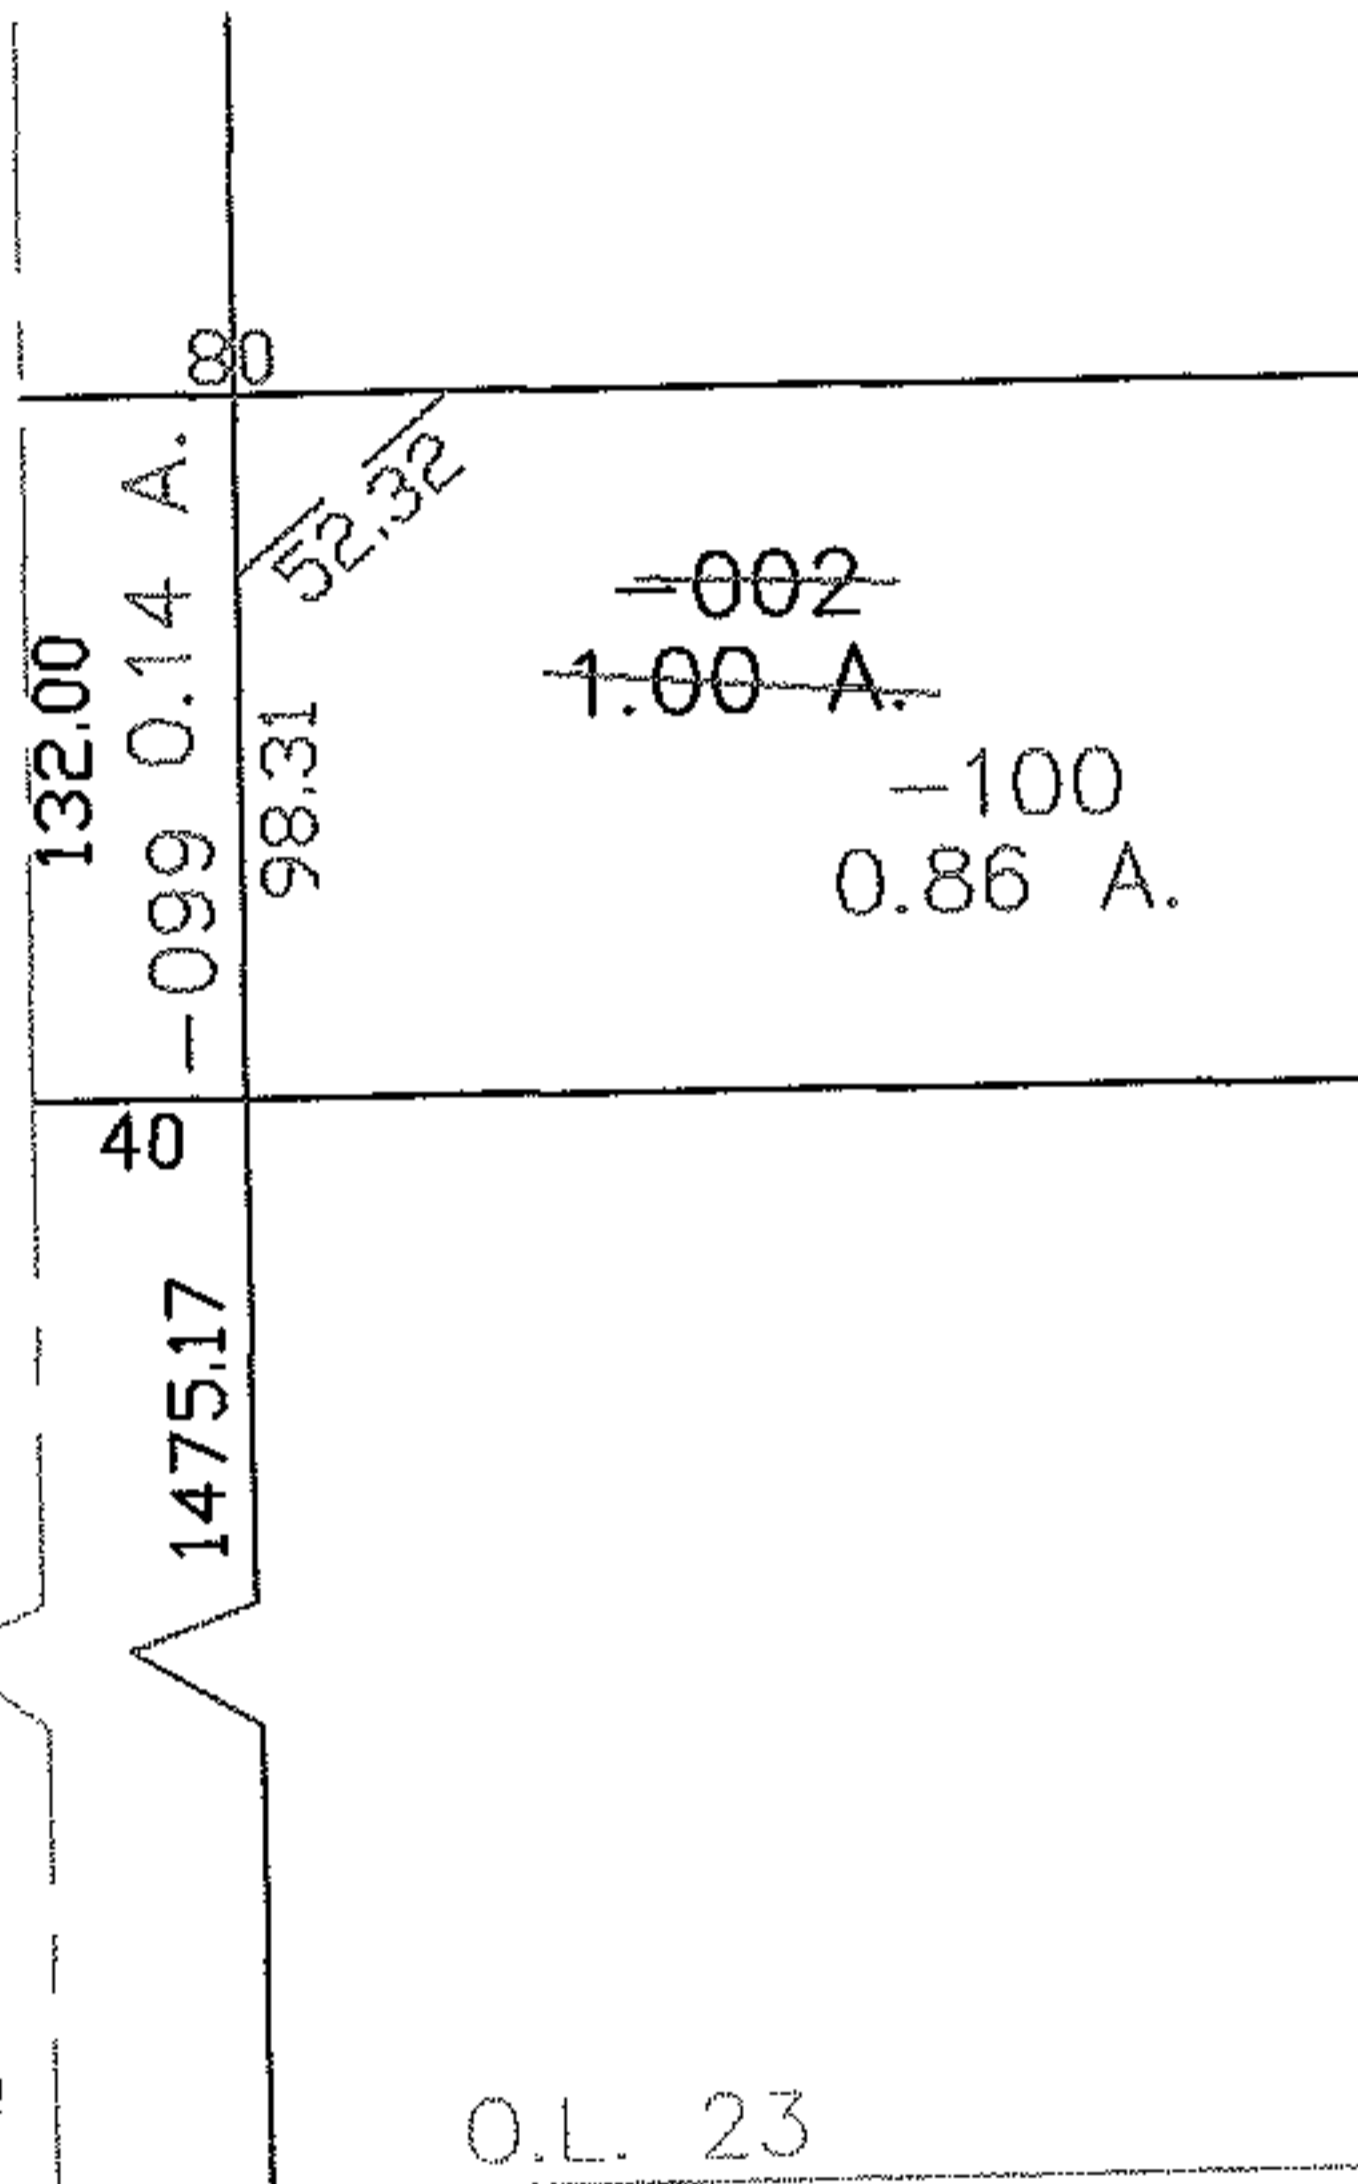

O.L. 23

O.L. 26

SPLITS/DEEDS PROCESSED

LORAIN COUNTY TAX MAP DEPARTMENT  
226 MIDDLE AVE. ELYRIA, OHIO

SURVEYED BY: ROBERT J MCAULEY

CLOSURE: 0.00 : 10,000

MAP PAGE(S): 07-00-023-A

APPROVED BY: JAH DATE: 5-3-04

SCALE: 1" = 100 PRIOR INSTRUMENT: 20000679231