


PARENT PARCEL: 07-00-023-101-001



CHILD PARCEL: 07-00-023-101-101, -102

STARTING POINT: CENTERLINE OF AVON BELDEN RD. & O.L. 23

NO. 00105

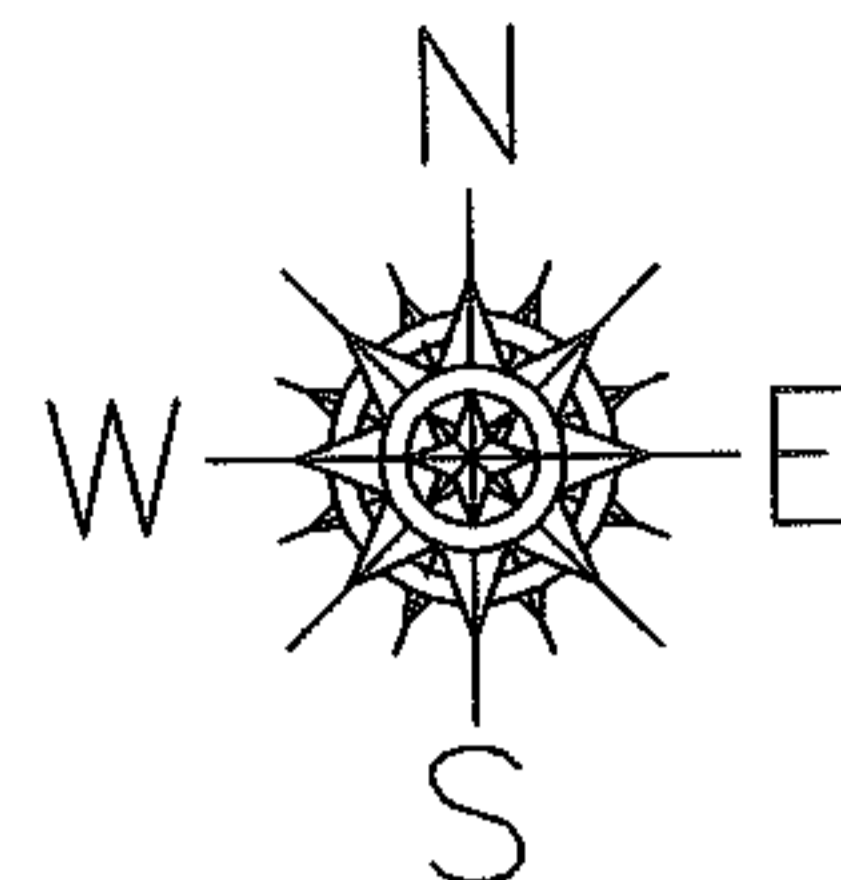

N.Y.C. R.R.

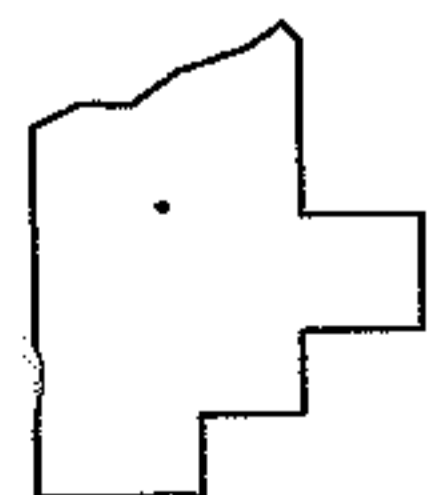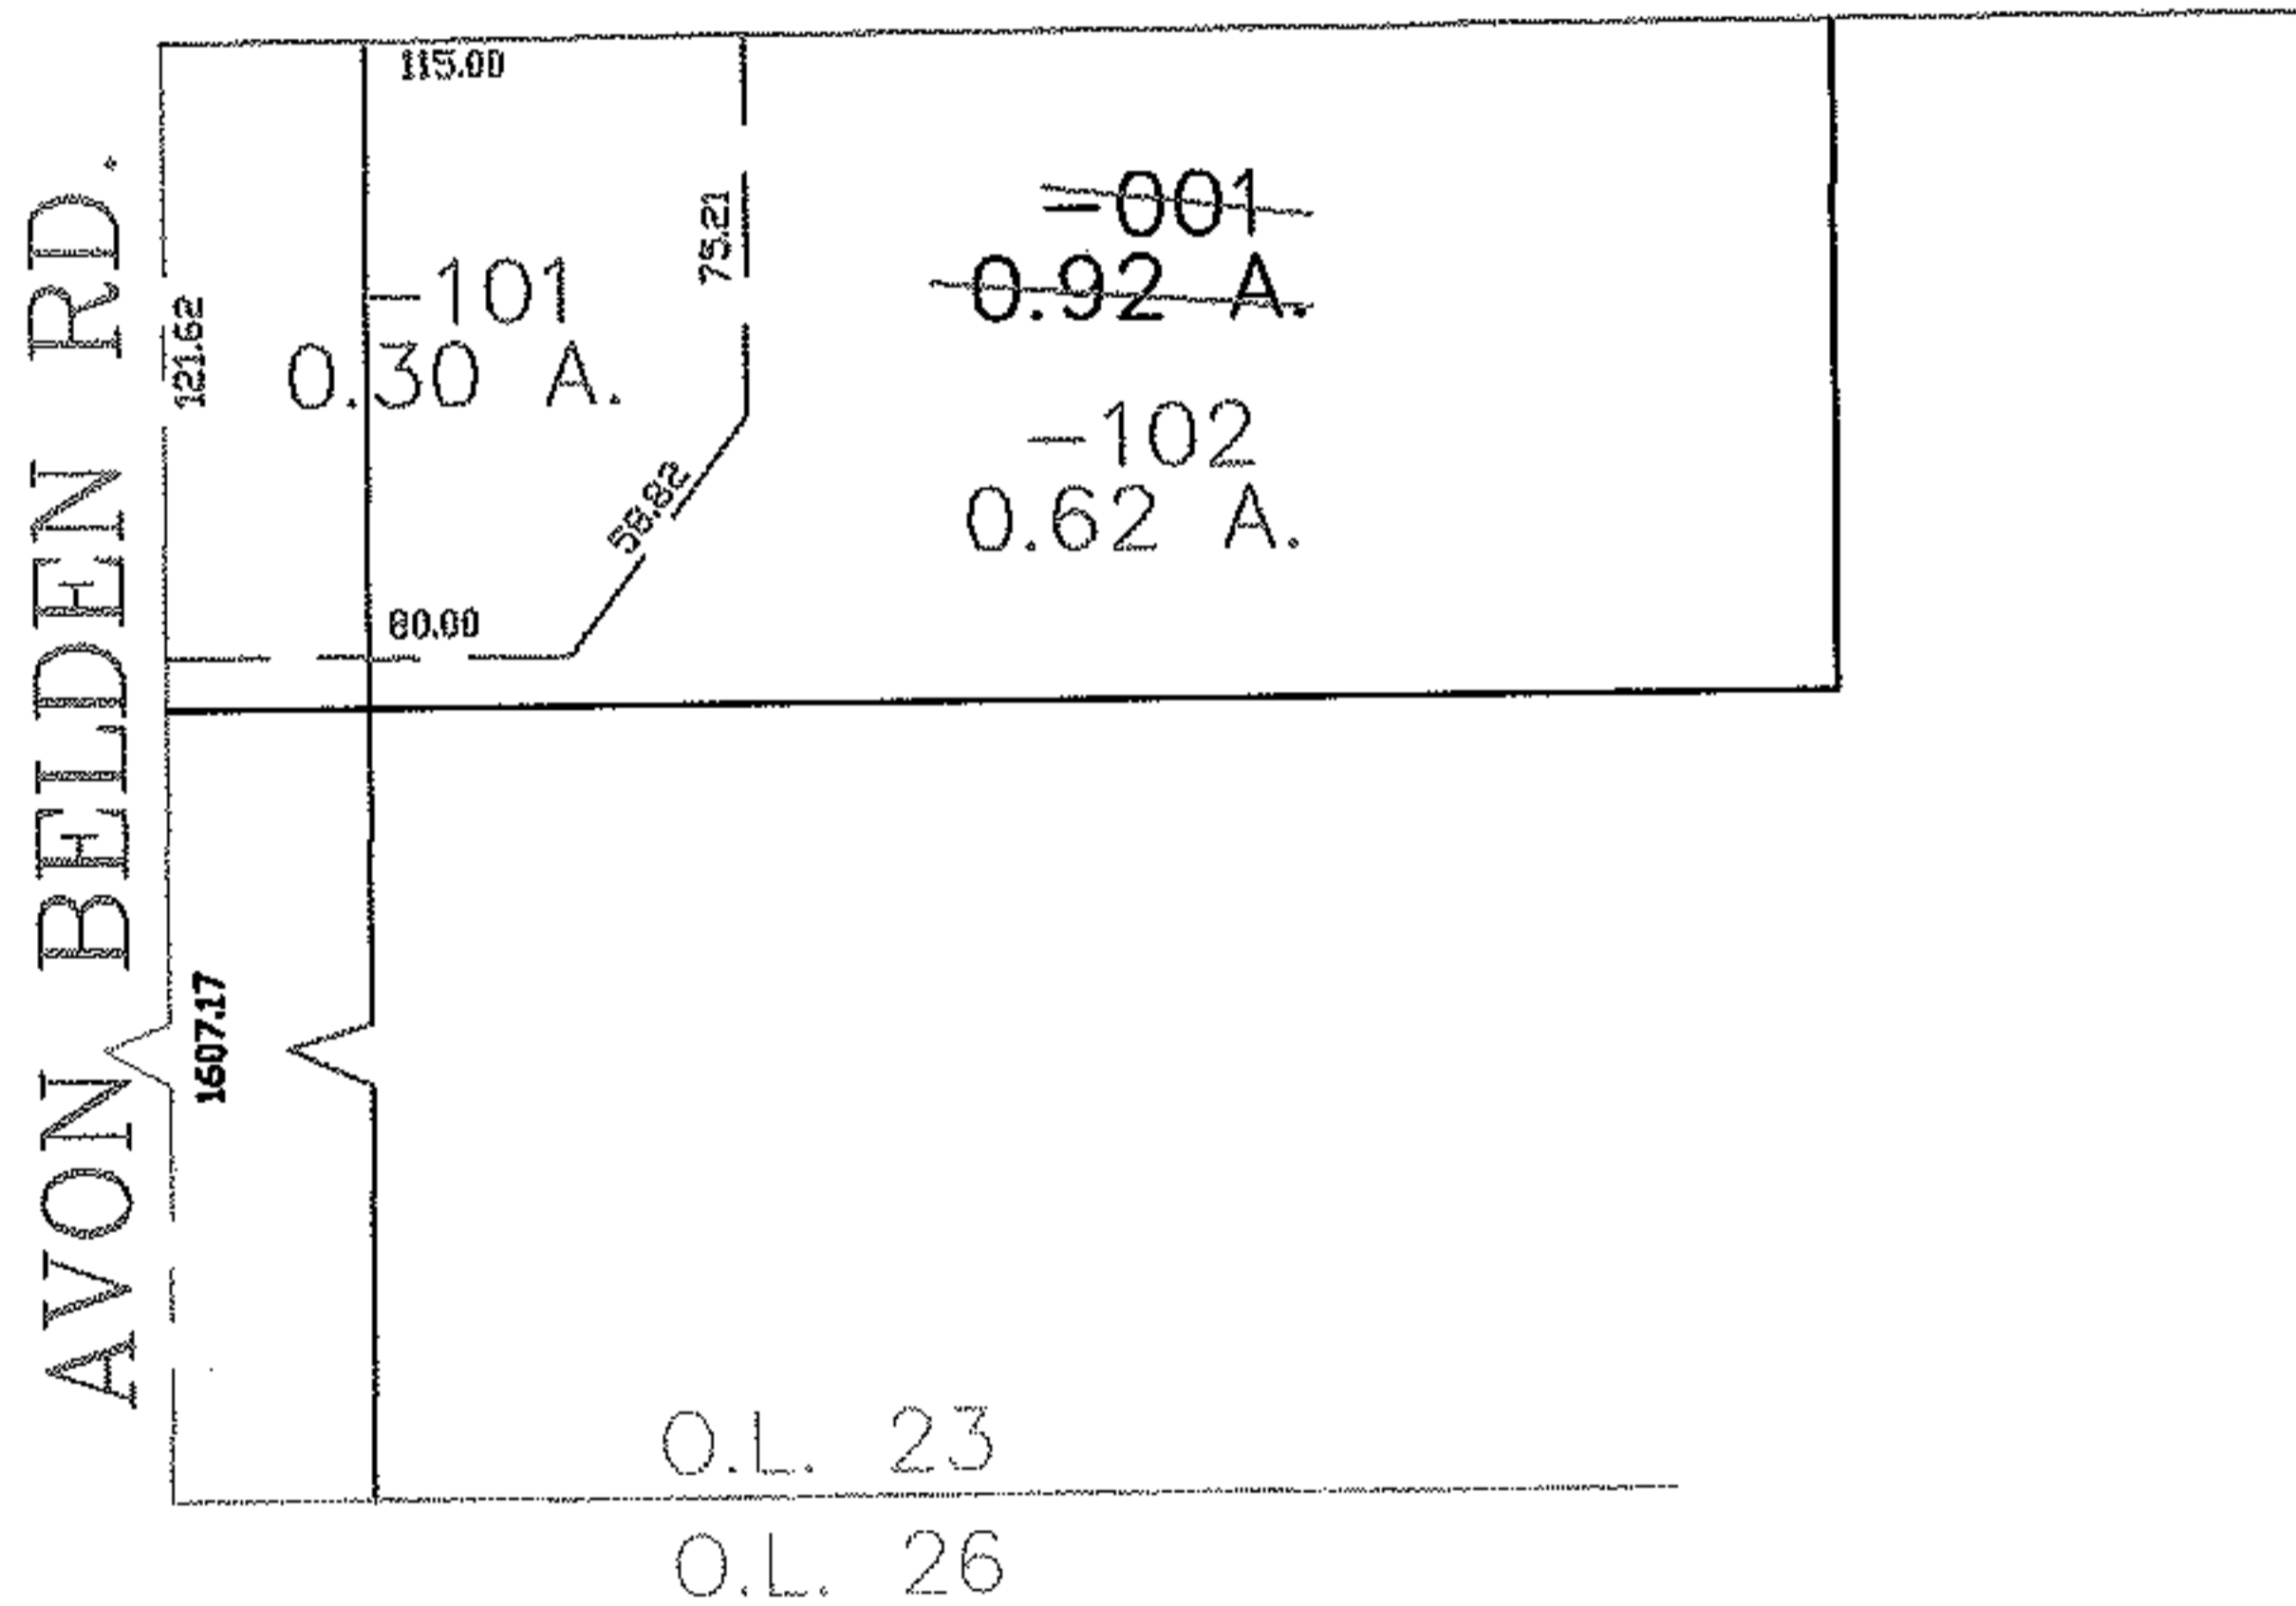

SPLITS/DEEDS PROCESSED

LORAIN COUNTY TAX MAP DEPARTMENT
226 MIDDLE AVE. ELYRIA, OHIO

SURVEYED BY: ROBERT J. MCAULEY

CLOSURE: 0.00 : 10.000

MAP PAGE(S): 07-00-023-A

APPROVED BY: JAH DATE: 5-4-04

SCALE: 1" = 100 PRIOR INSTRUMENT: DV 1290/89