
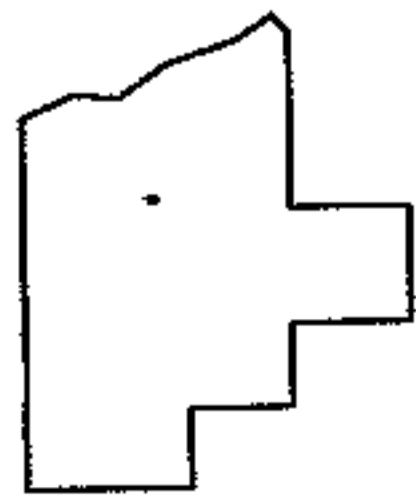
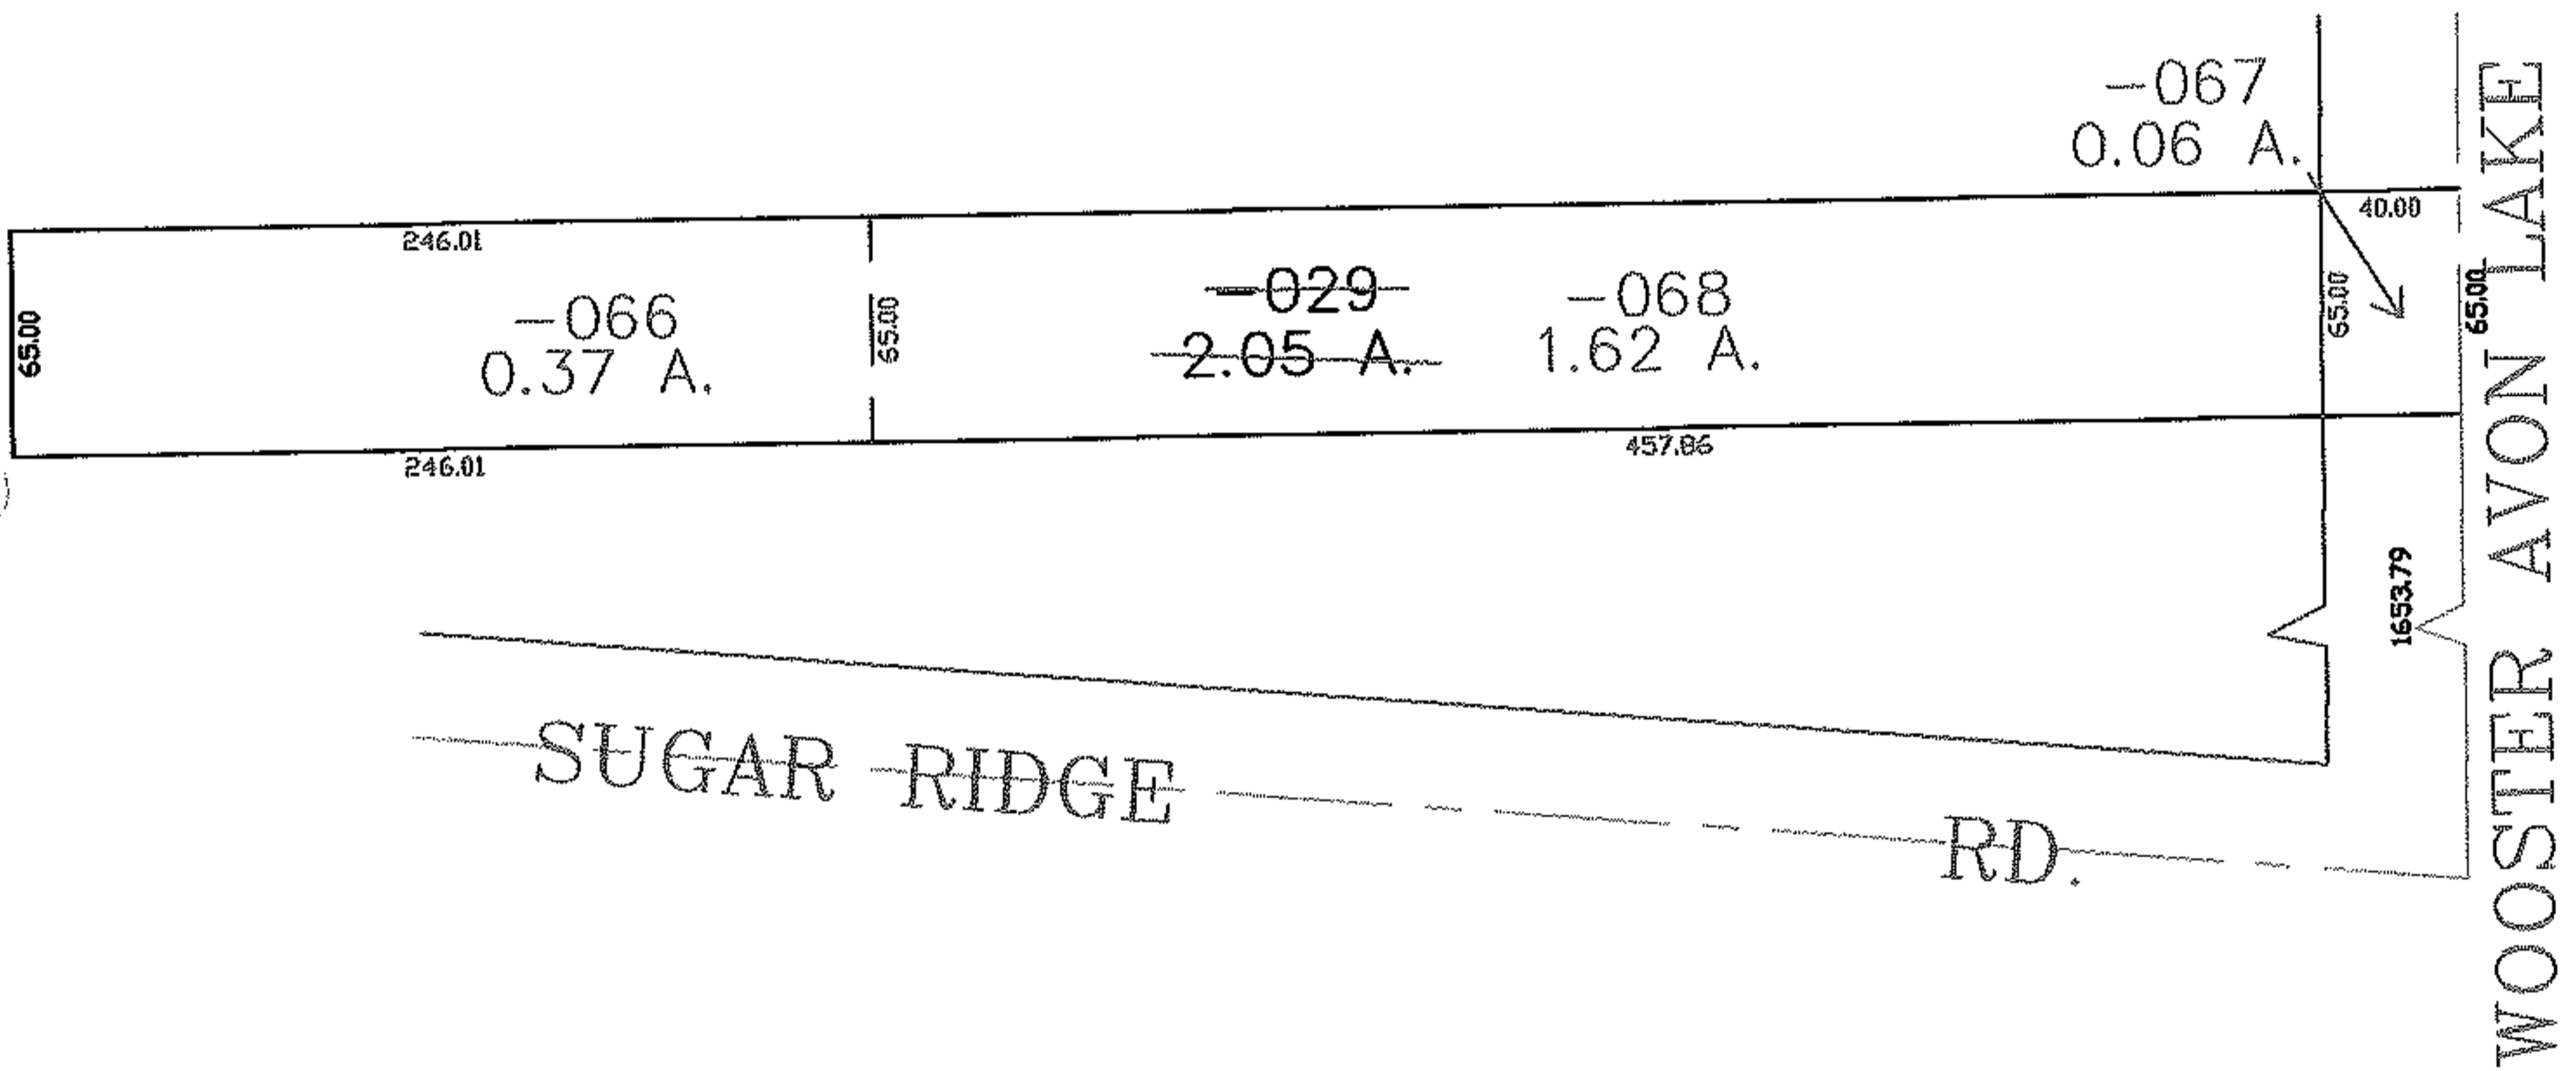


PARENT PARCEL: 07-00-026-101-029

CHILD PARCEL: 07-00-026-101-066 THRU -068

STARTING POINT: CENTERLINE OF SUGAR RIDGE RD. & WOOSTER AVON LAKE RD.

NO. 00106

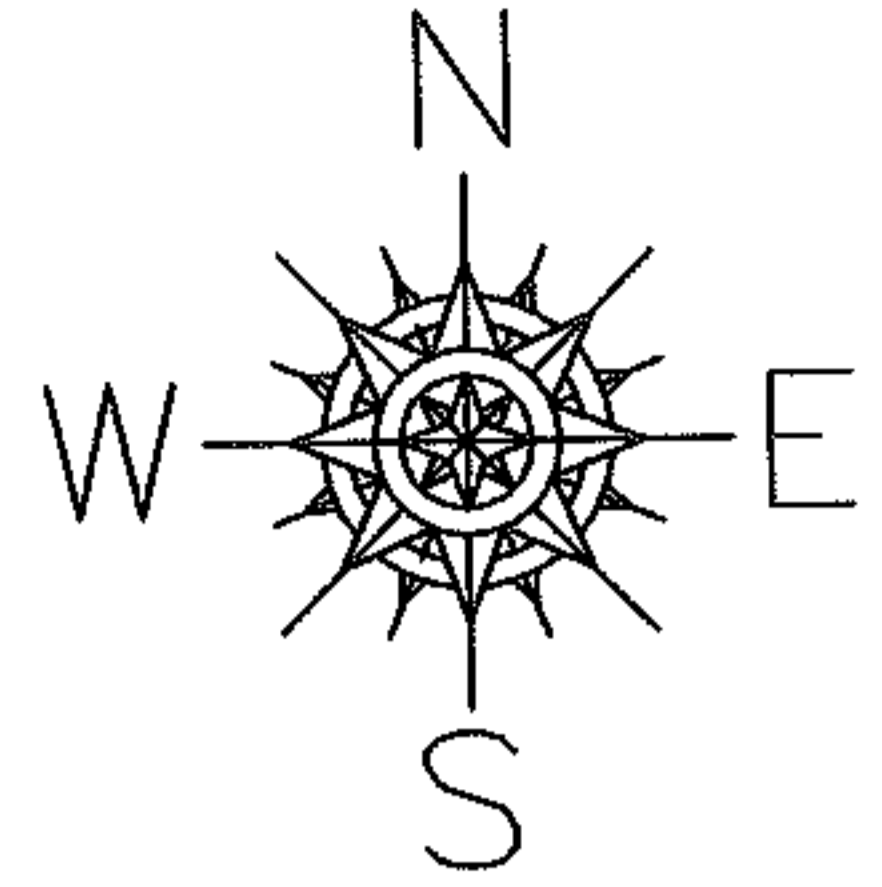

**SPLITS/DEEDS PROCESSED**  
 LORAIN COUNTY TAX MAP DEPARTMENT  
 226 MIDDLE AVE. ELYRIA, OHIO

SURVEYED BY: ROBERT J. MCAULEY  
 CLOSURE: 0.00 : 10.000  
 MAP PAGE(S): 07-00-026-B  
 APPROVED BY: JAH DATE: 5-4-04  
 SCALE: 1" = 100 PRIOR INSTRUMENT: DV 1228/142