
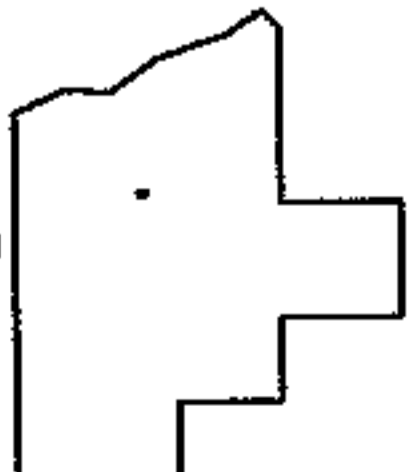
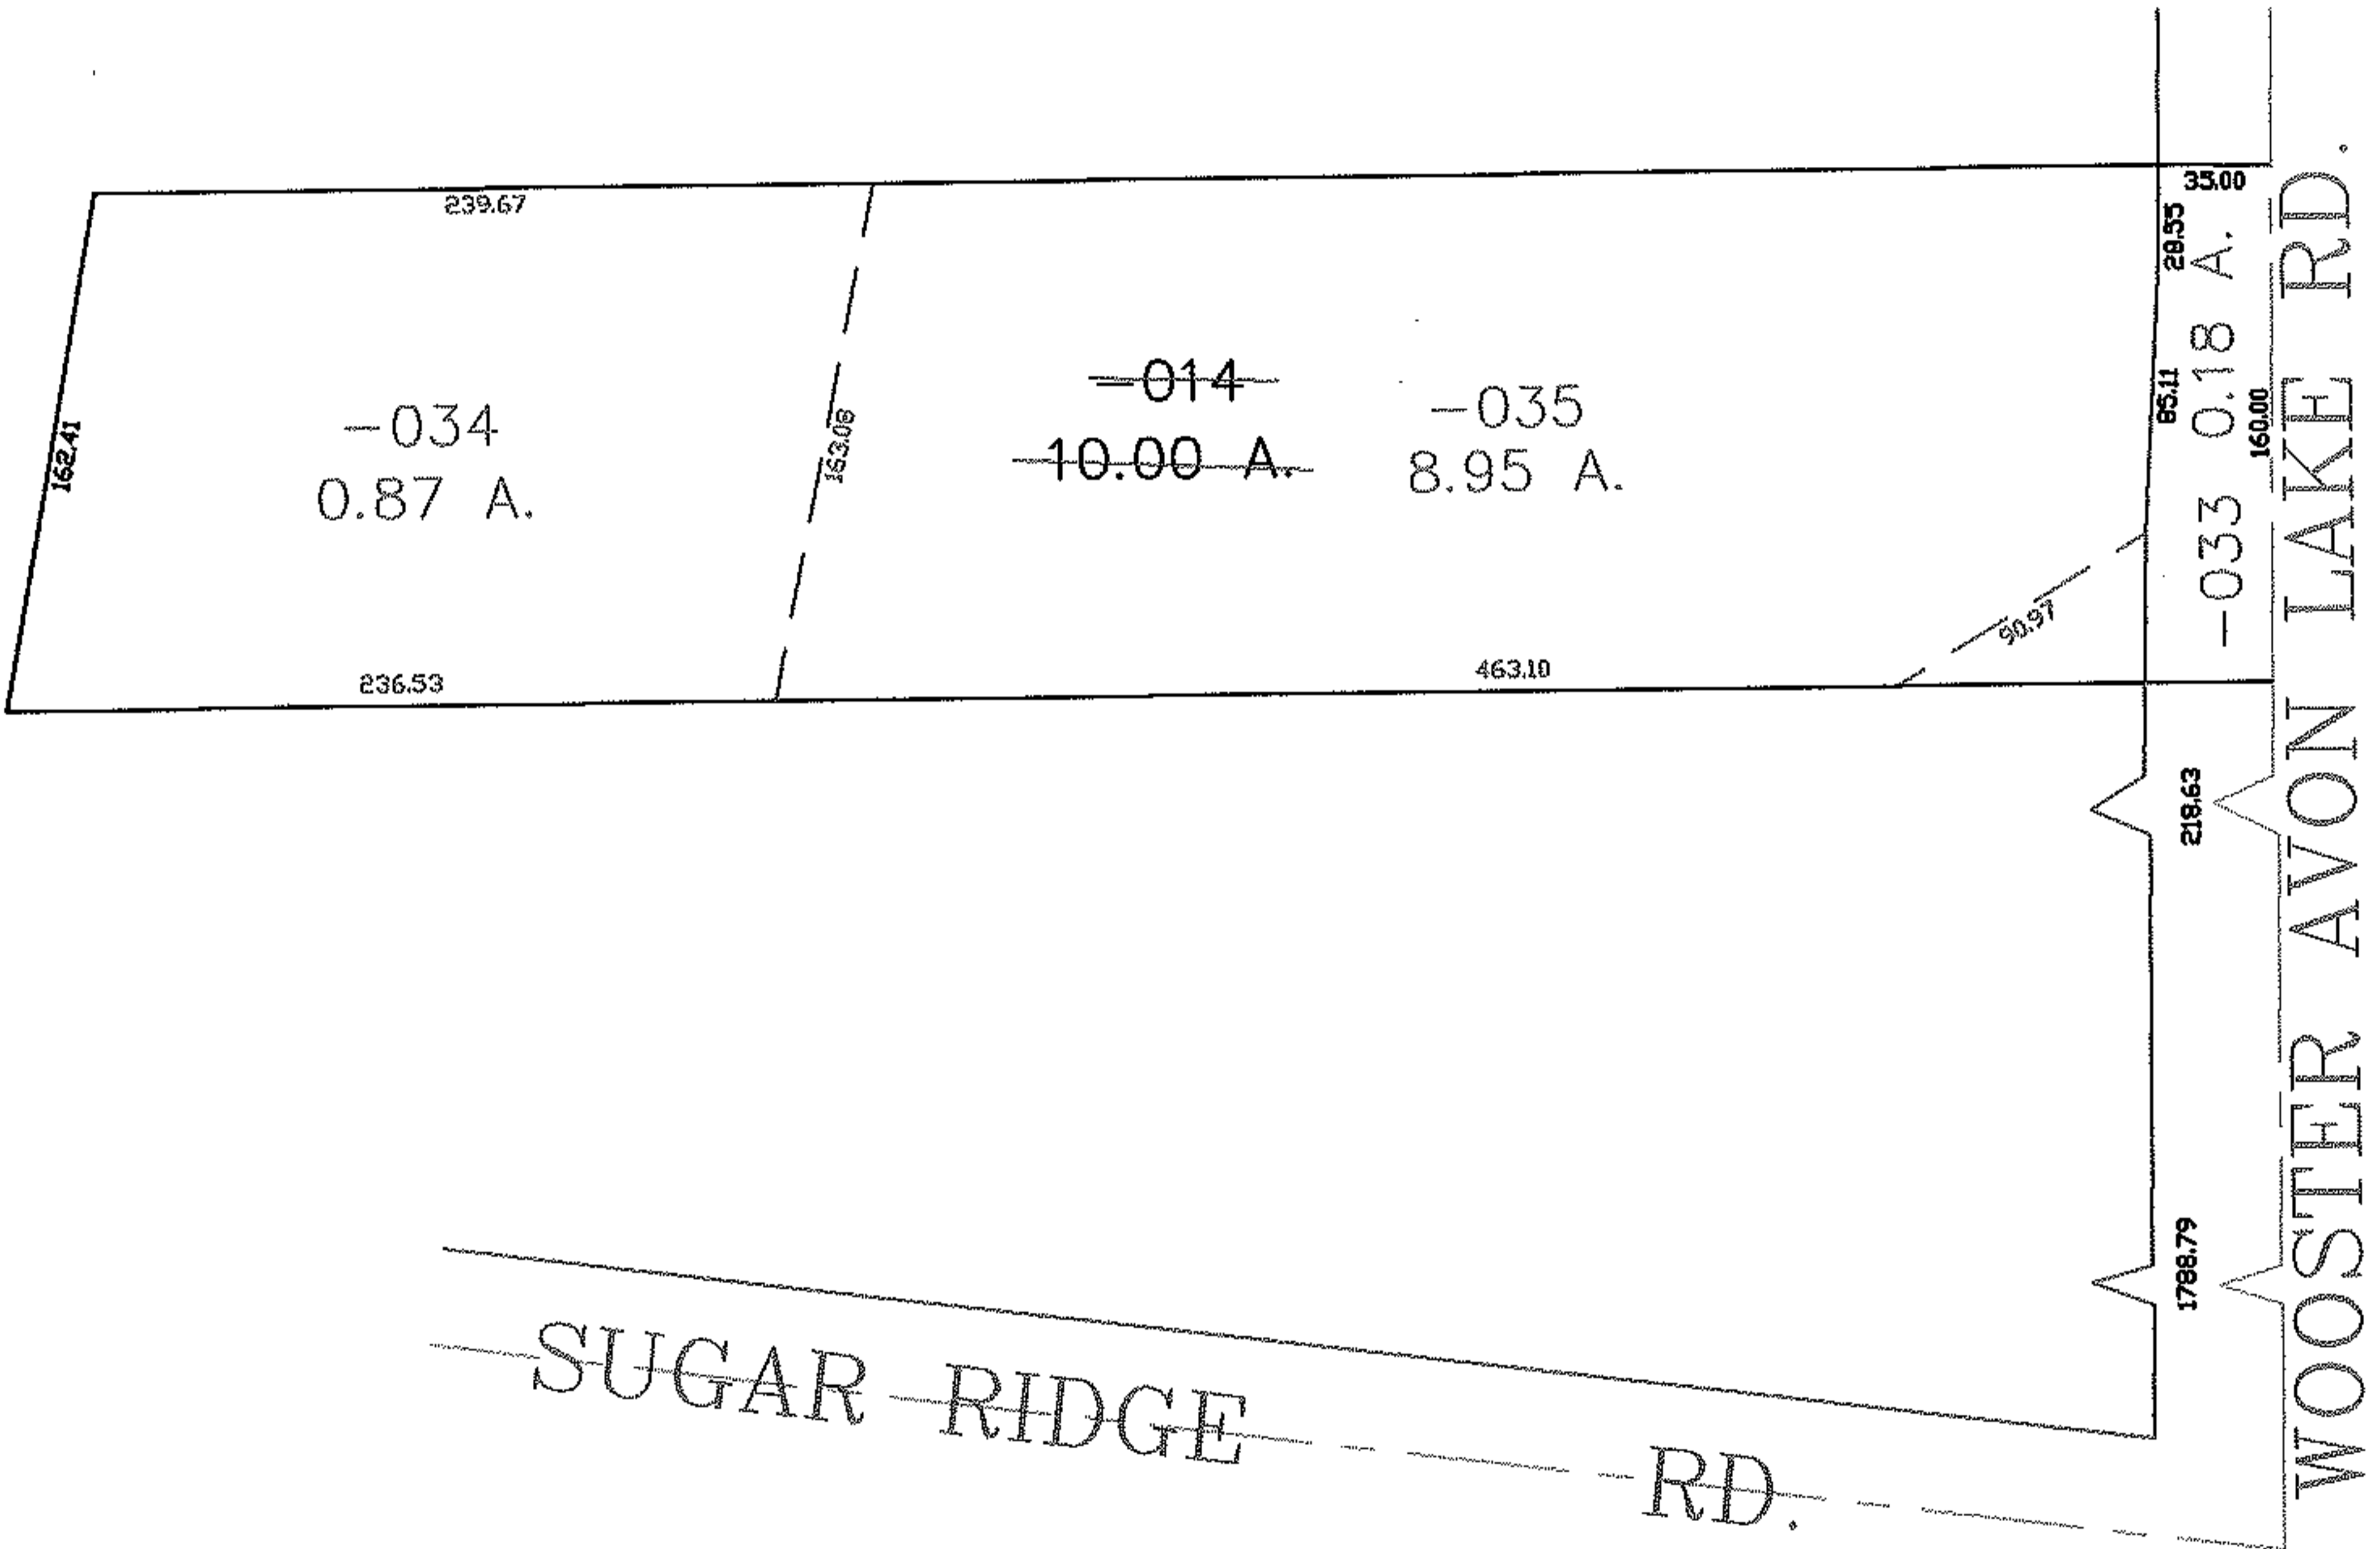


PARENT PARCEL: 07-00-027-109-014

CHILD PARCEL: 07-00-027-109-033 THRU -035

STARTING POINT: CENTERLINE OF SUGAR RIDGE RD. & WOOSTER AVON LAKE RD.

NO. 00107

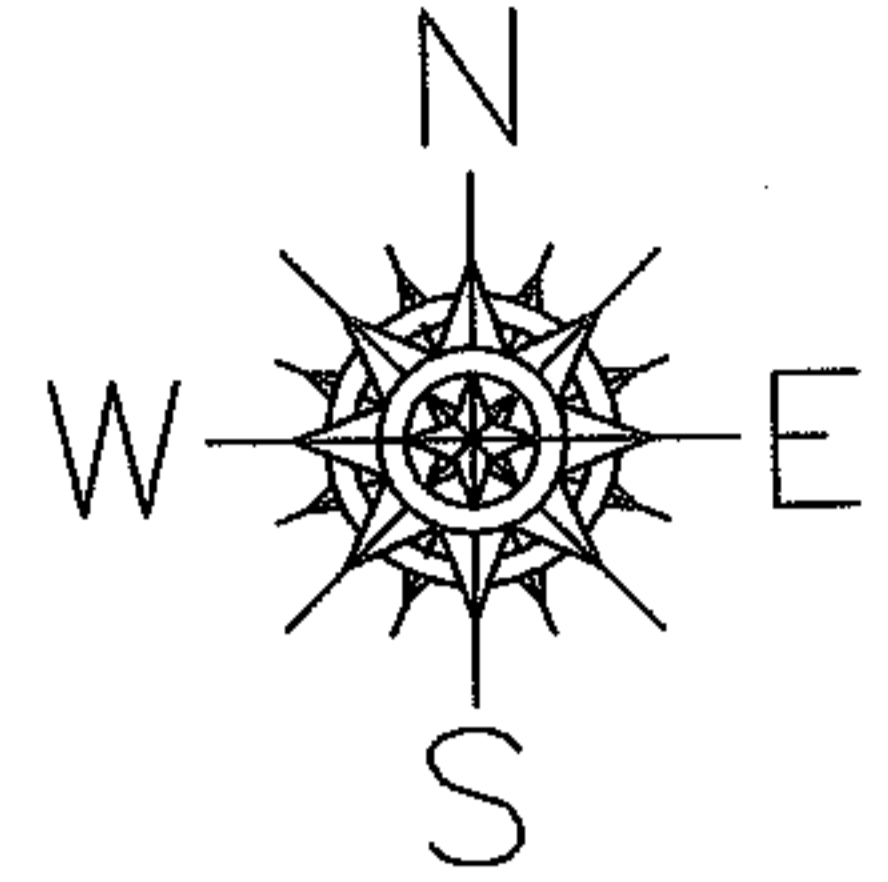

SPLITS/DEEDS PROCESSED
 LORAIN COUNTY TAX MAP DEPARTMENT
 226 MIDDLE AVE. ELYRIA, OHIO

SURVEYED BY: ROBERT J. MCAULEY
 CLOSURE: 0.00 : 10.000
 MAP PAGE(S): 07-00-027-D
 APPROVED BY: JAH DATE: 05-05-04
 SCALE: 1" = 100 PRIOR INSTRUMENT: 19970481627