
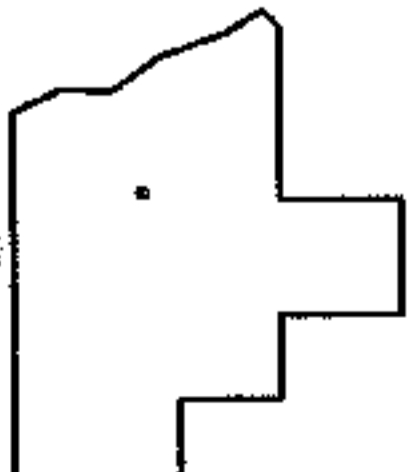
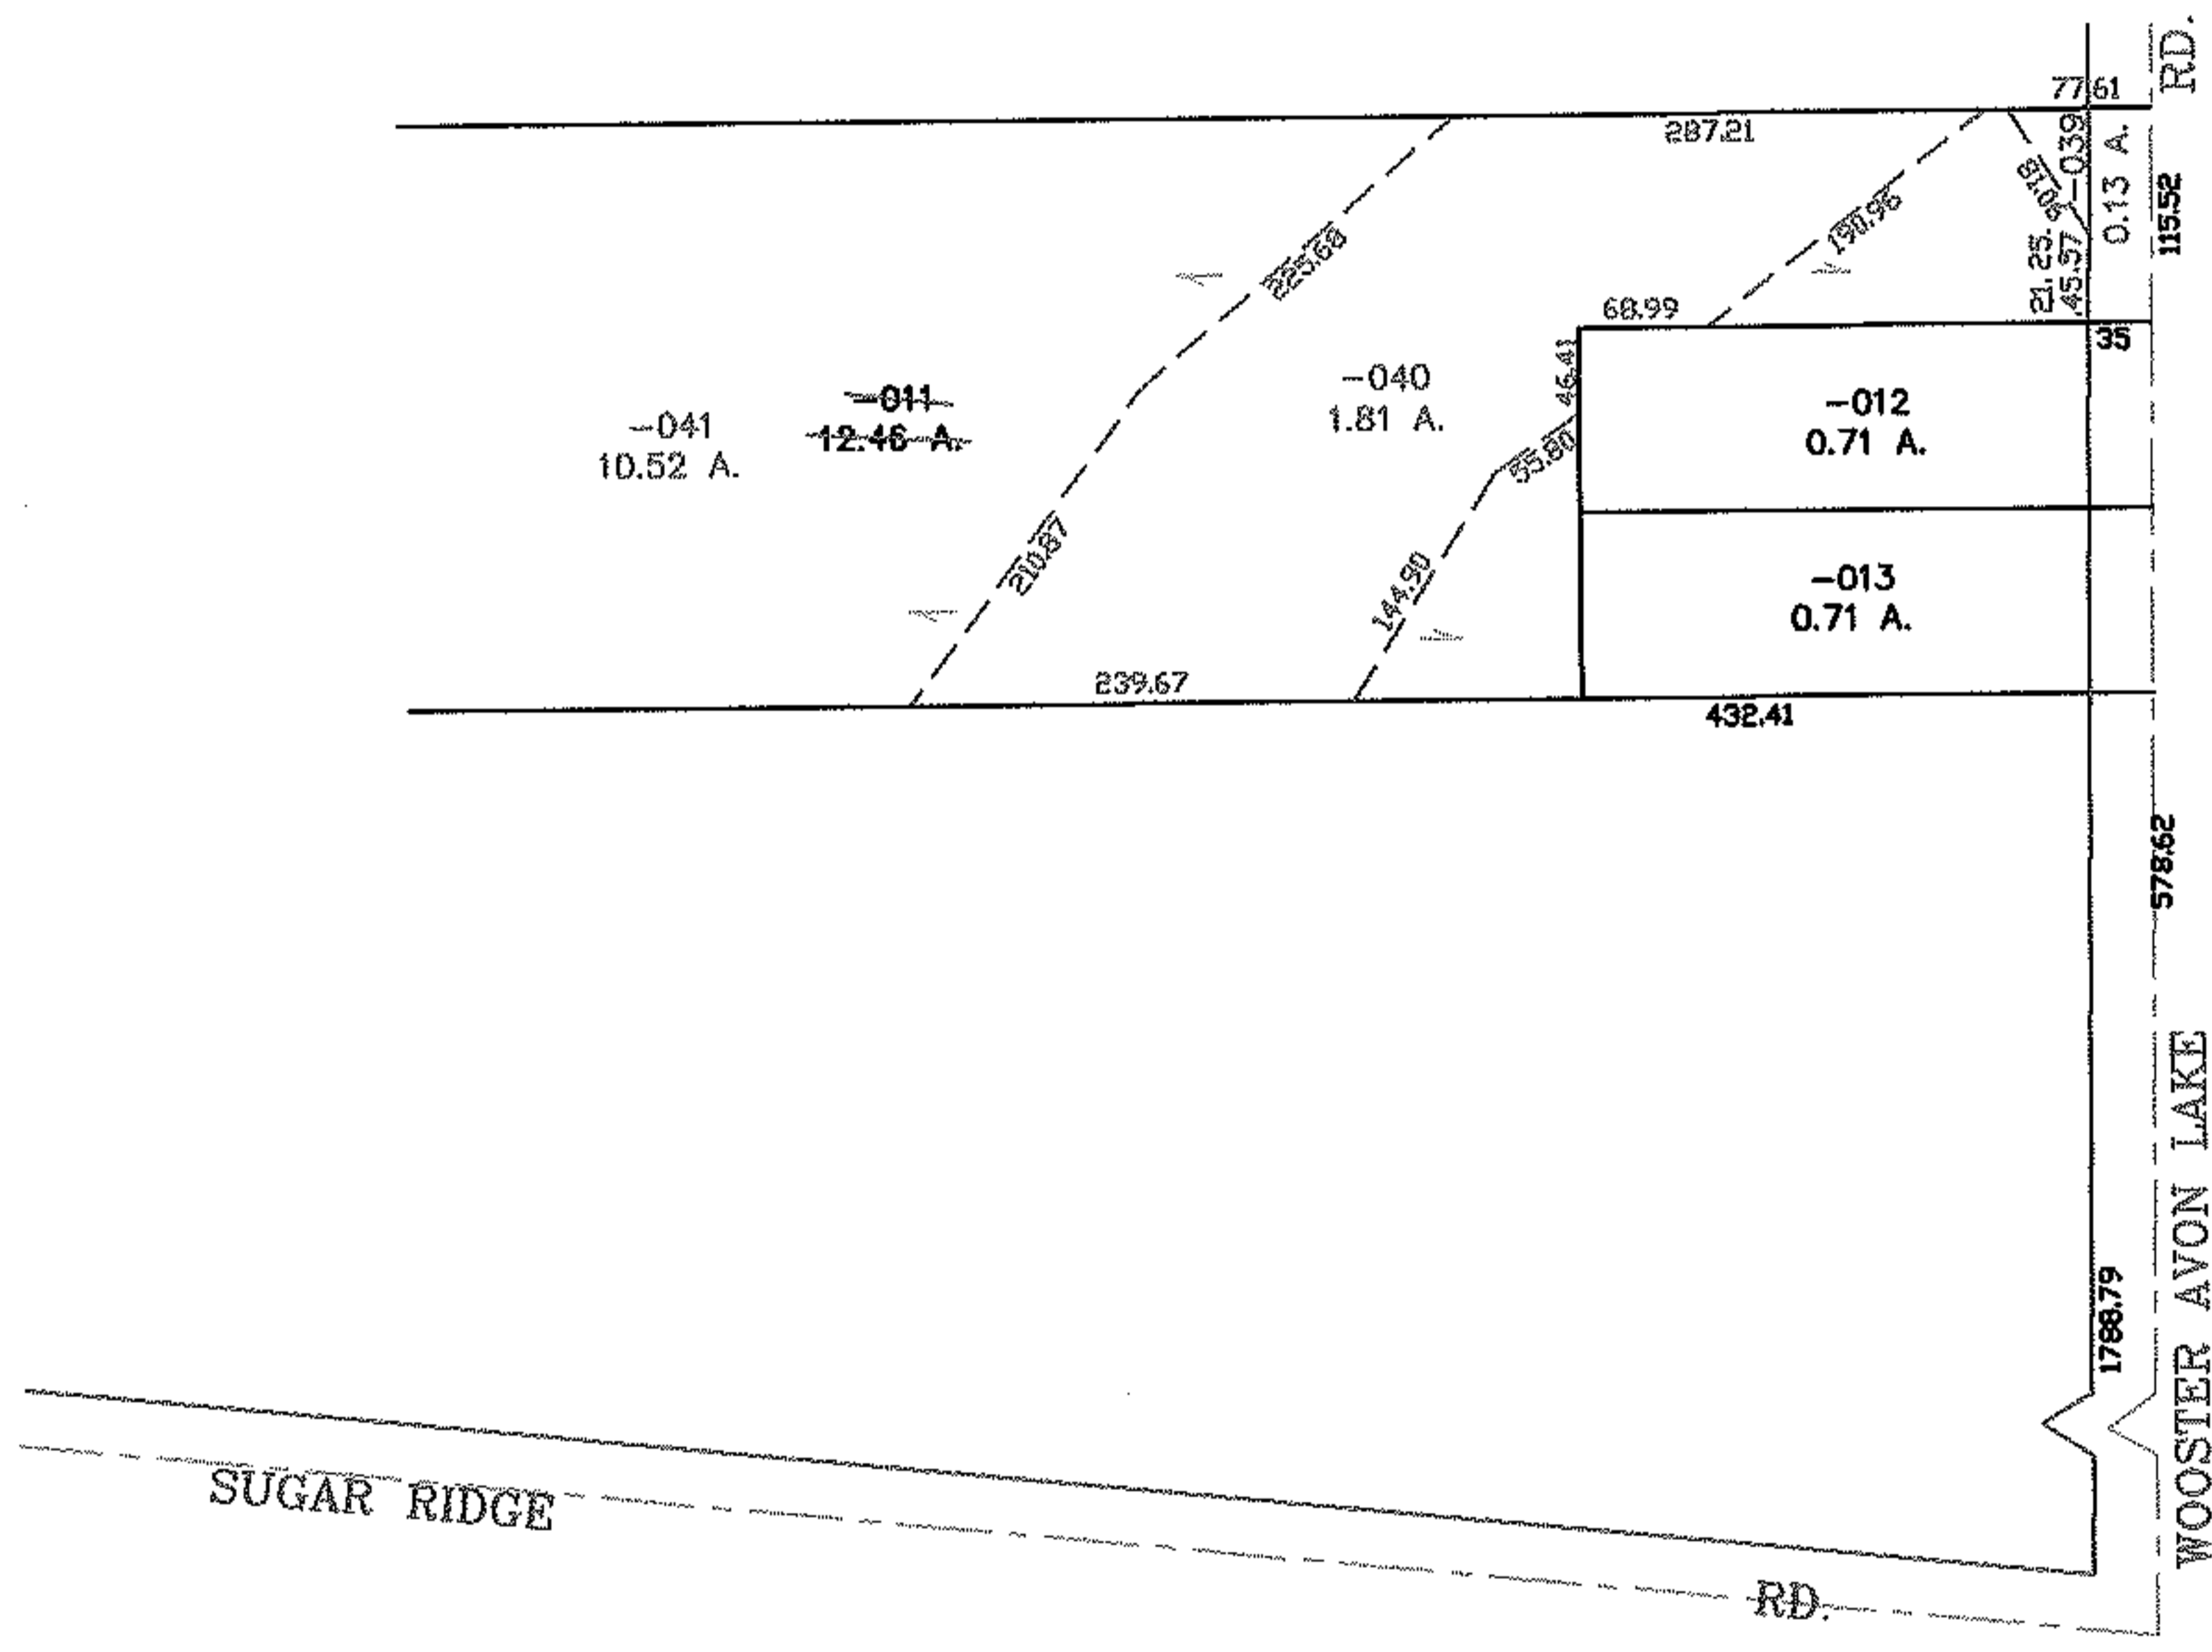


PARENT PARCEL: 07-00-027-109-011
CHILD PARCEL: 07-00-027-109-039 THRU -041
STARTING POINT: CENTERLINE OF SUGAR RIDGE RD. & WOOSTER AVON LAKE RD.

NO. 00109

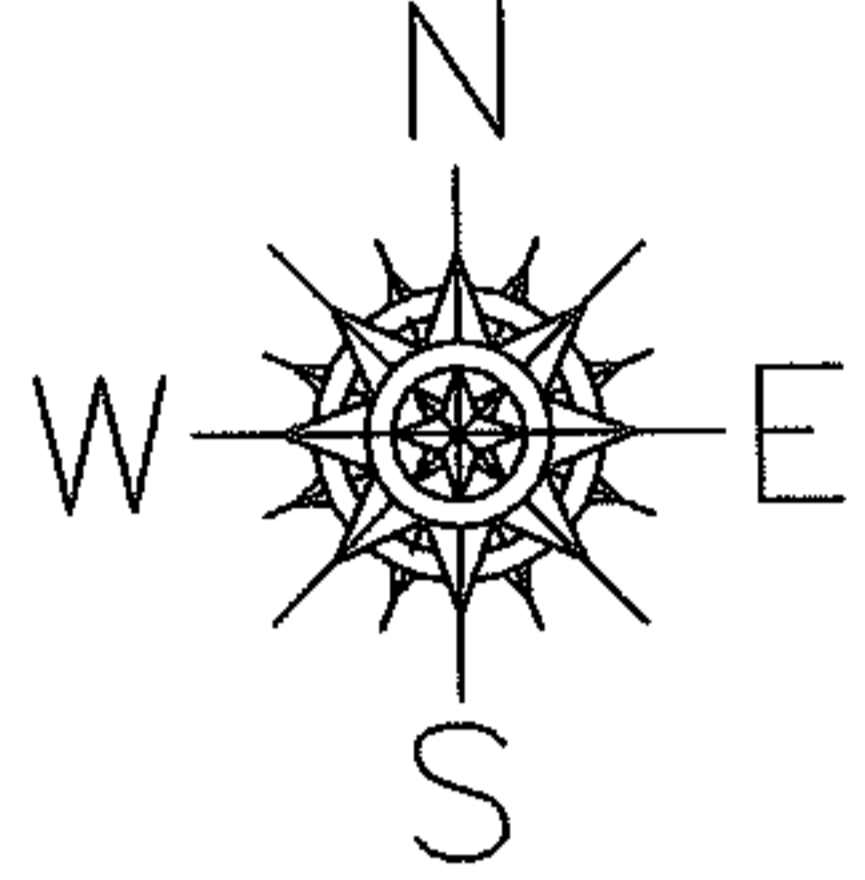

SPLITS/DEEDS PROCESSED
LORAIN COUNTY TAX MAP DEPARTMENT
226 MIDDLE AVE. ELYRIA, OHIO

SURVEYED BY: ROBERT J. MCAULEY
CLOSURE: 0.00 : 10.000
MAP PAGE(S): 07-00-027-D
APPROVED BY: JAH DATE: 5-7-04
SCALE: 1" = 200 PRIOR INSTRUMENT: 19970481621