
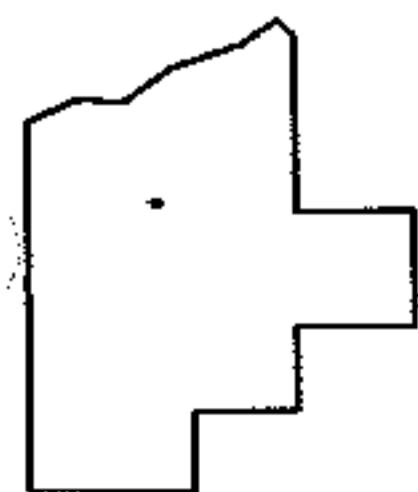
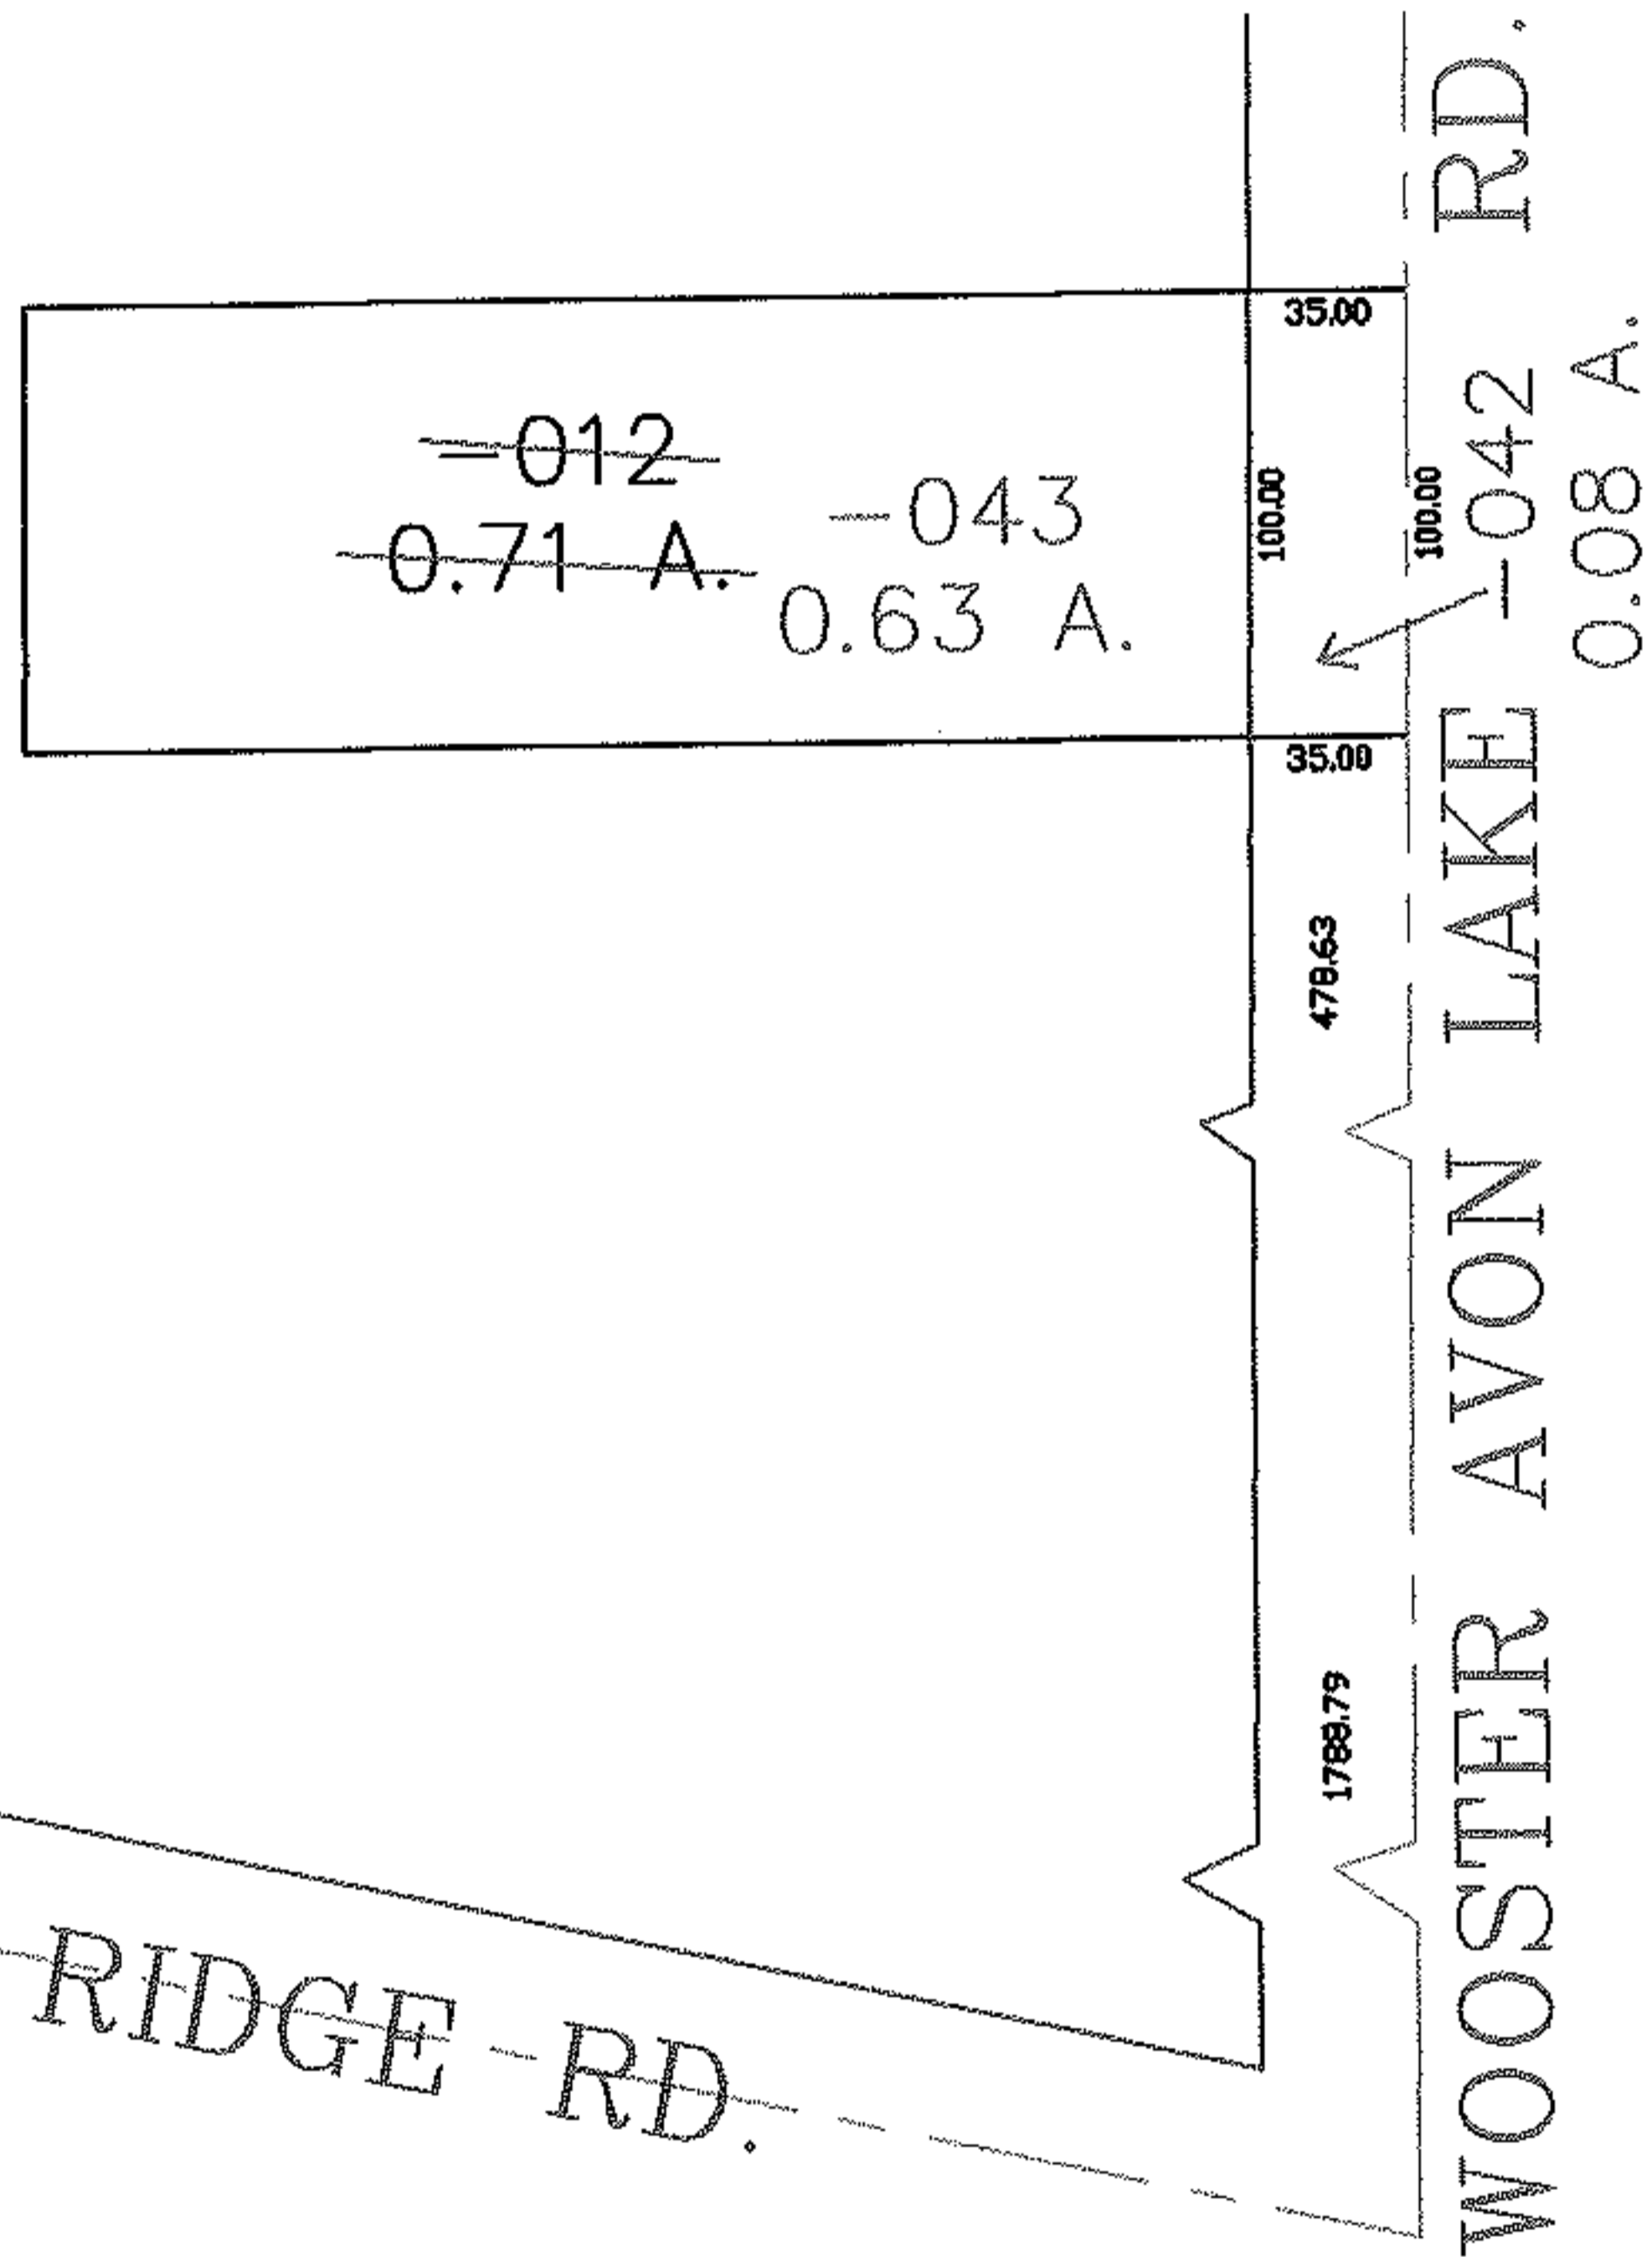


PARENT PARCEL: 07-00-027-109-012

CHILD PARCEL: 07-00-027-109-042, -043

STARTING POINT: CENTERLINE OF SUGAR RIDGE RD. & WOOSTER AVON LAKE RD.

NO. 00110

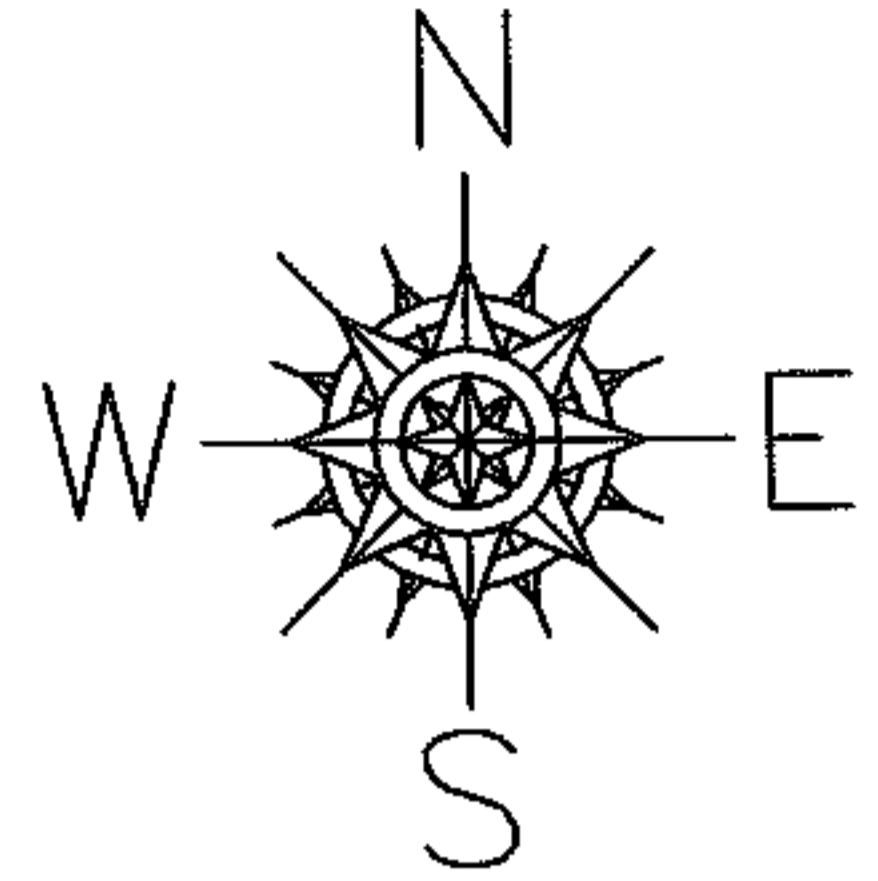

SPLITS/DEEDS PROCESSED

LORAIN COUNTY TAX MAP DEPARTMENT
226 MIDDLE AVE. ELYRIA, OHIO

SURVEYED BY: ROBERT J MCCAULEY

CLOSURE: 0.00 : 10.000

MAP PAGE(S): 07-00-027-D

APPROVED BY: JAH DATE: 5-10-04

SCALE: 1" = 100 PRIOR INSTRUMENT: 19970481622