
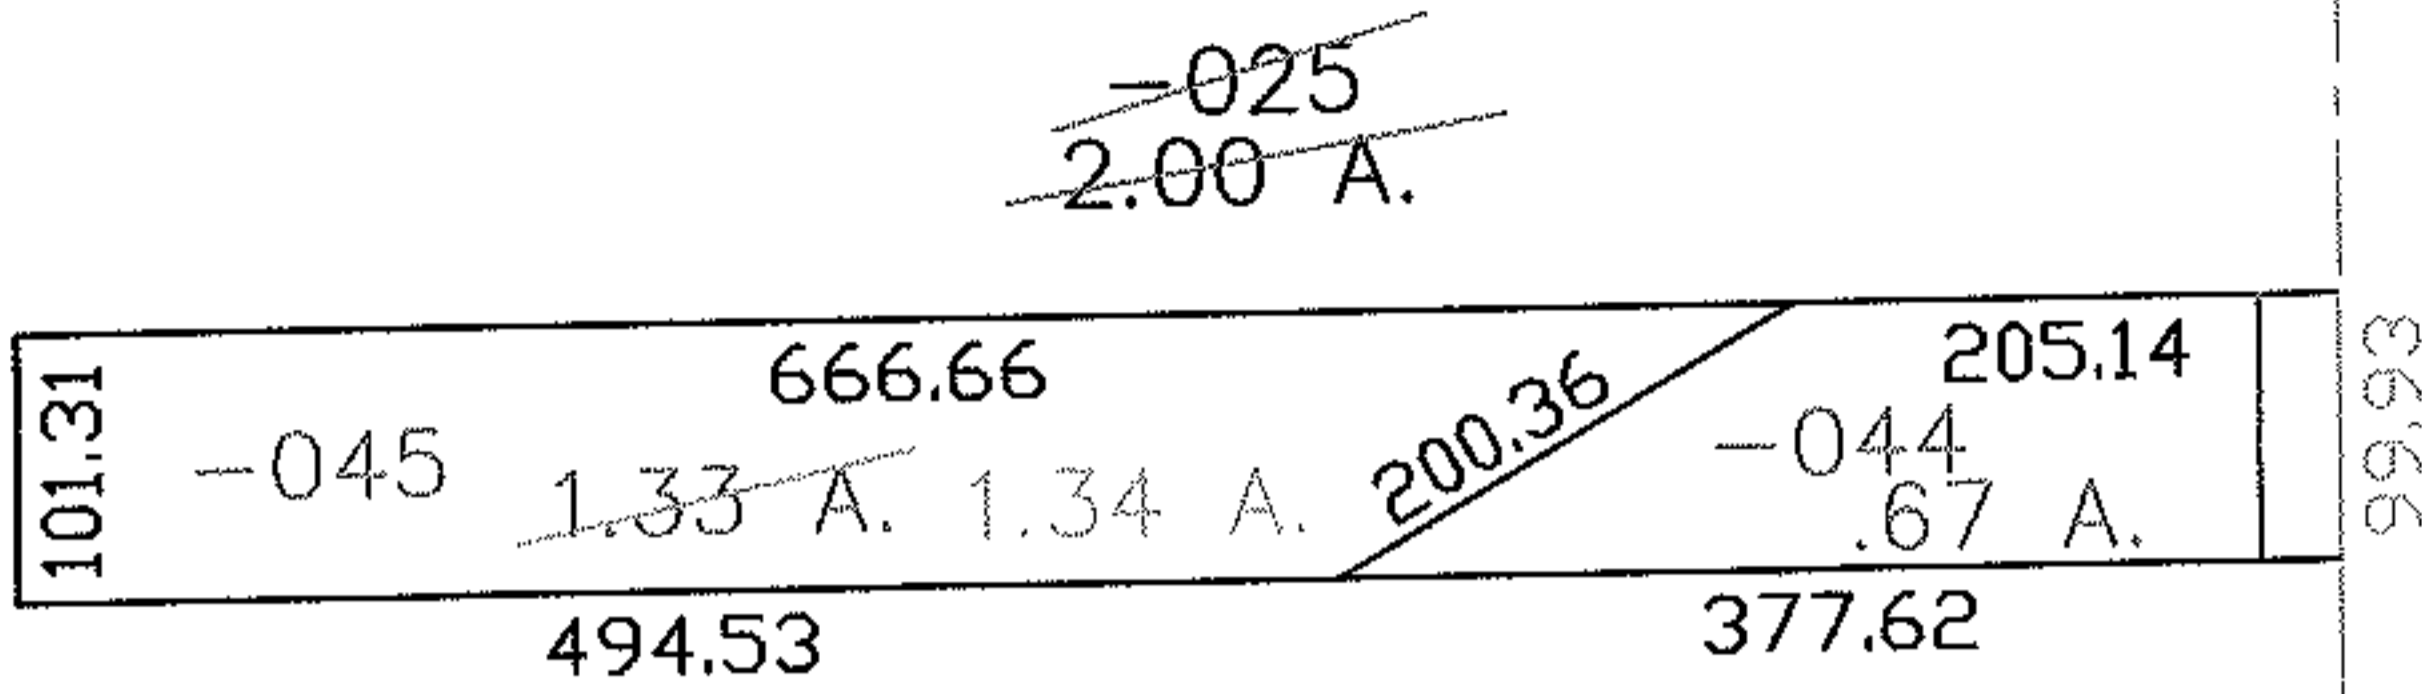


PARENT PARCEL: 07-00-027-109-025
CHILD PARCEL: 07-00-027-109-044, -045
STARTING POINT: INT CL SUGAR RIDGE RD AND S.R. 83

NO. 00111

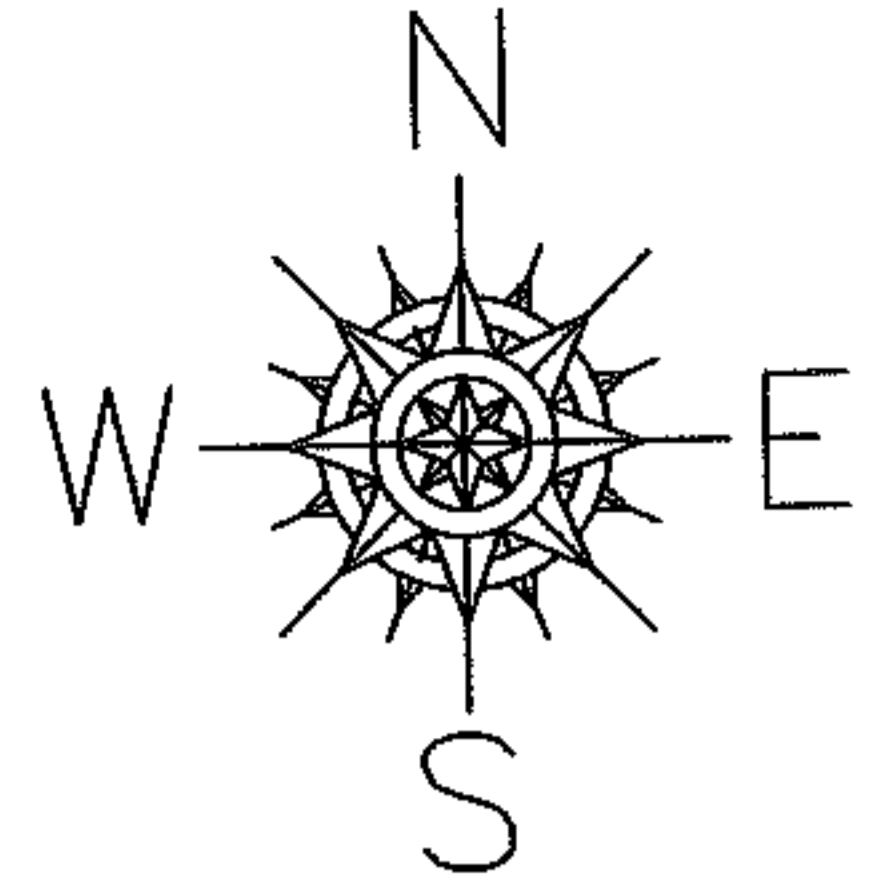

AC. CORR
PER SURVEY
ROBERT J. MCAULEY


99.93

694.14

S.R. 83

1788.79

SUGAR RIDGE RD

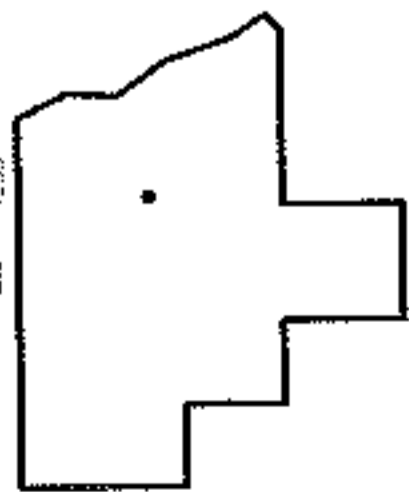

SPLITS/DEEDS PROCESSED
LORAIN COUNTY TAX MAP DEPARTMENT
226 MIDDLE AVE. ELYRIA, OHIO

SURVEYED BY: ROBERT J. MCAULEY
CLOSURE: 1:10,000
MAP PAGE(S): 07-00-027-D
APPROVED BY: JAH DATE: 5/11/2004
SCALE: 1" = 200 PRIOR INSTRUMENT: OR 391/53