
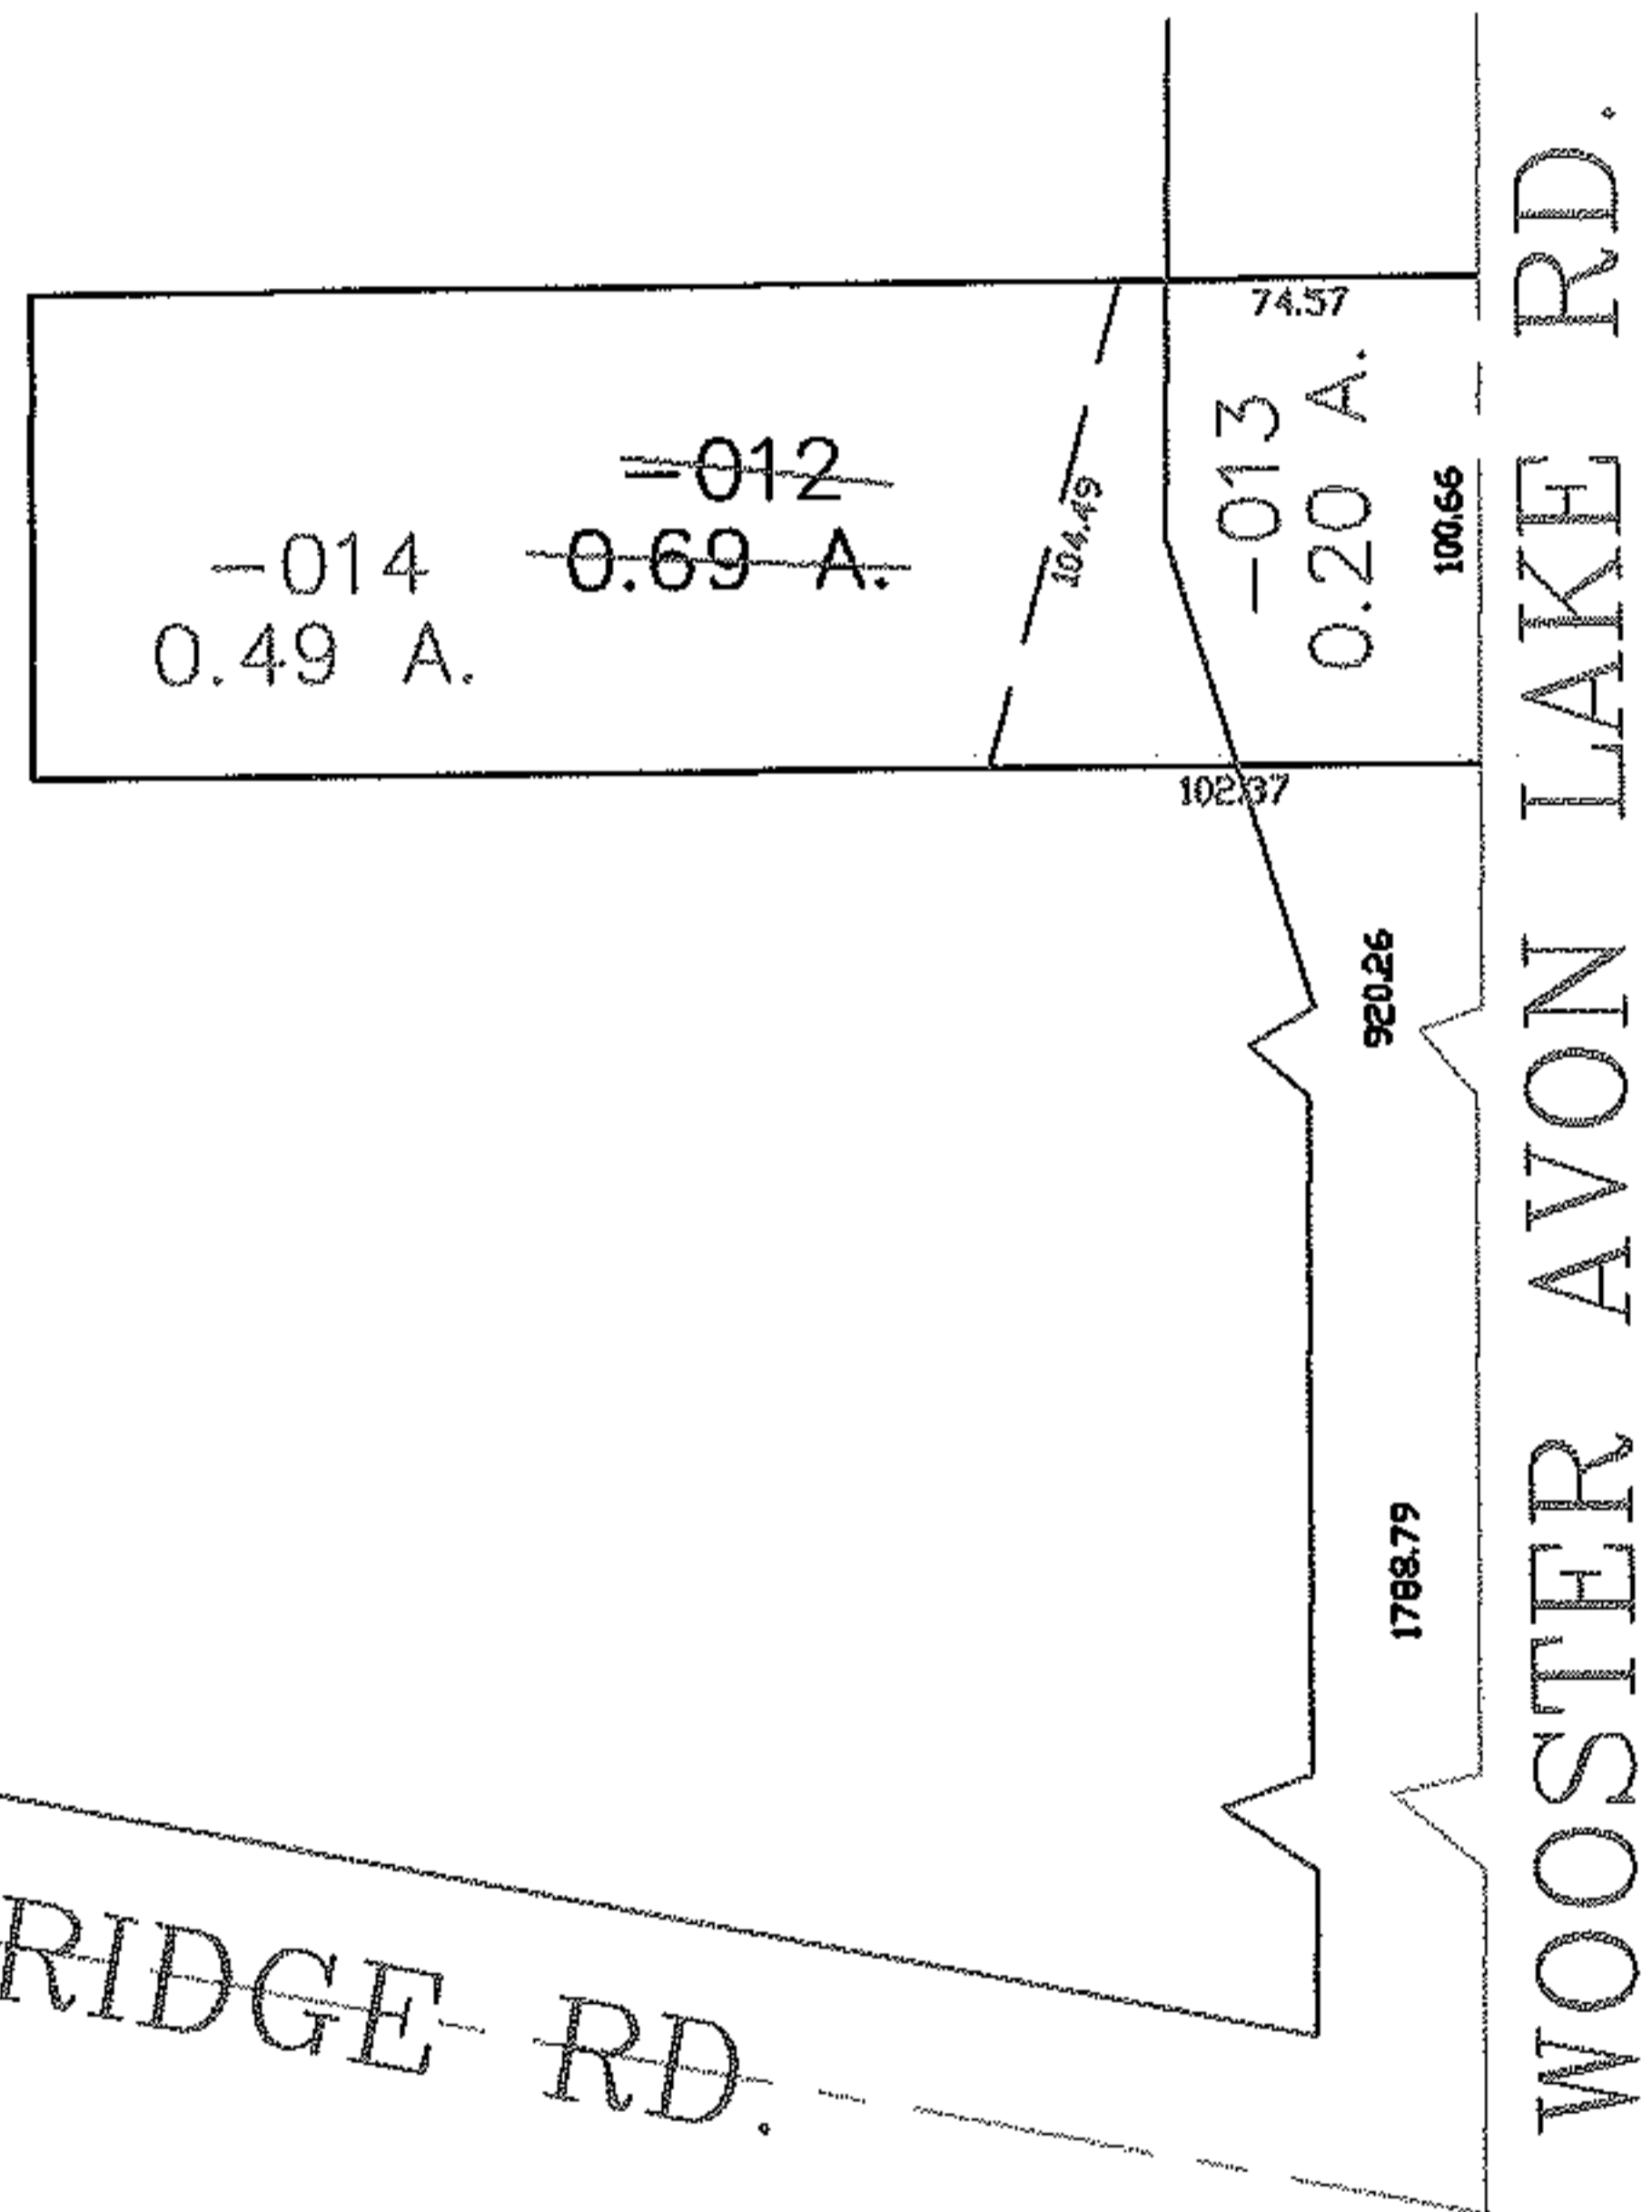


PARENT PARCEL: 07-00-027-108-012

CHILD PARCEL: 07-00-027-108-013, -014

STARTING POINT: CENTERLINE OF SUGAR RIDGE RD. & WOOSTER AVON LAKE RD.

NO. 00112

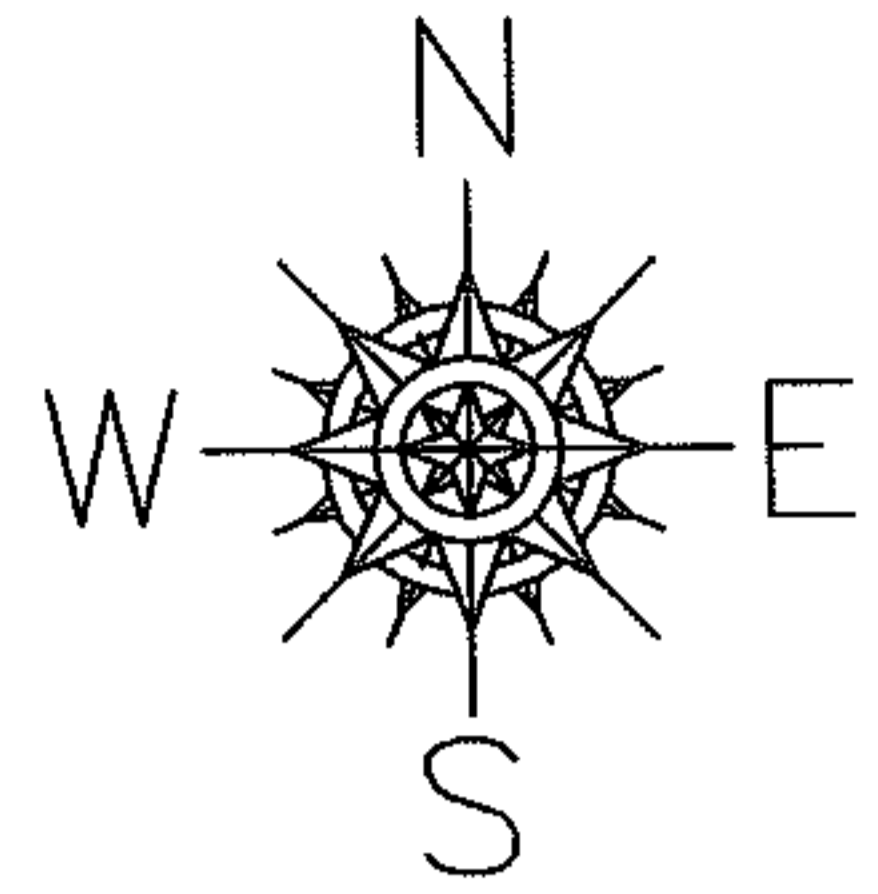

SPLITS/DEEDS PROCESSED

LORAIN COUNTY TAX MAP DEPARTMENT
226 MIDDLE AVE. ELYRIA, OHIO

SURVEYED BY: ROBERT J. MCAULEY

CLOSURE: 0.00 ; 10,000

MAP PAGE(S): 07-00-027-D

APPROVED BY: JAH DATE: 5-12-04

SCALE: 1" = 100 PRIOR INSTRUMENT: 20020700085