
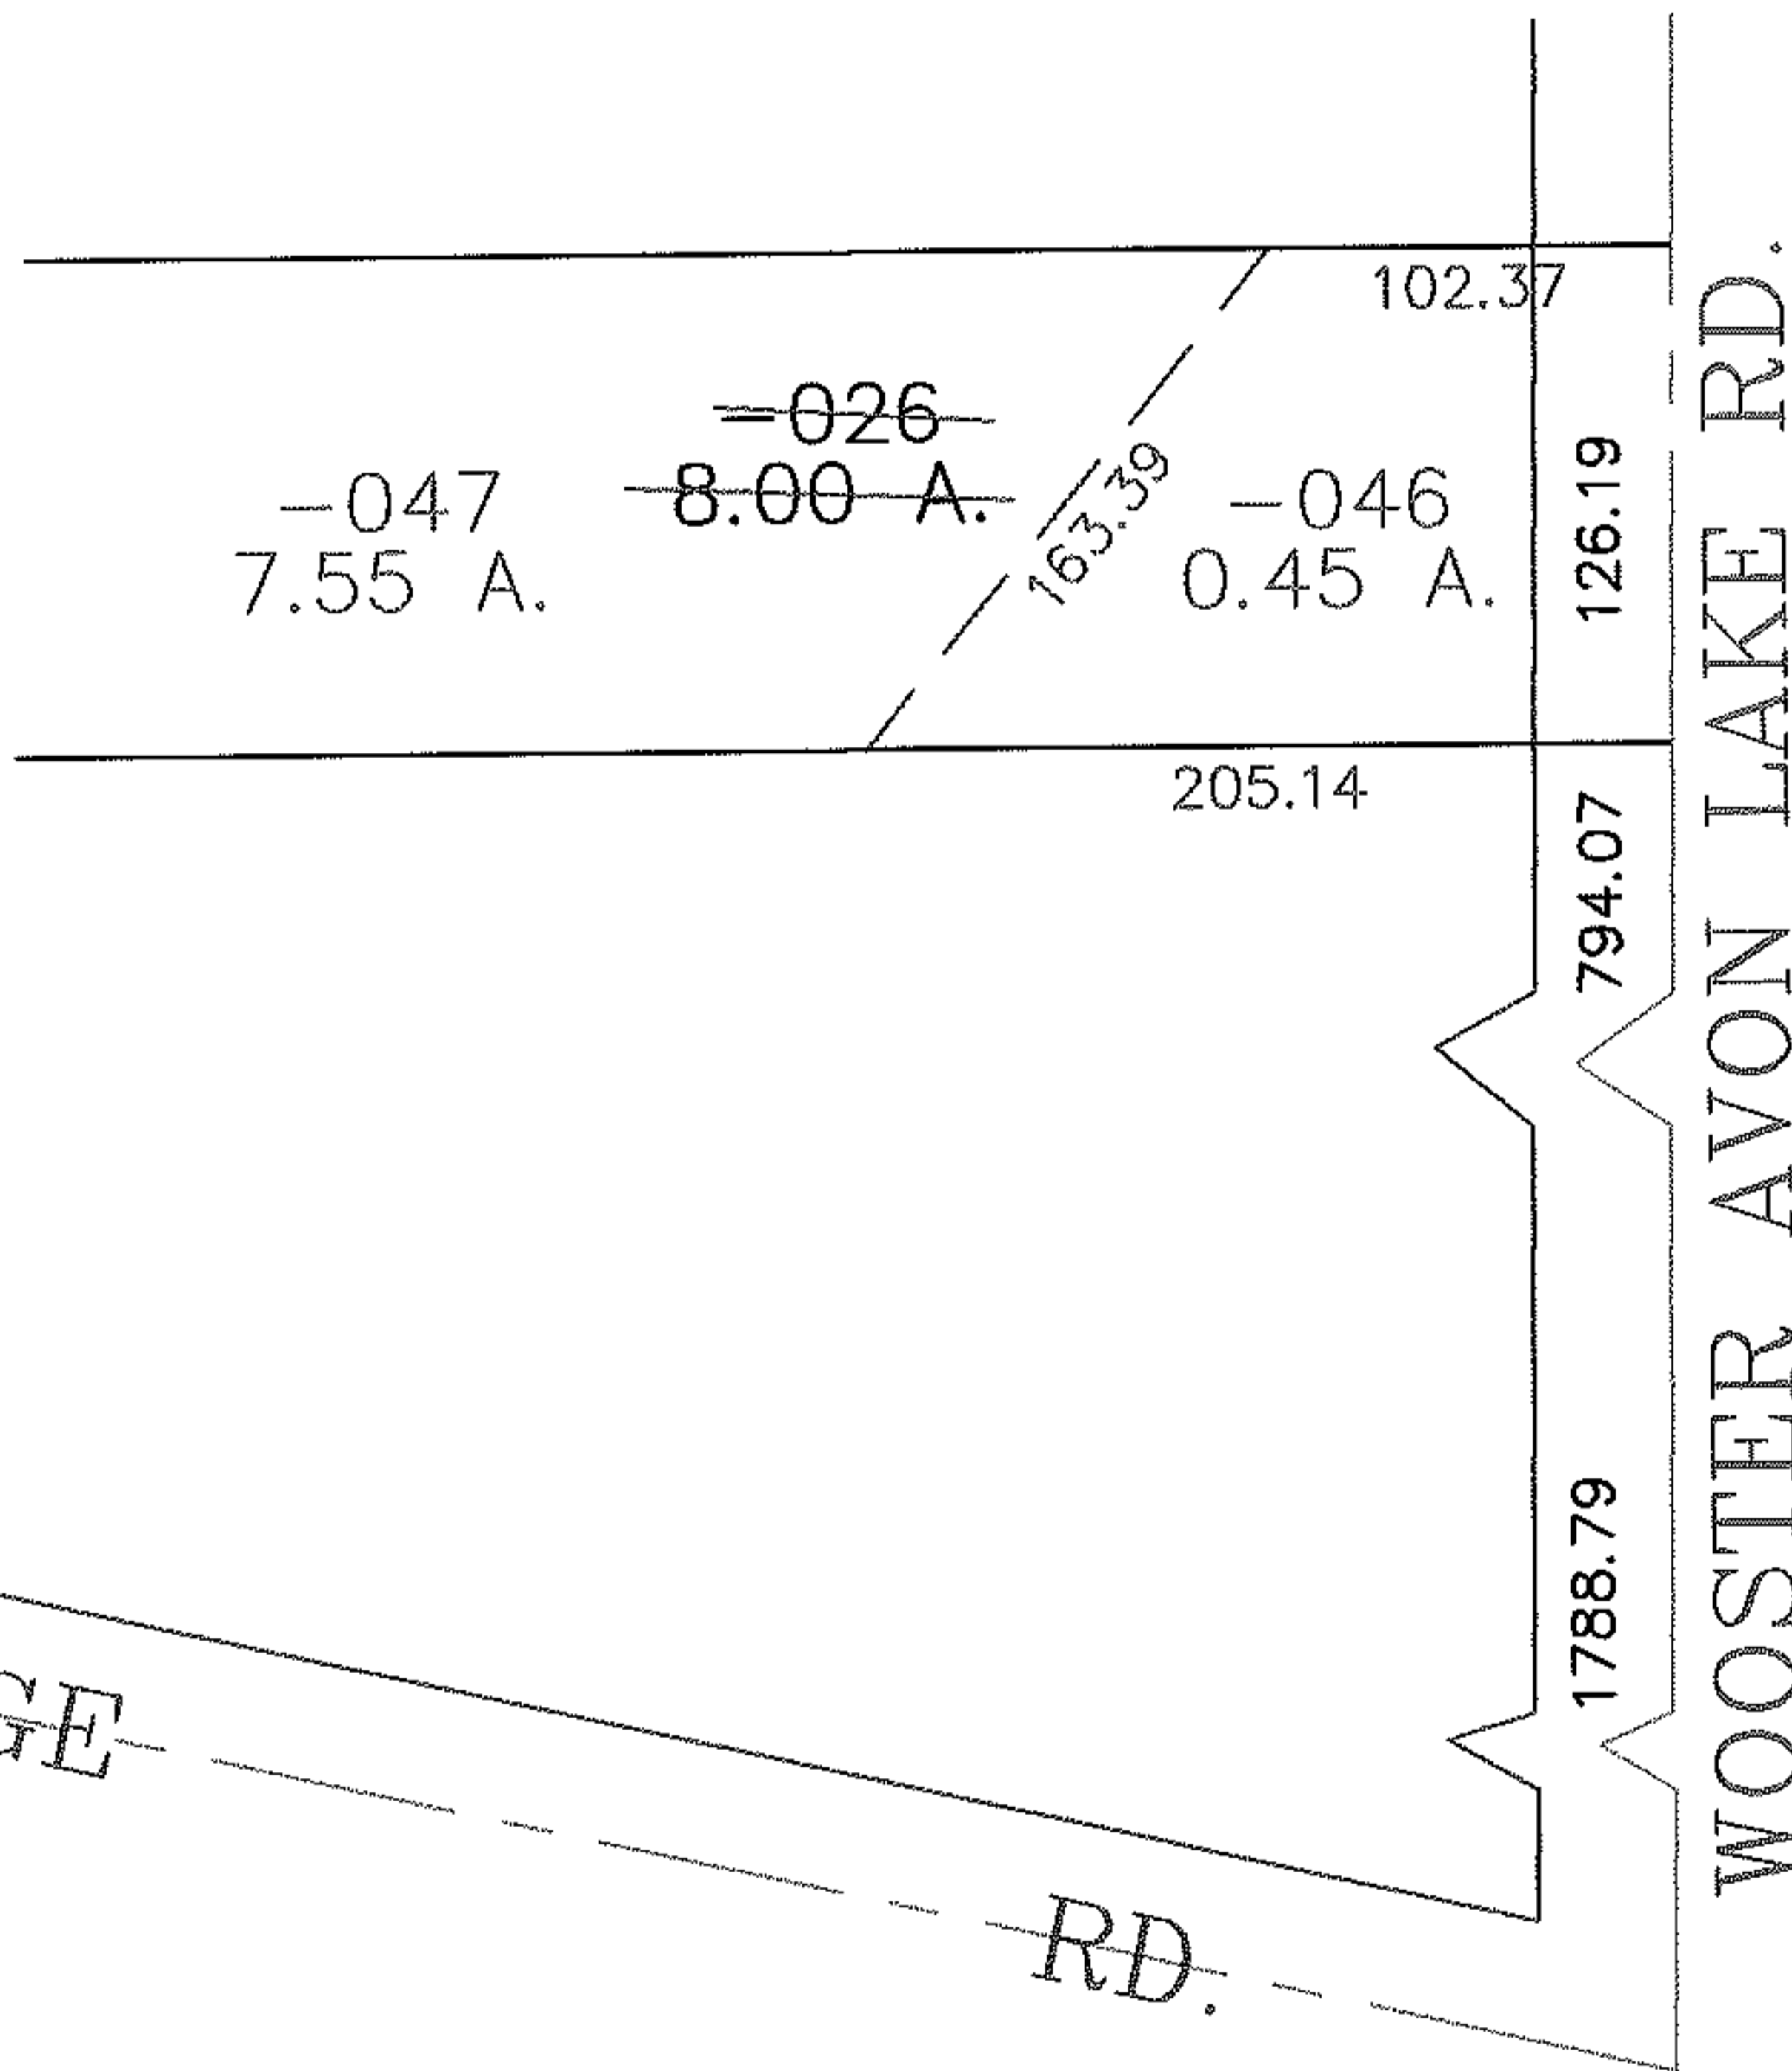


PARENT PARCEL: 07-00-027-109-026

CHILD PARCEL: 07-00-027-109-046, -047

STARTING POINT: CENTERLINES OF SUGAR RIDGE RD. & WOOSTER AVON LAKE RD.


NO. 00113

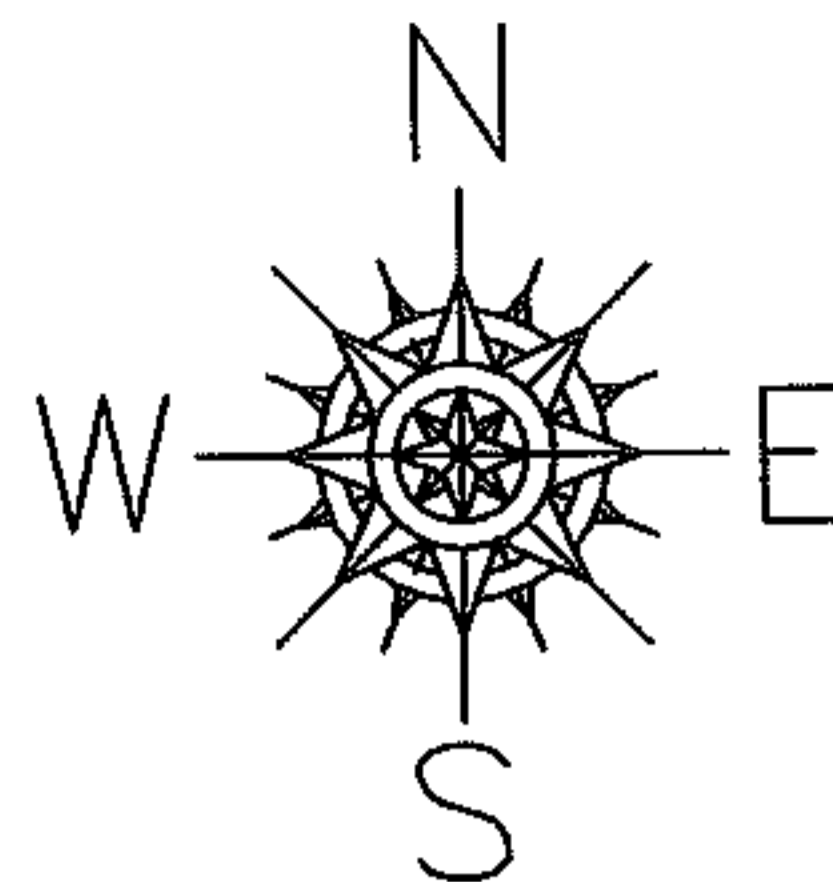

SUGAR RIDGE

RD.

WOOSTER AVON LAKE RD.

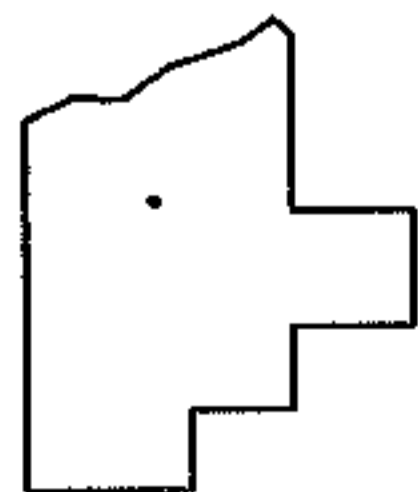

SPLITS/DEEDS PROCESSED

LORAIN COUNTY TAX MAP DEPARTMENT
226 MIDDLE AVE. ELYRIA, OHIO

SURVEYED BY: ROBERT J. MCAULEY

CLOSURE: 0.00 : 10.000

MAP PAGE(S): 07-00-027-D

APPROVED BY: JAH DATE: 5-11-04

SCALE: 1" = 100' PRIOR INSTRUMENT: 19990593715