
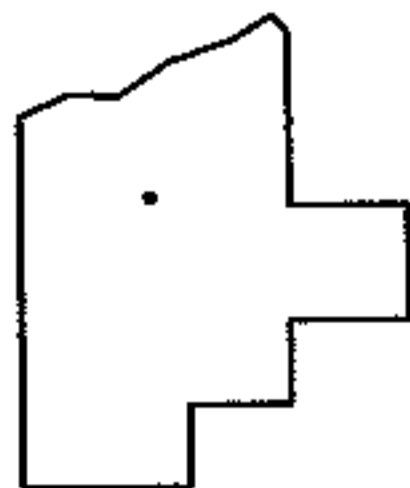
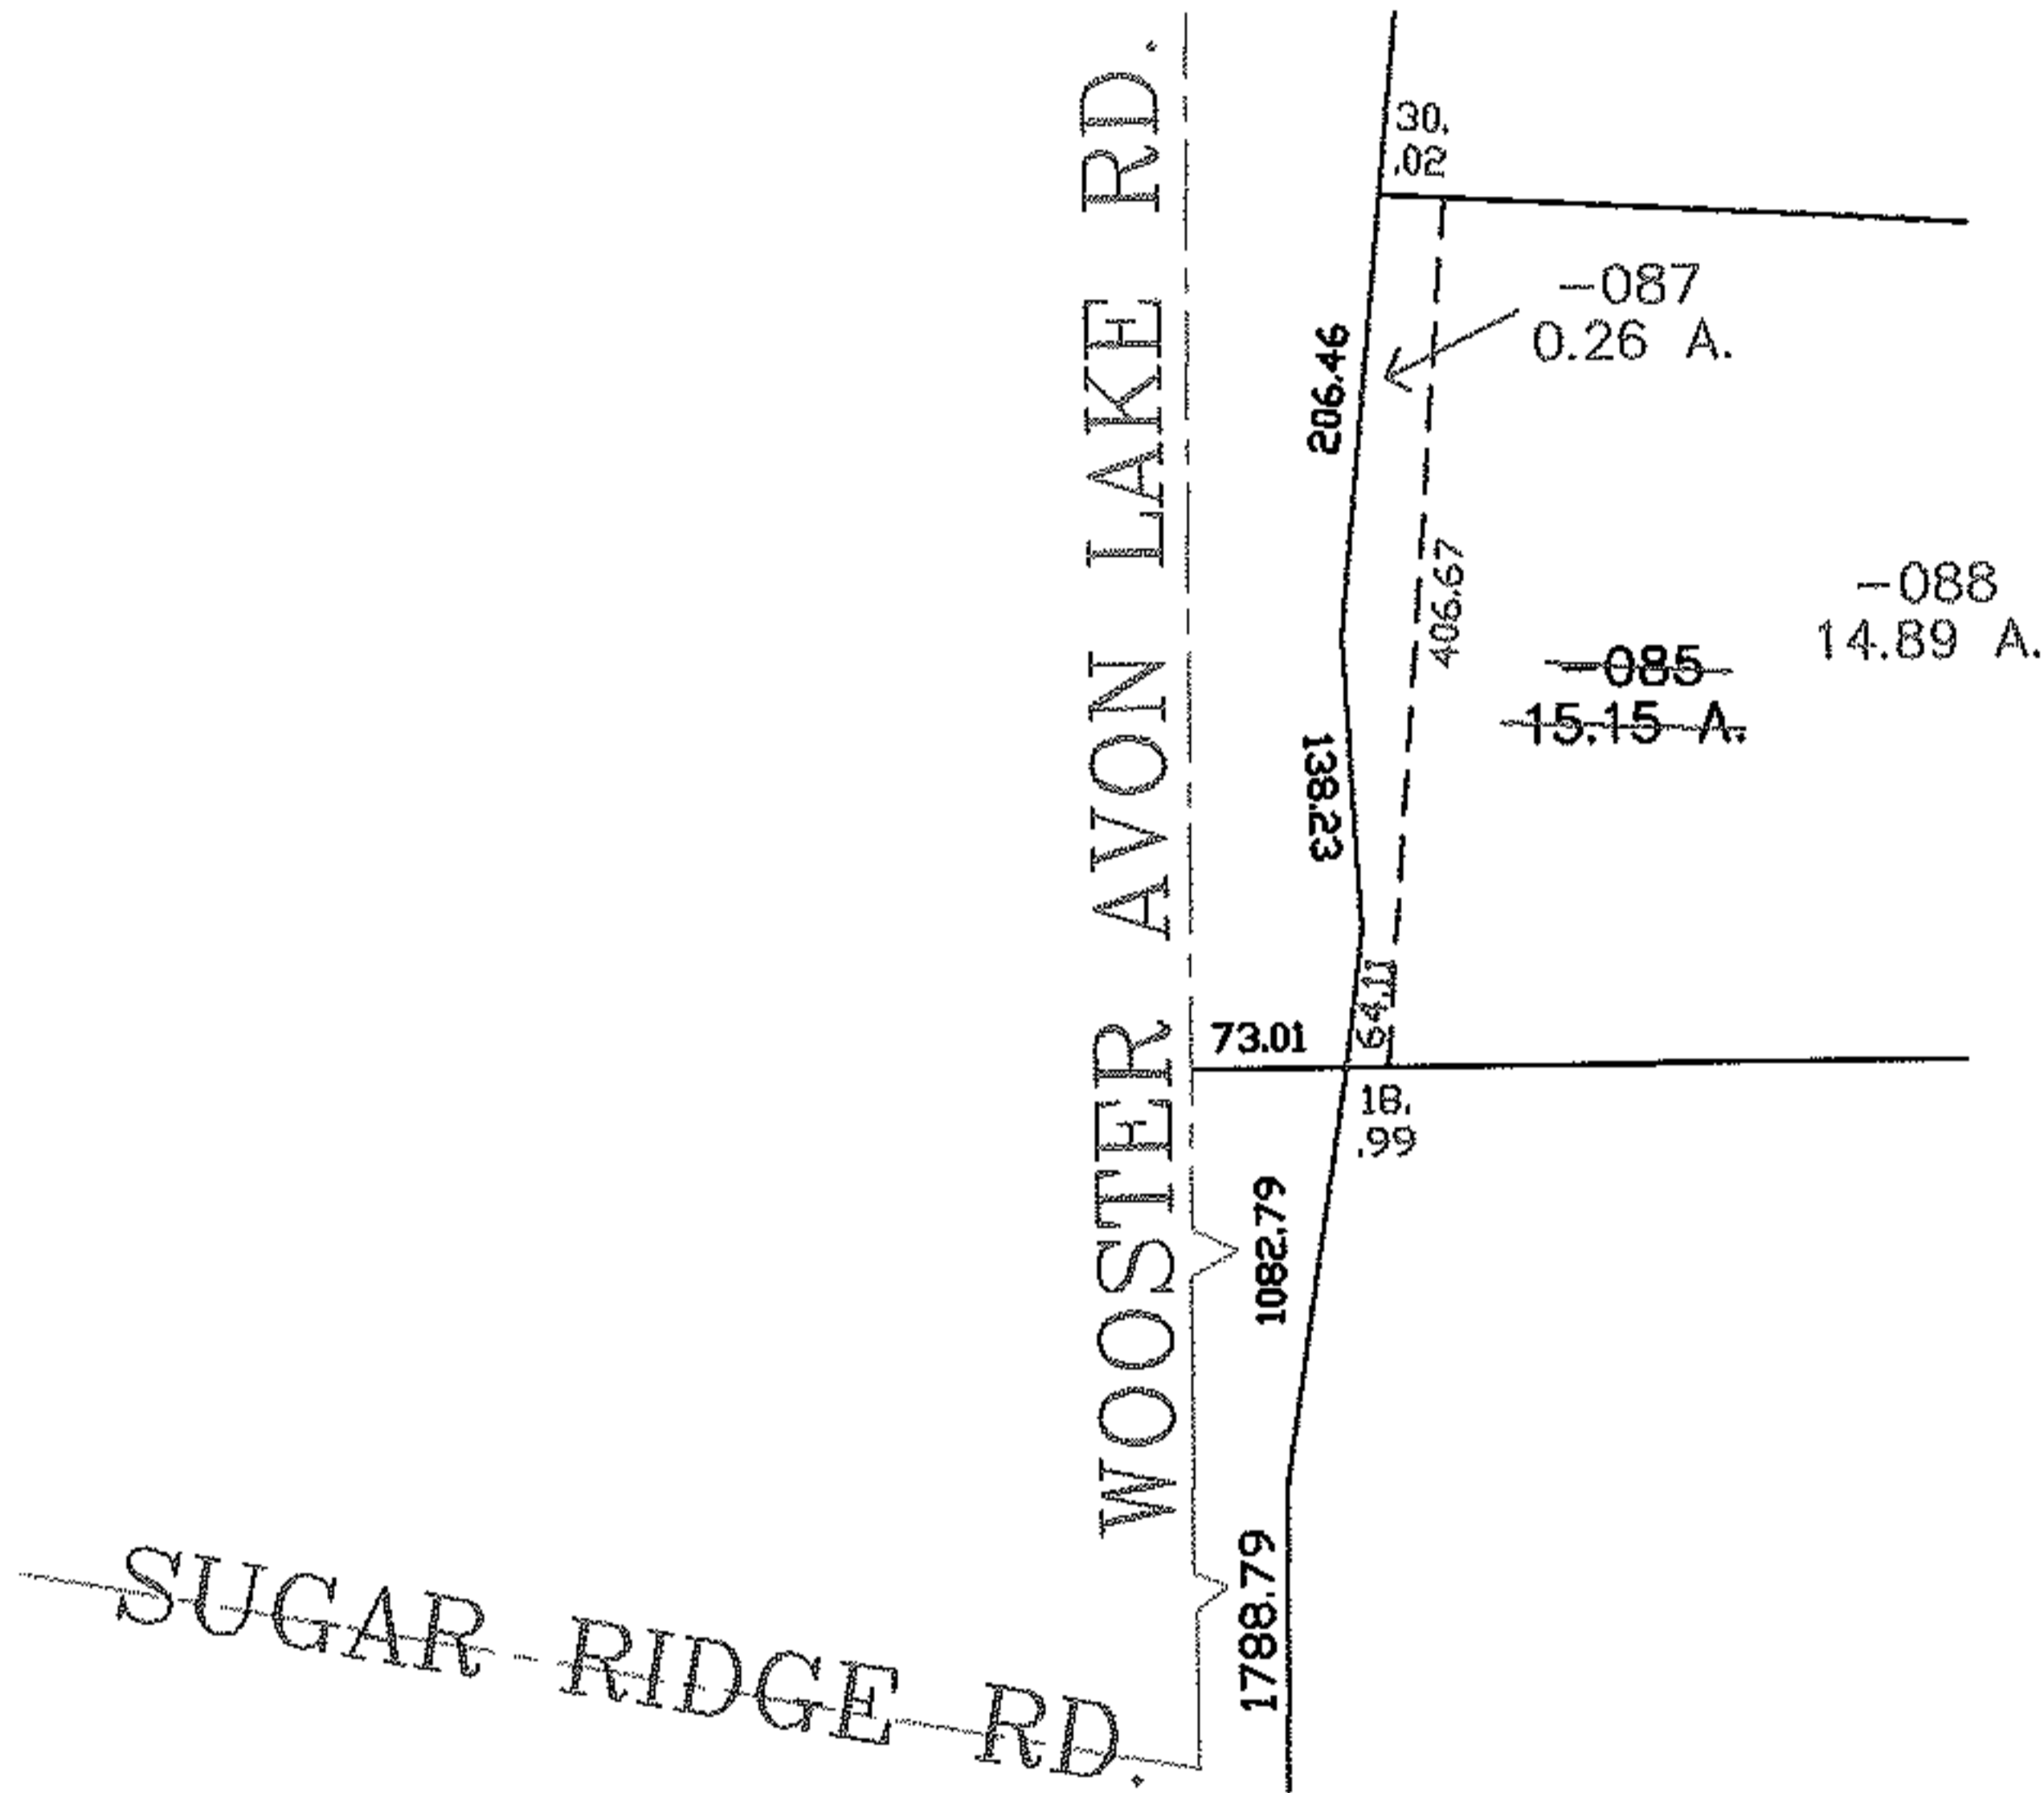


PARENT PARCEL: 07-00-022-101-085

CHILD PARCEL: 07-00-022-101-087, -088

STARTING POINT: CENTERLINE OF WOOSTER AVON LAKE RD. & SUGAR RIDGE RD.

NO. 00114

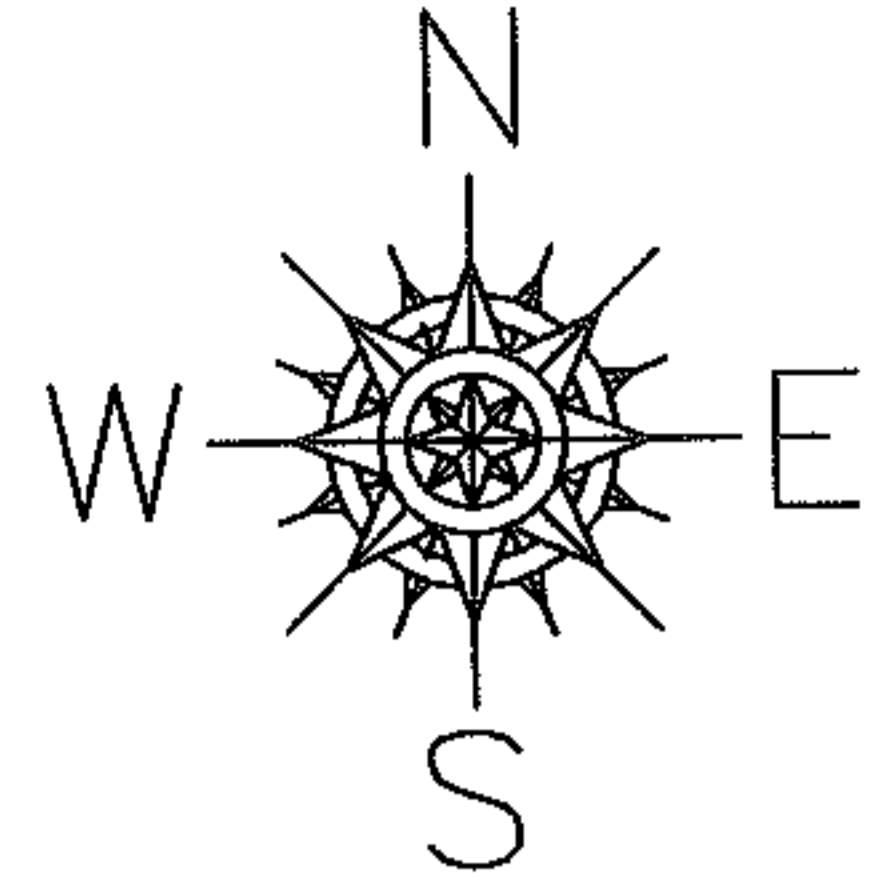

SPLITS/DEEDS PROCESSED
LORAIN COUNTY TAX MAP DEPARTMENT
 226 MIDDLE AVE. ELYRIA, OHIO

SURVEYED BY: ROBERT J. MCAULEY
 CLOSURE: 0.00 : 10.000
 MAP PAGE(S): 7-00-022-C
 APPROVED BY: JAH DATE: 5-12-04
 SCALE: 1" = 200 PRIOR INSTRUMENT: 20030881023