
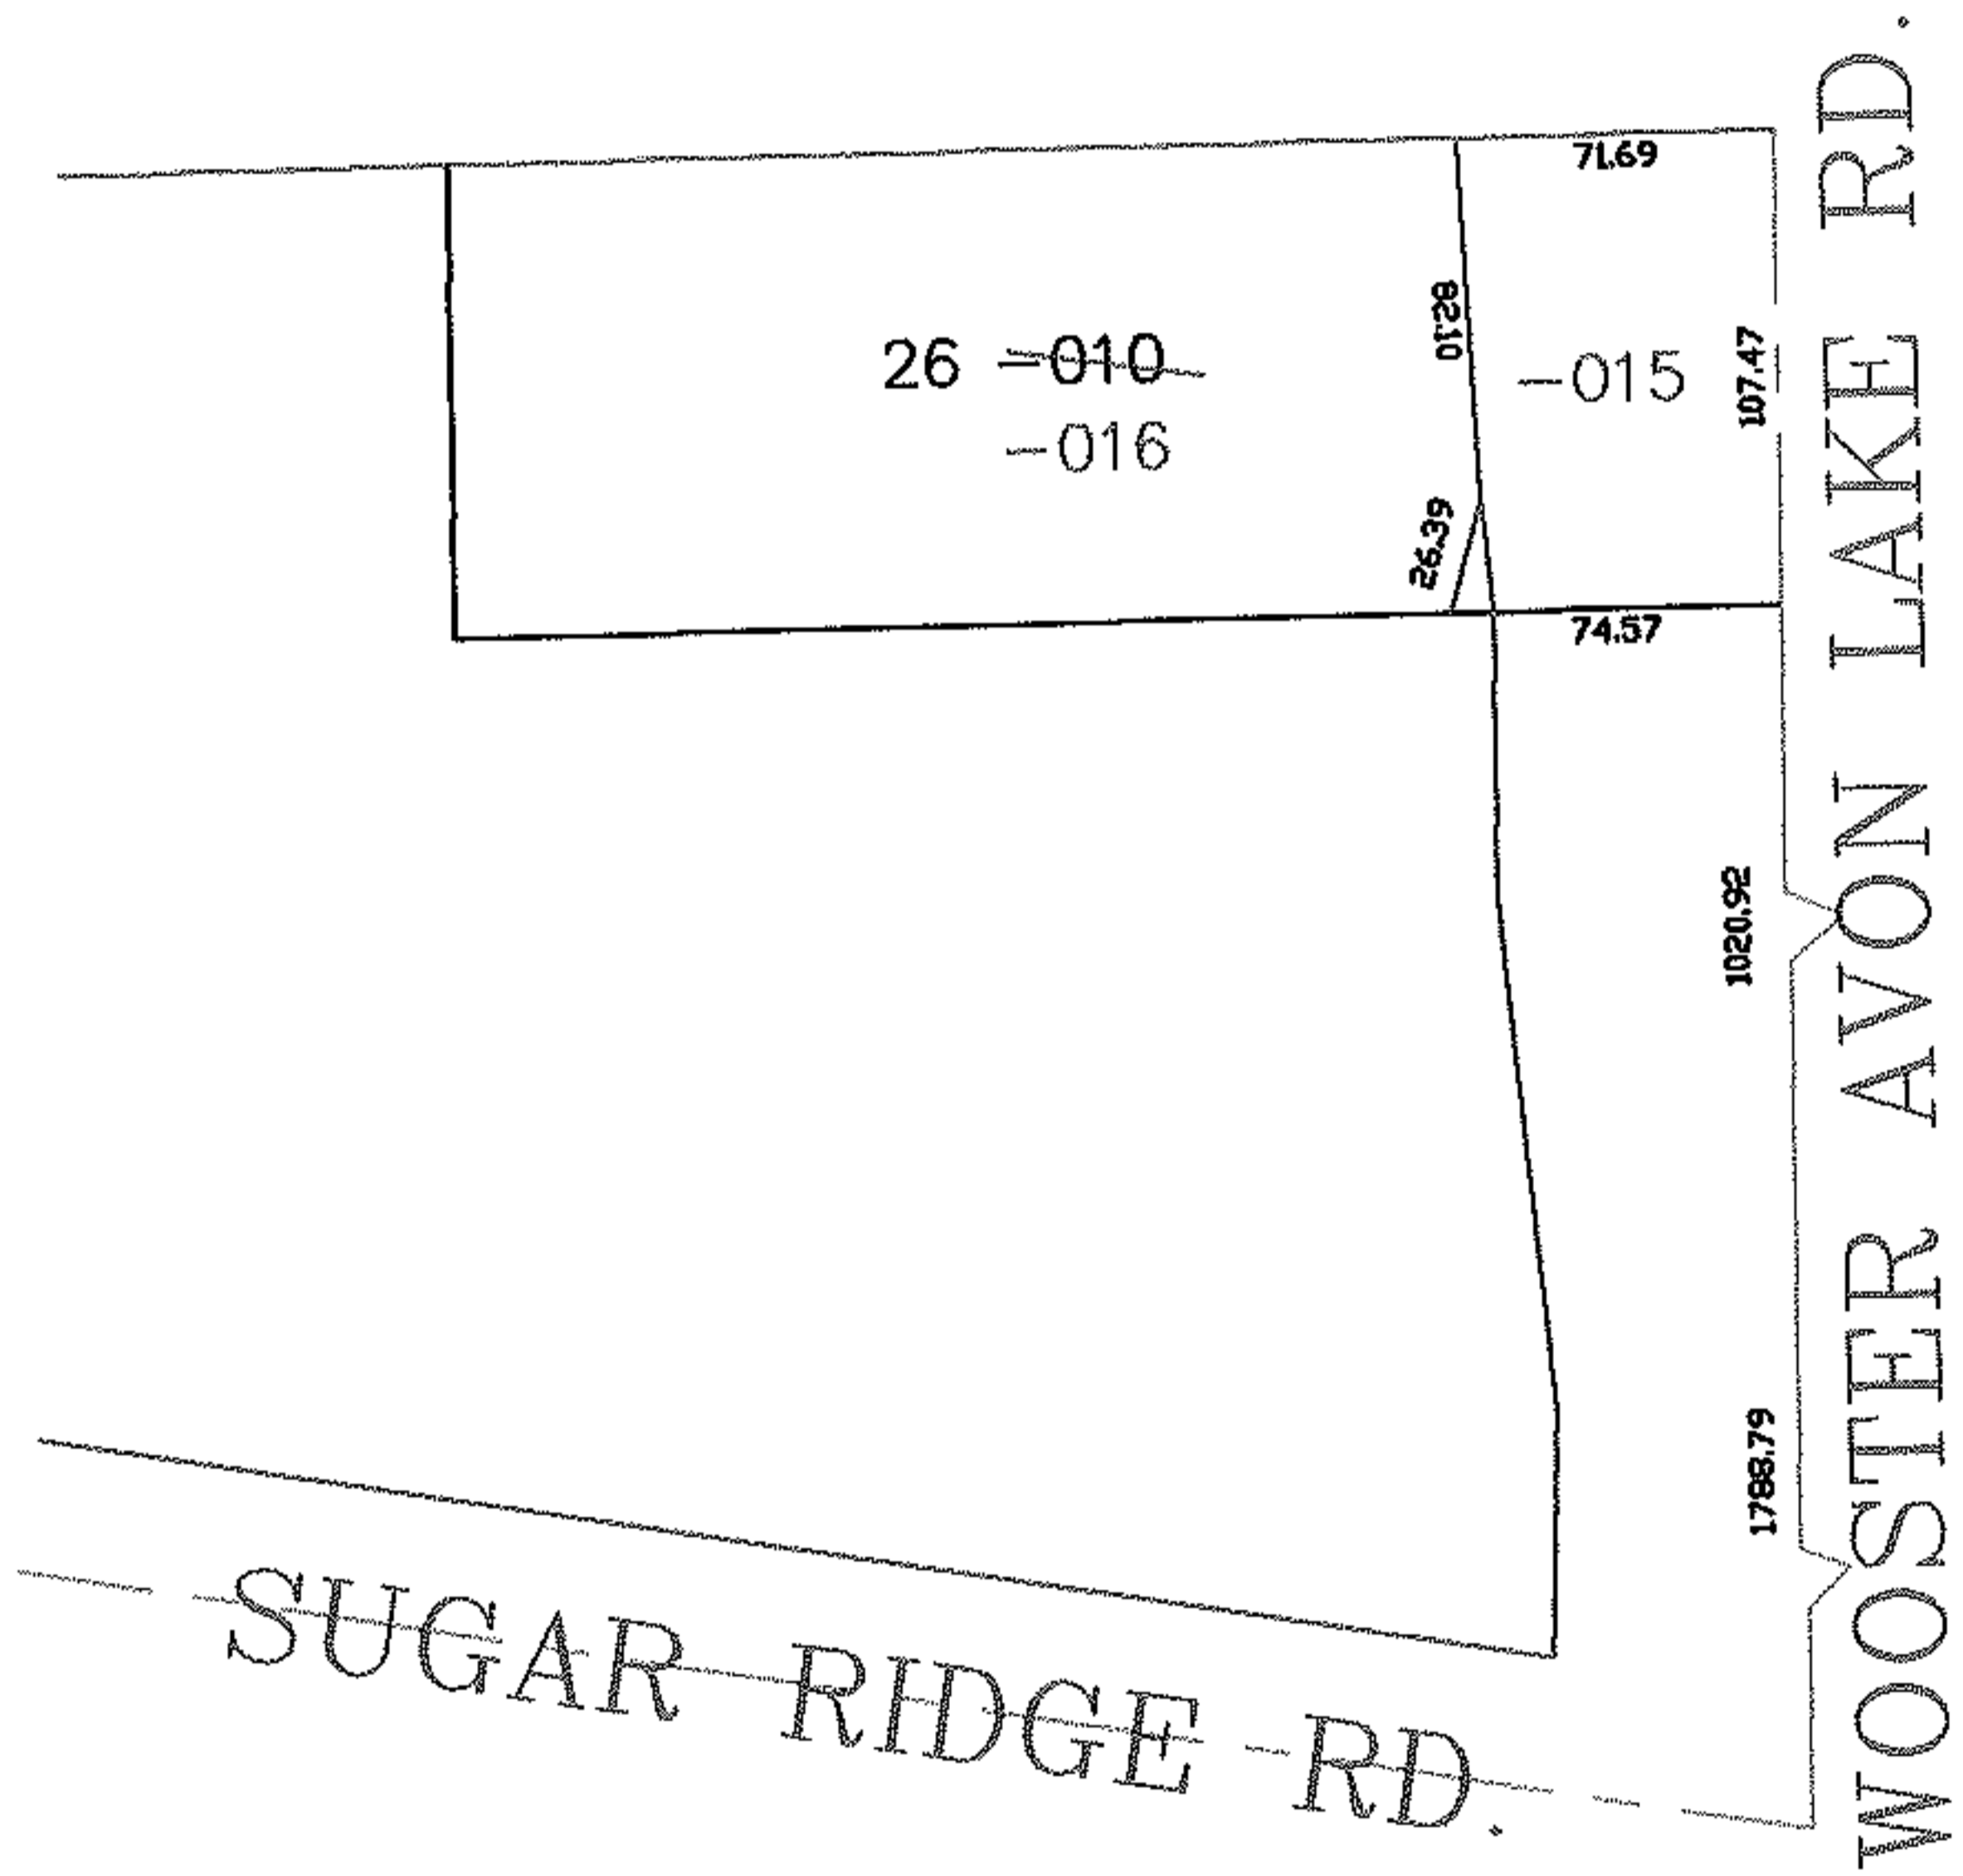


PARENT PARCEL: 07-00-027-108-010

CHILD PARCEL: 07-00-027-108-015, -016

STARTING POINT: CENTERLINES OF SUGAR RIDGE RD. & WOOSTER AVON LAKE RD.

NO. 00115

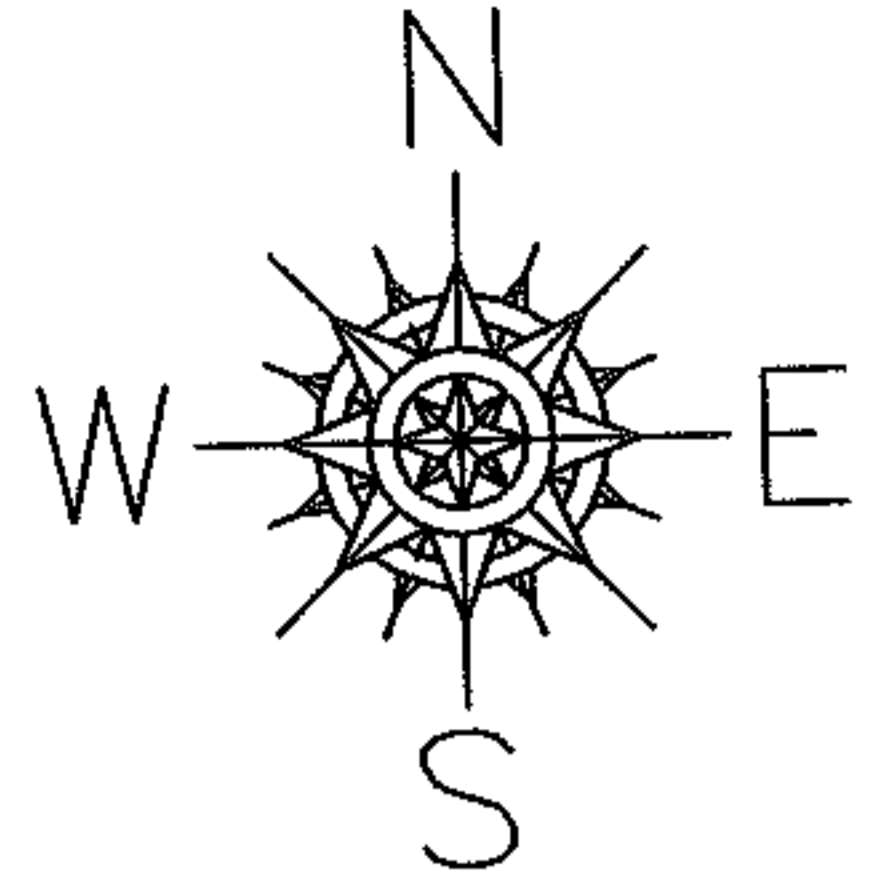

**SPLITS/DEEDS PROCESSED**

LORAIN COUNTY TAX MAP DEPARTMENT  
226 MIDDLE AVE. ELYRIA, OHIO

SURVEYED BY: ROBERT J. MCAULEY

CLOSURE: 0.00 : 10.000

MAP PAGE(S): 07-00-027-D

APPROVED BY: JAH DATE: 5-12-04

SCALE: 1" = 100 PRIOR INSTRUMENT: OR 436/929