
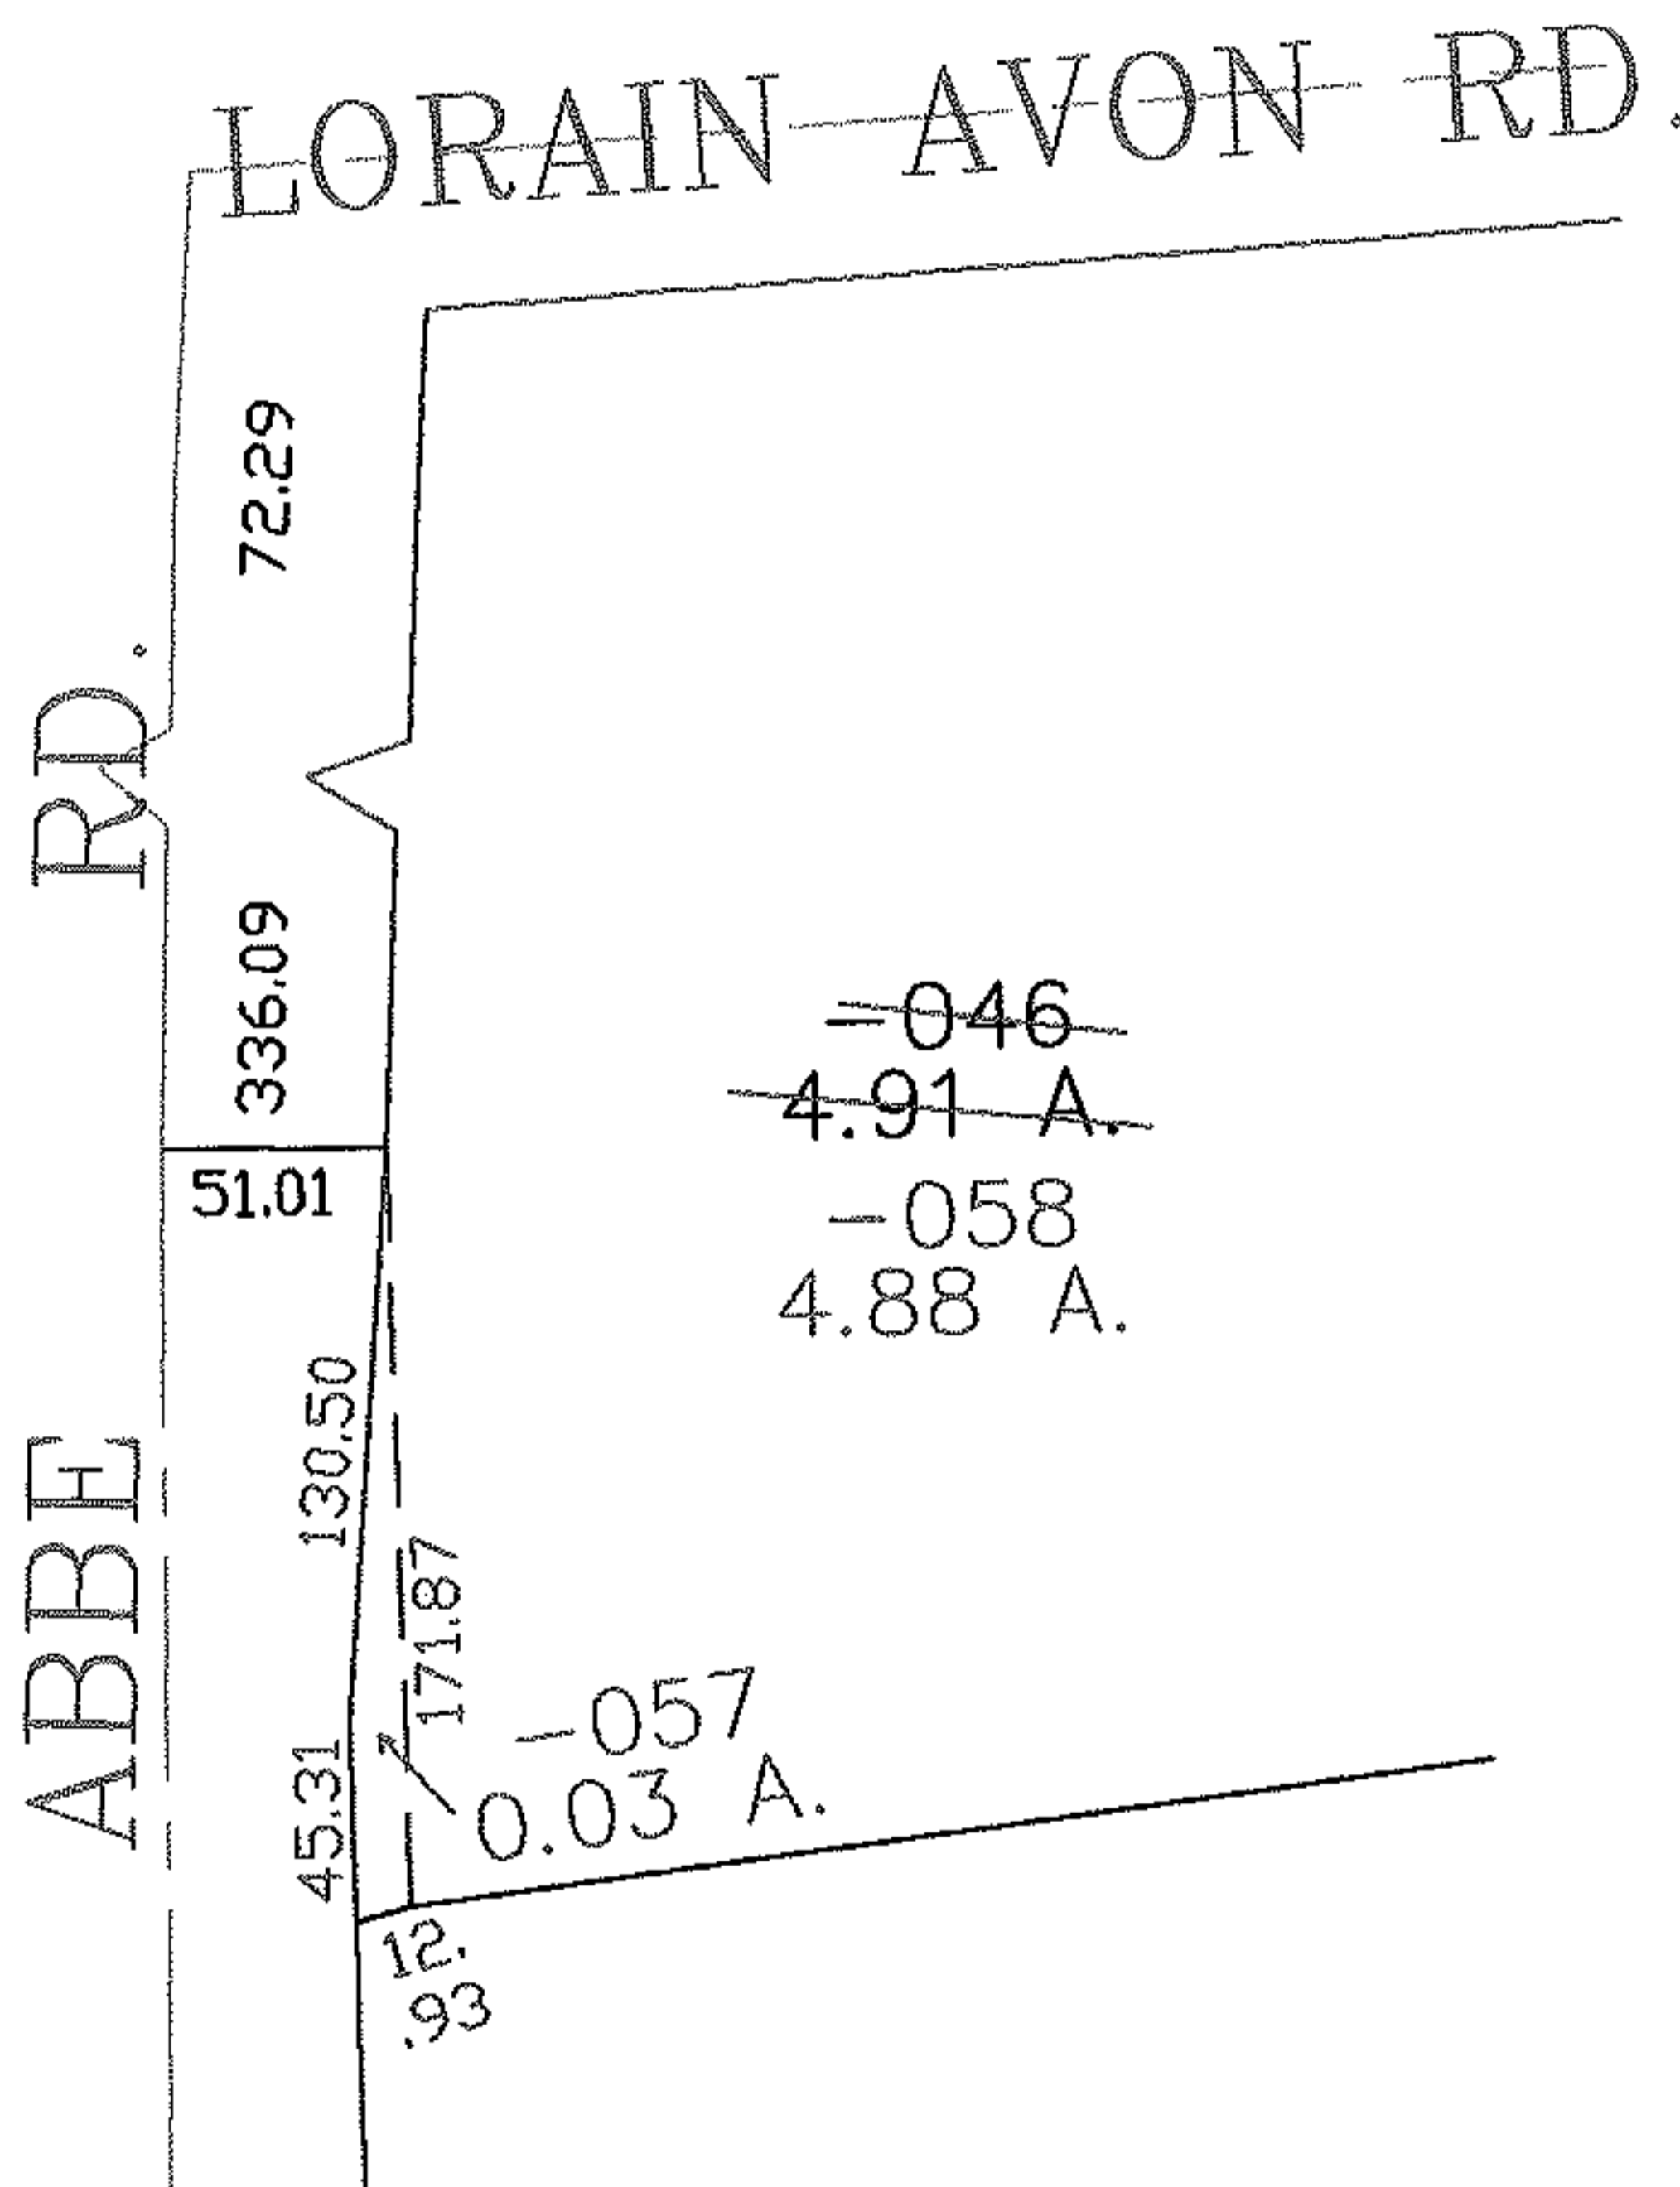


PARENT PARCEL: 03-00-007-102-046

CHILD PARCEL: 03-00-007-102-057, -058

STARTING POINT: CENTERLINE OF LORAIN AVON RD. & ABBE RD.

NO. 00121

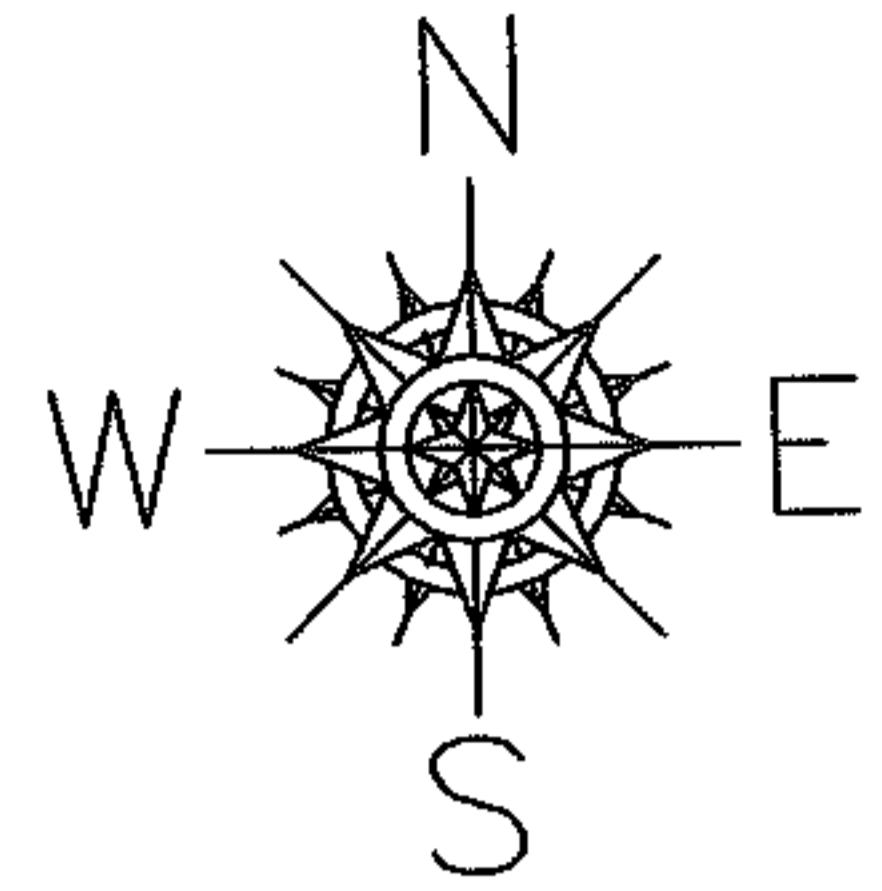

SPLITS/DEEDS PROCESSED

LORAIN COUNTY TAX MAP DEPARTMENT
226 MIDDLE AVE. ELYRIA, OHIO

SURVEYED BY: GARY J. DURBIN

CLOSURE: 0.00 : 10.000

MAP PAGE(S): 03-00-007-A

APPROVED BY: JAH DATE: 8-30-04

SCALE: 1" = 100 PRIOR INSTRUMENT: DV 1412/736