
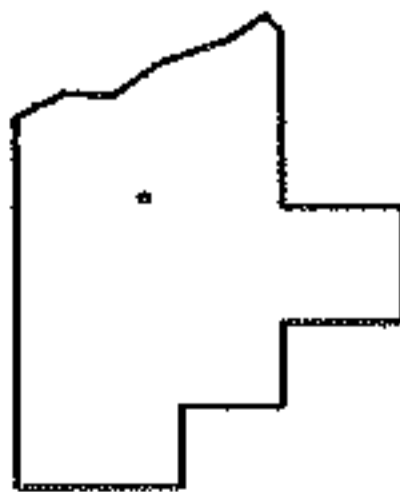
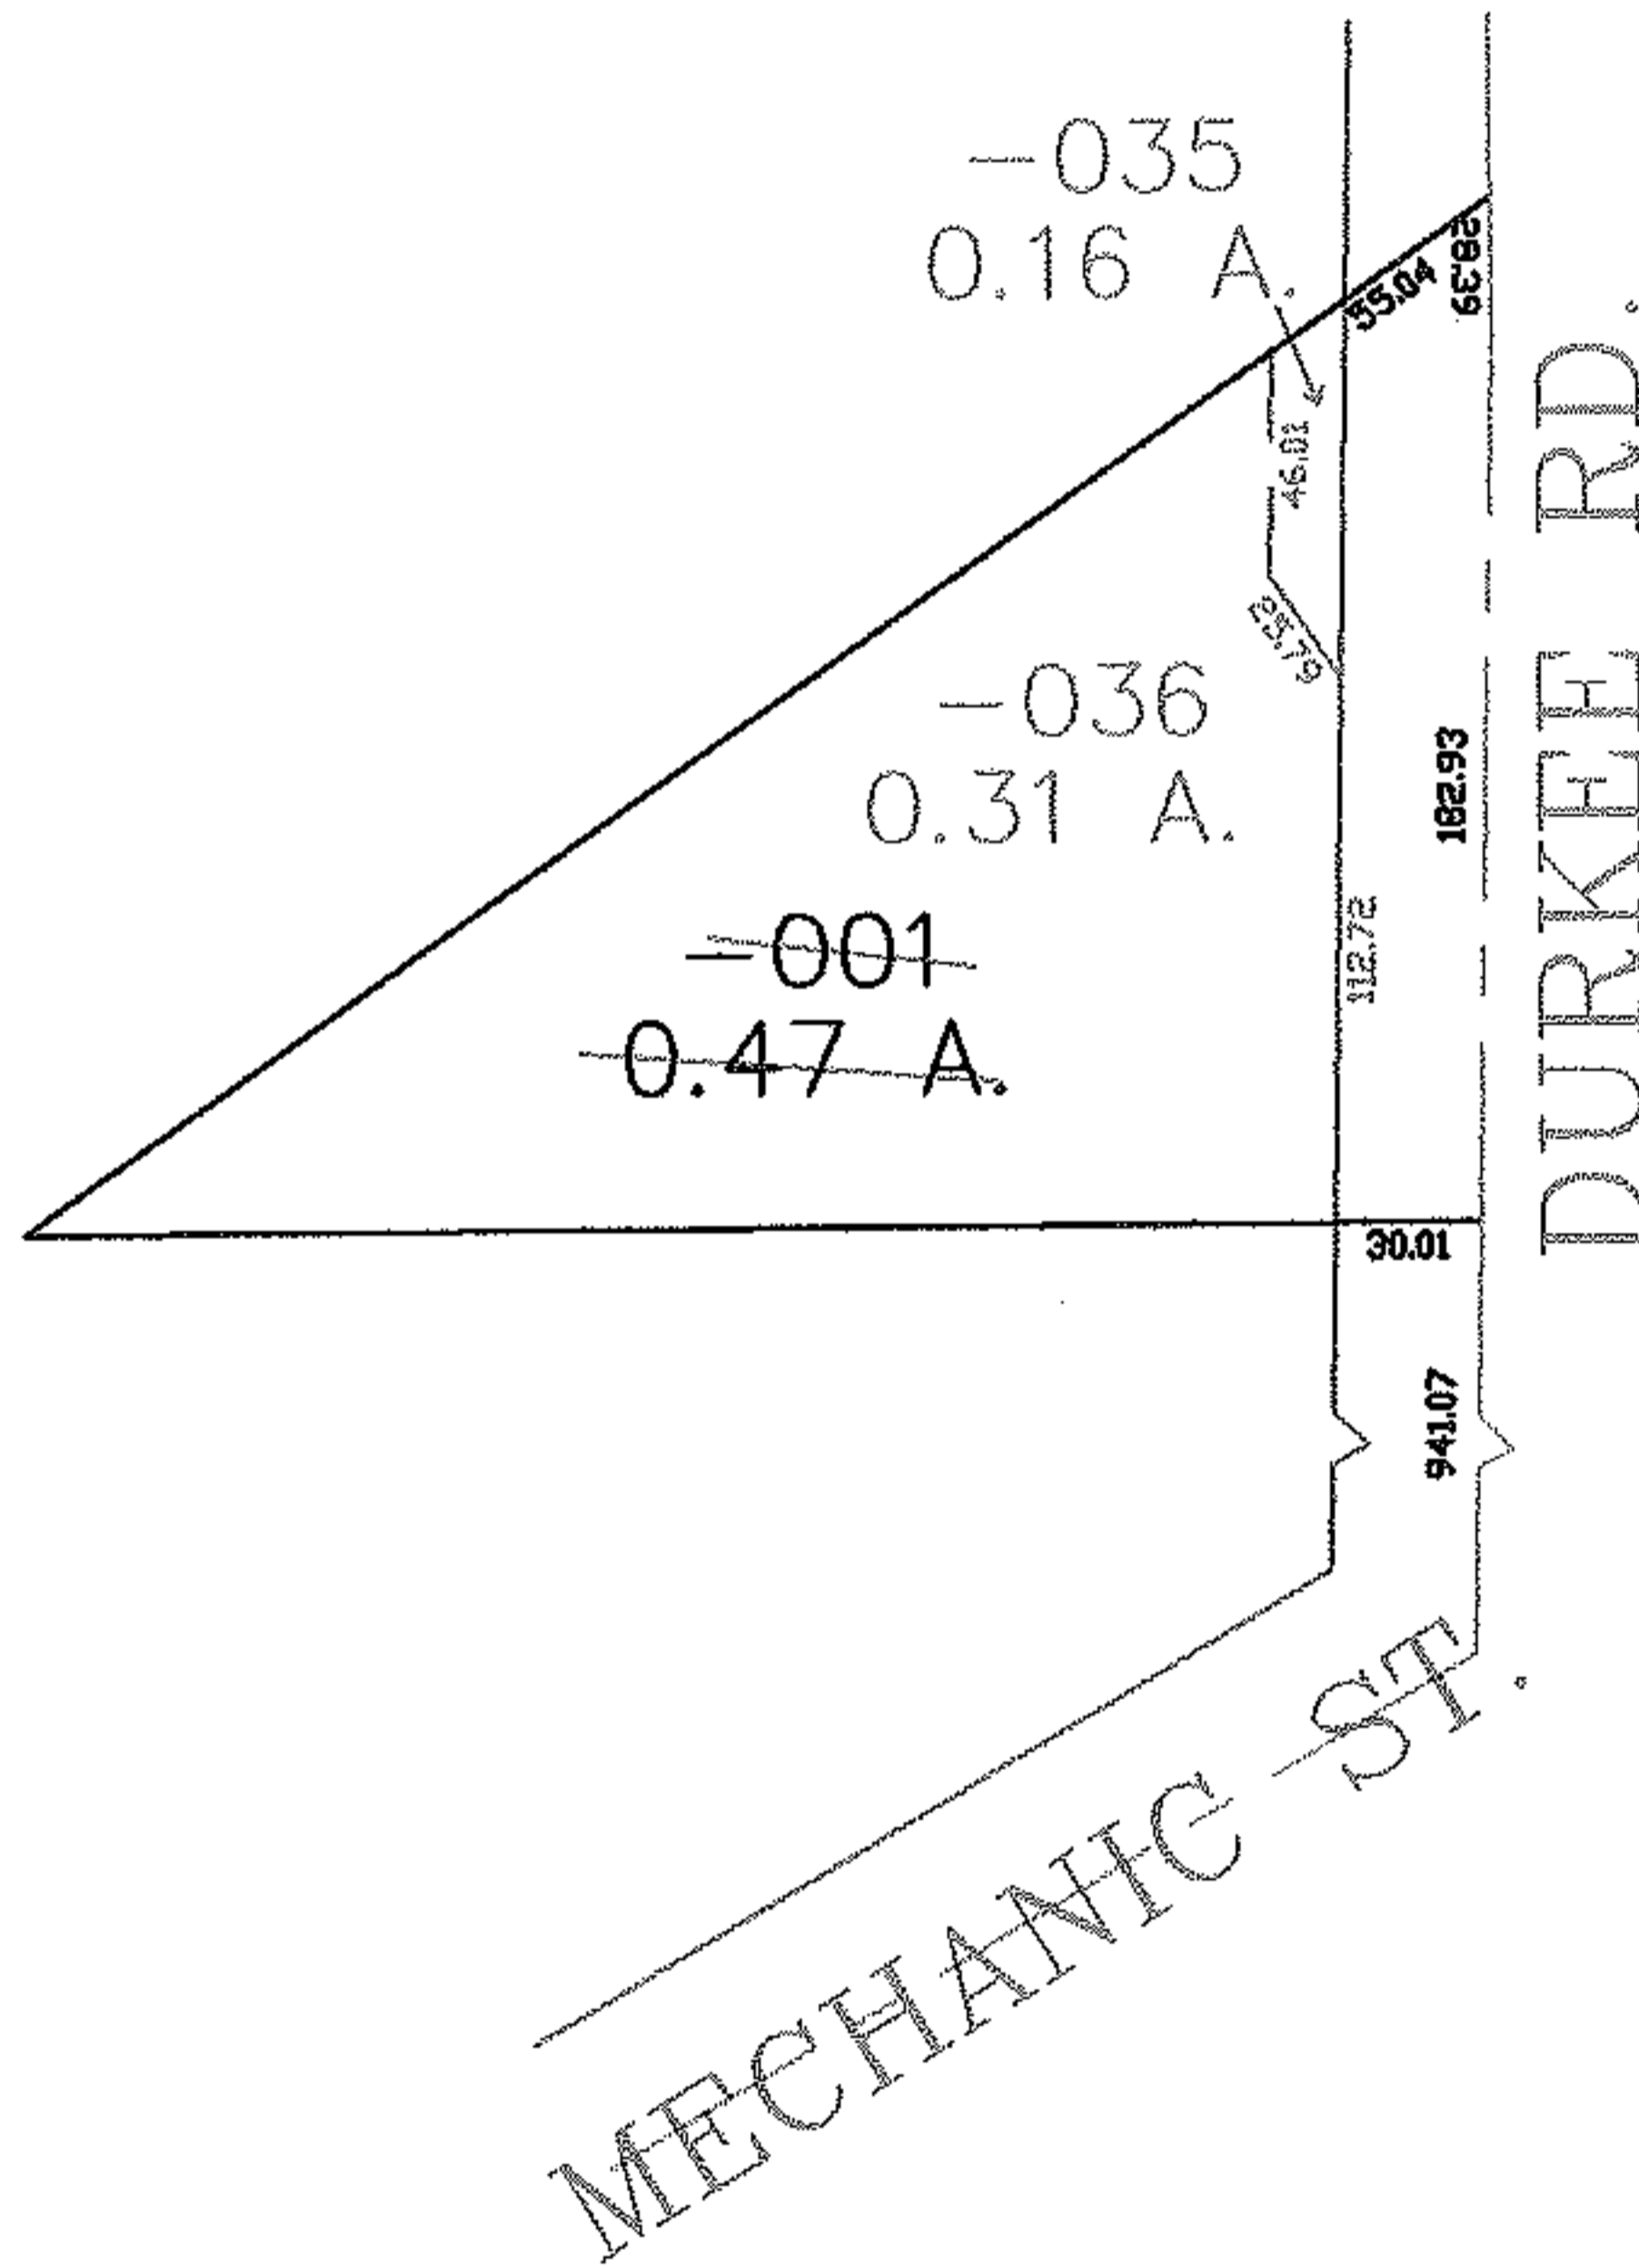


PARENT PARCEL: 11-00-081-105-001

CHILD PARCEL: 11-00-081-105-035, -036

STARTING POINT: CENTERLINE OF MECHANIC ST. & DURKEE RD.

NO. 00122

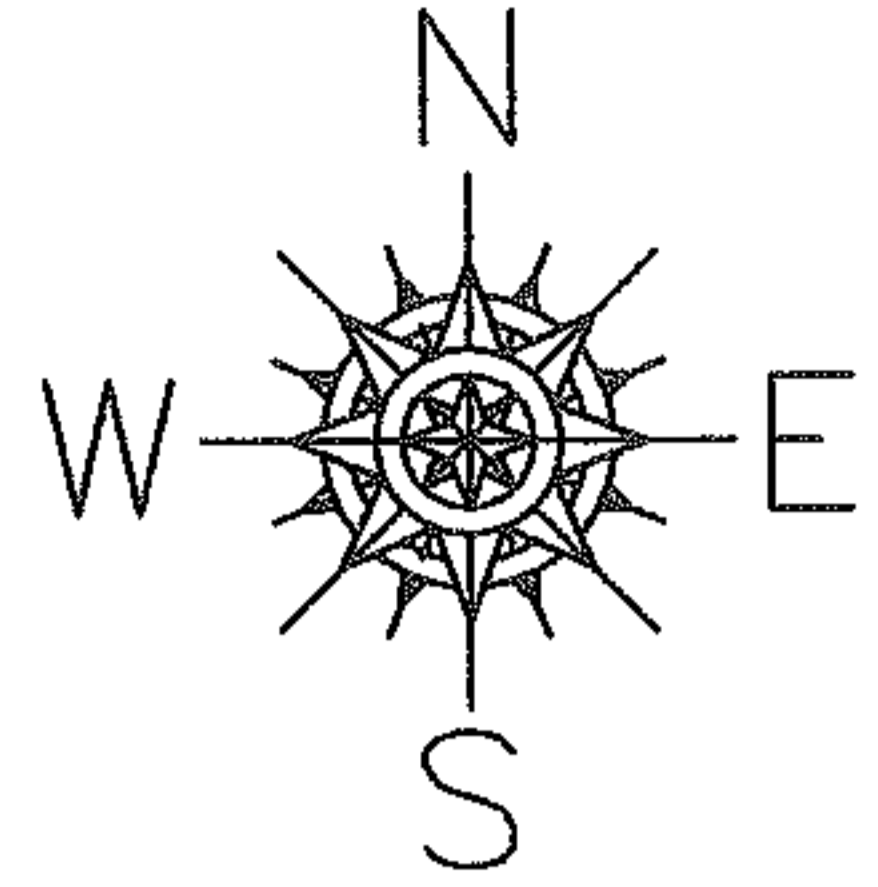

SPLITS/DEEDS PROCESSED

LORAIN COUNTY TAX MAP DEPARTMENT
226 MIDDLE AVE. ELYRIA, OHIO

SURVEYED BY: CHARLES P. UNTERREINER

CLOSURE: 0.00 : 10.000

MAP PAGE(S): 11-00-081

APPROVED BY: JAH DATE: 10-26-04

SCALE: 1" = 100 PRIOR INSTRUMENT: DV 1408/978