
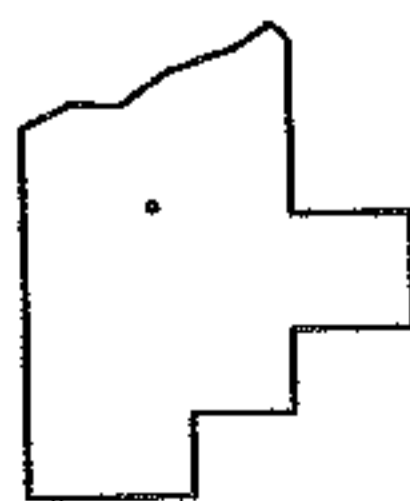
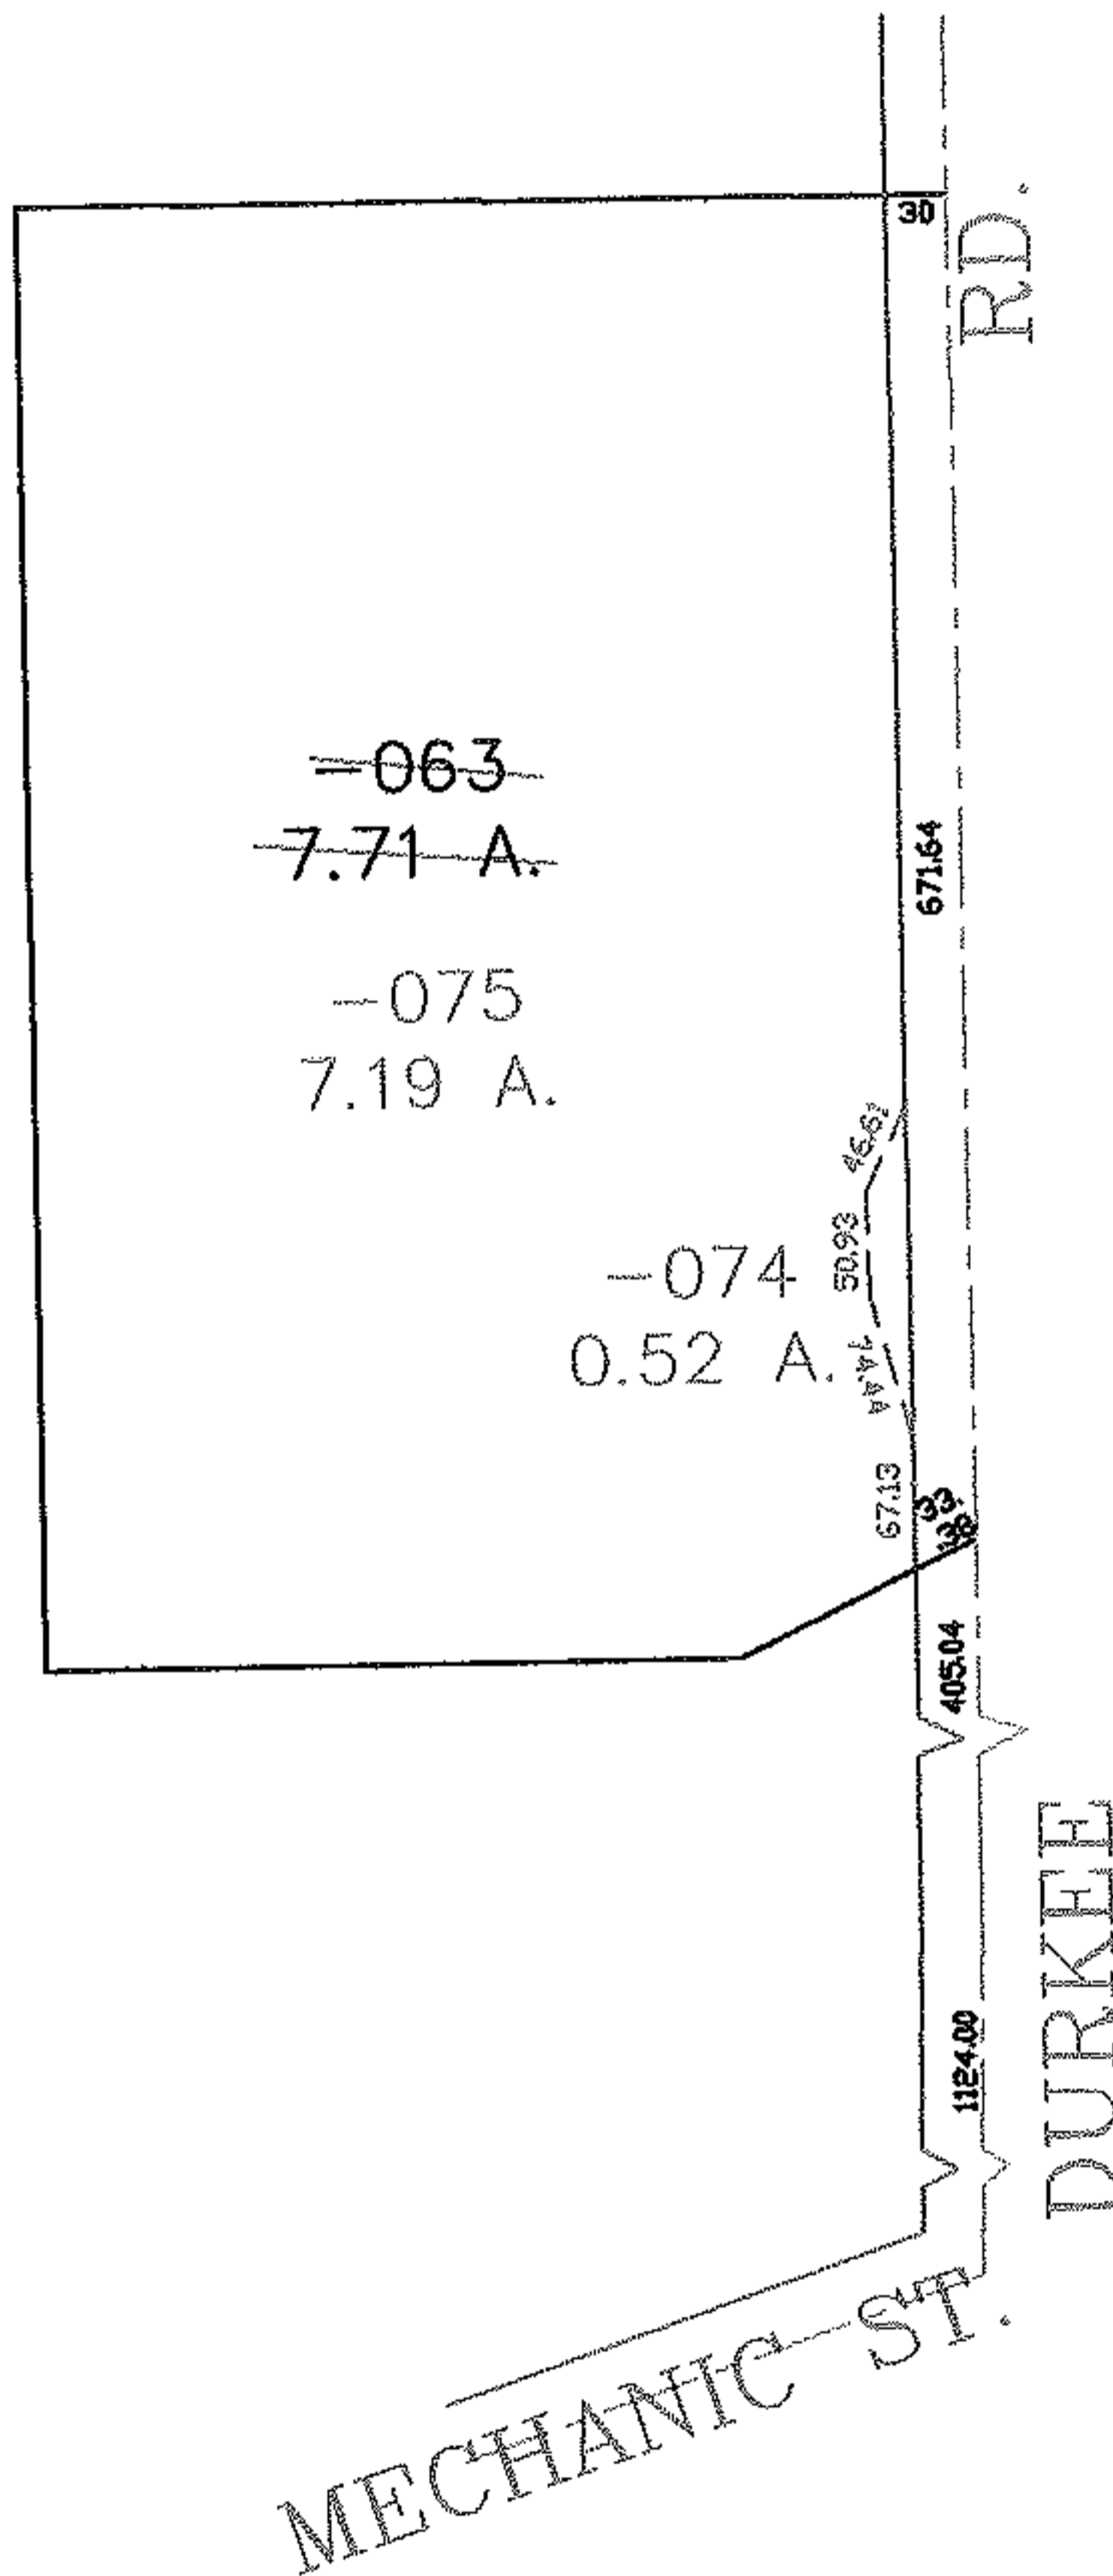


PARENT PARCEL: 11-00-081-102-063

CHILD PARCEL: 11-00-081-102-074, -075

STARTING POINT: CENTERLINE OF DURKEE RD. & MEGHANIC ST.

NO. 00123

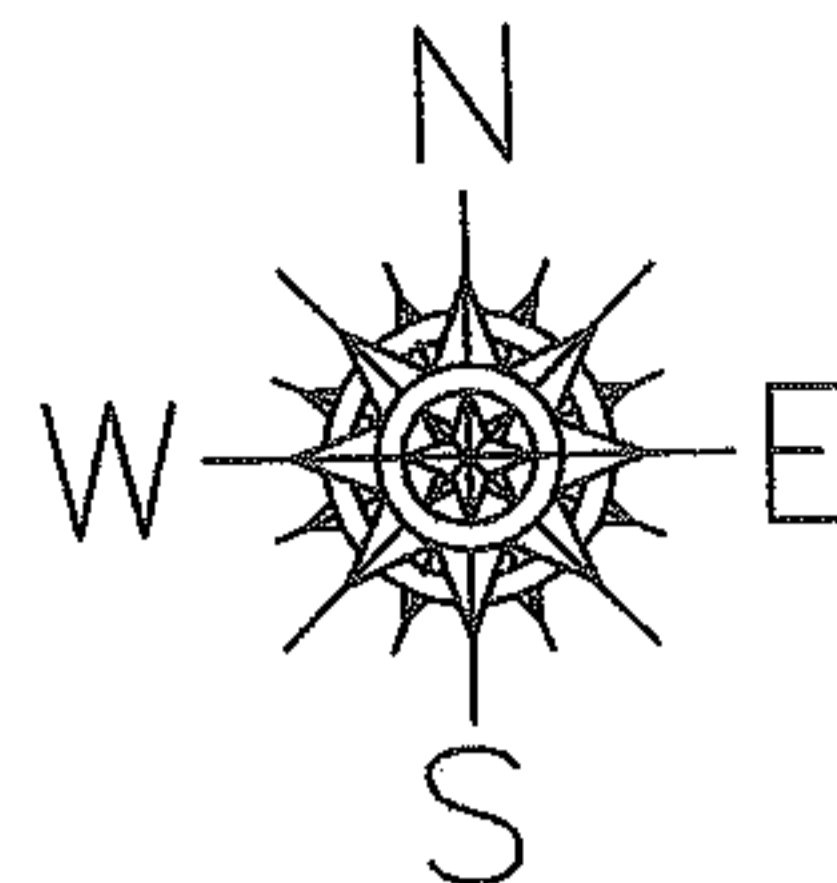

SPLITS/DEEDS PROCESSED
 LORAIN COUNTY TAX MAP DEPARTMENT
 226 MIDDLE AVE. ELYRIA, OHIO

SURVEYED BY: CHARLES P. UNTERREINER
 CLOSURE: 0.00 : 10.000
 MAP PAGE(S): 11-00-081
 APPROVED BY: JAH DATE: 10-27-04
 SCALE: 1" = 200' PRIOR INSTRUMENT: OR 1038/869