
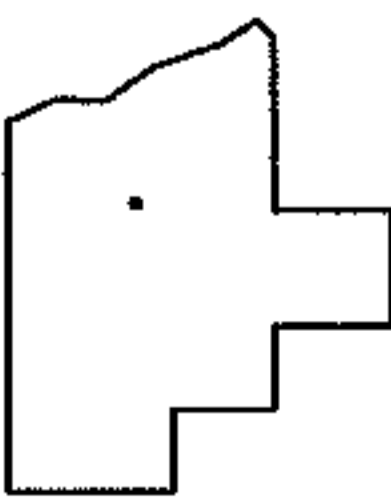
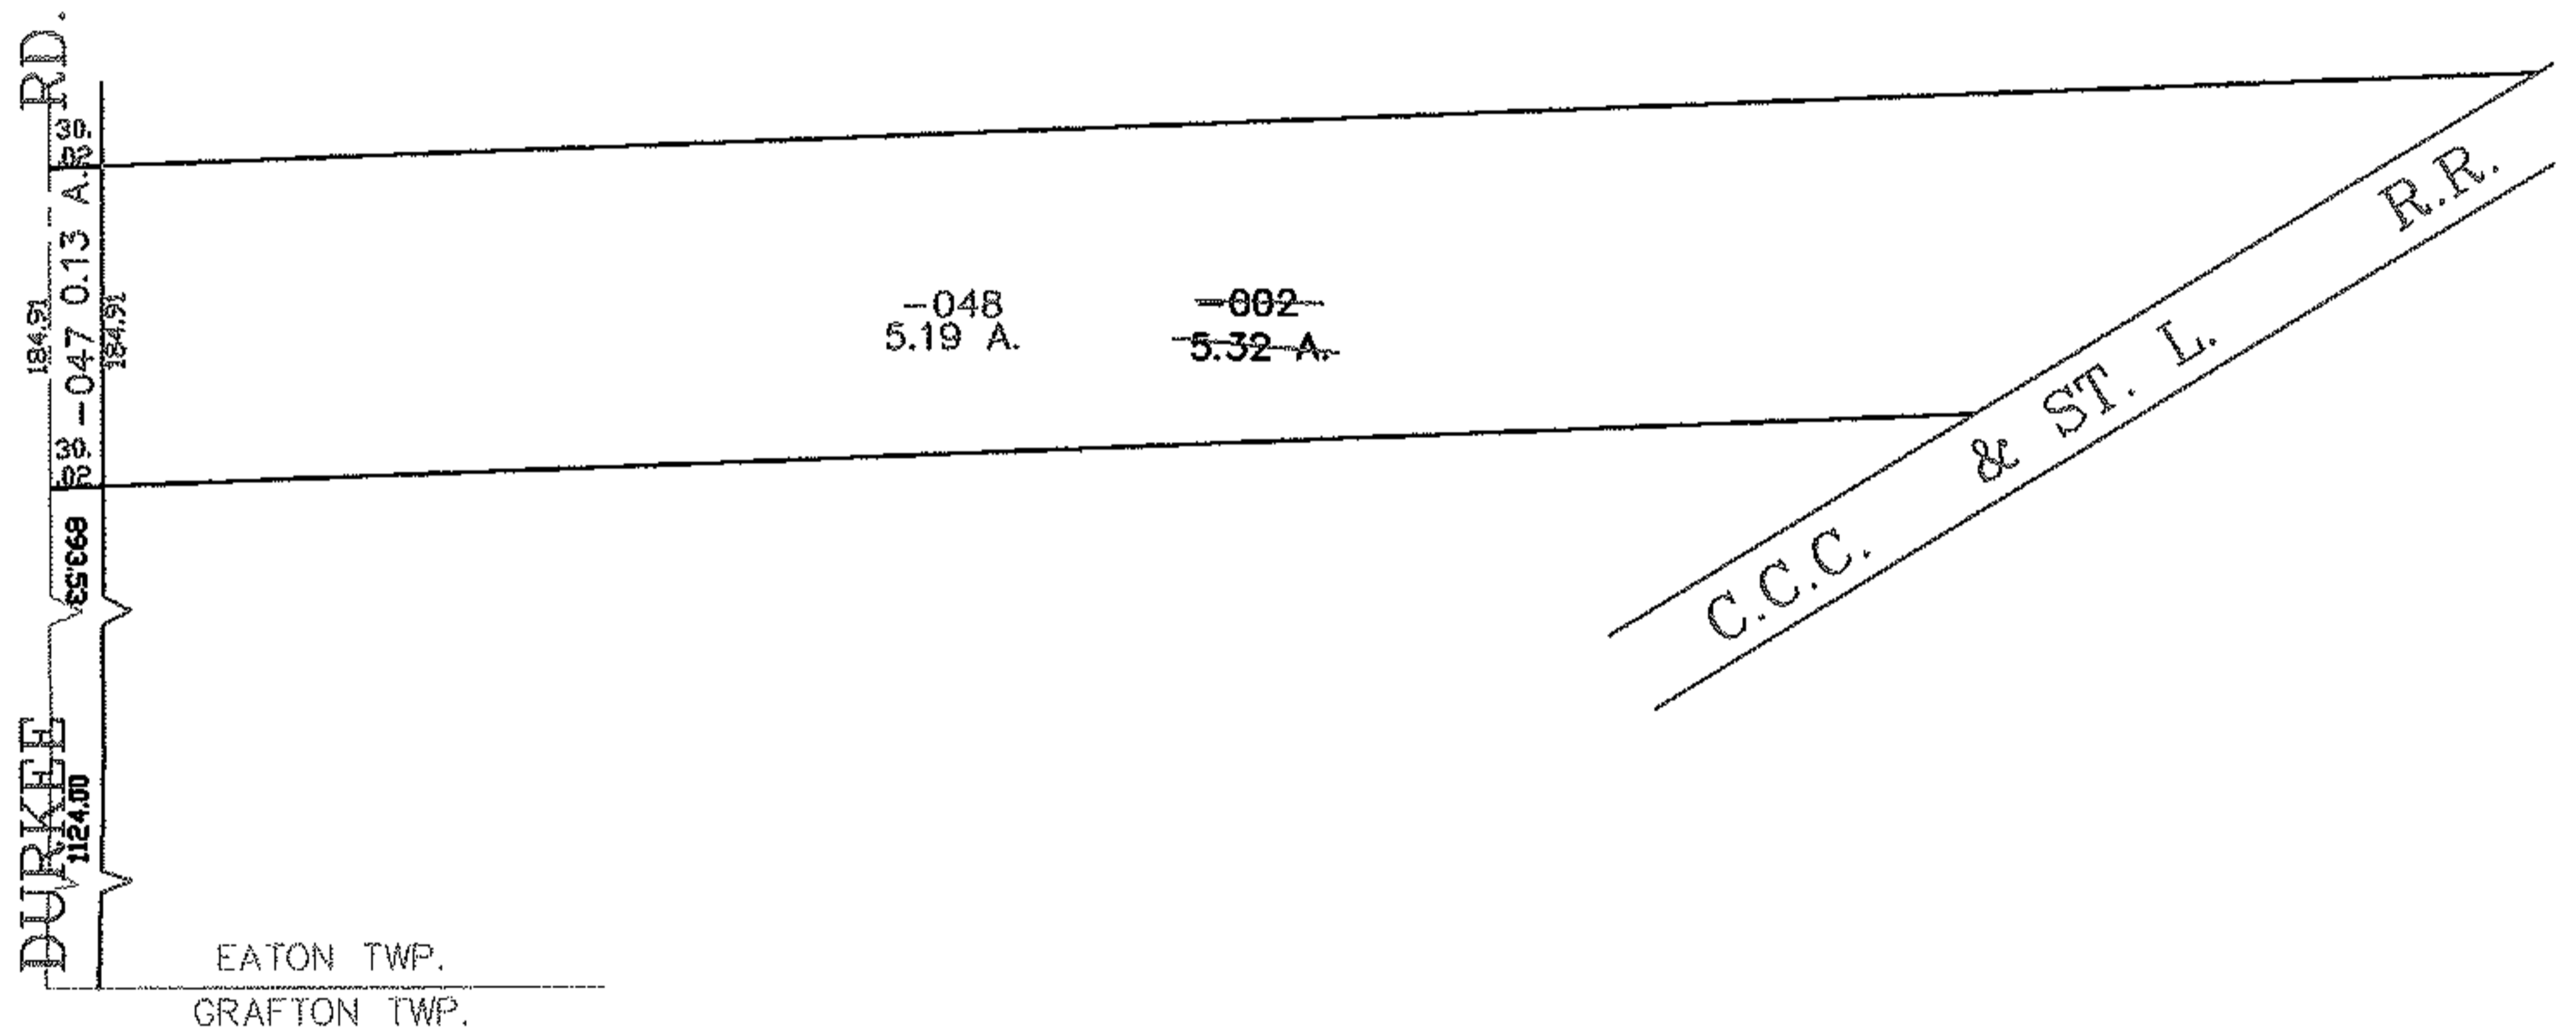


PARENT PARCEL: 11-00-080-000-002

CHILD PARCEL: 11-00-080-000-047, -048

STARTING POINT: CENTERLINE OF DURKEE RD. & O.L. 80

NO. 00125

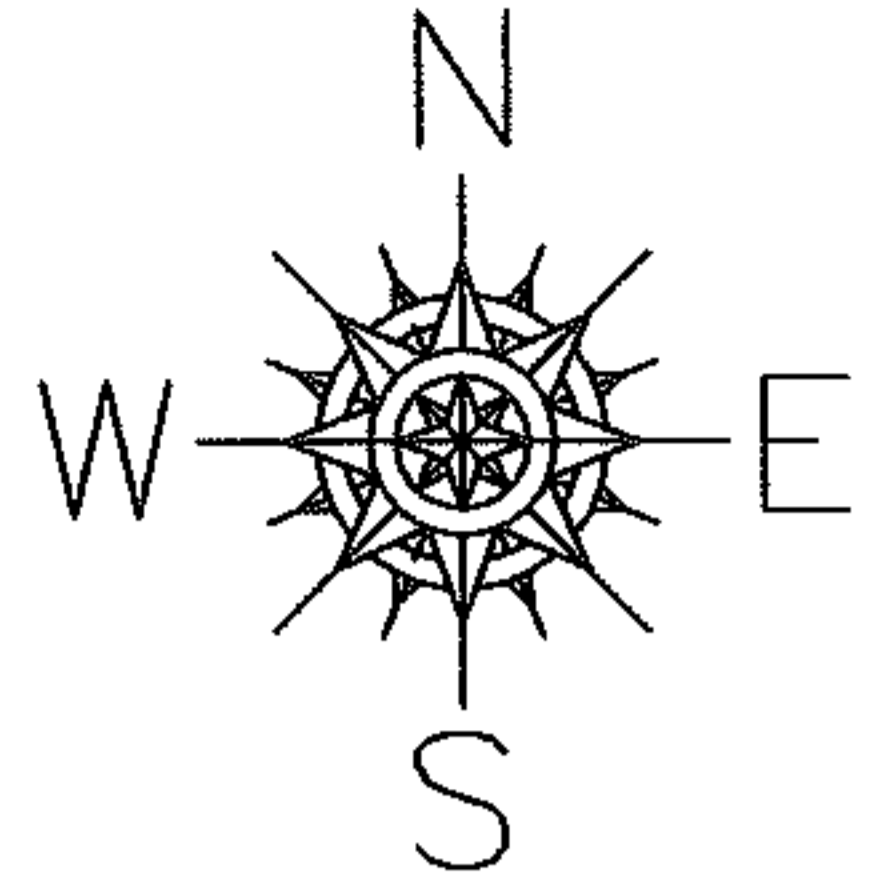

SPLITS/DEEDS PROCESSED

LORAIN COUNTY TAX MAP DEPARTMENT
226 MIDDLE AVE. ELYRIA, OHIO

SURVEYED BY: CHARLES P. UNTERREINER
 CLOSURE: 0.00 : 10.000
 MAP PAGE(S): 11-00-080-A
 APPROVED BY: JAH DATE: 11-1-04
 SCALE: 1" = 200 PRIOR INSTRUMENT: 20010765232