
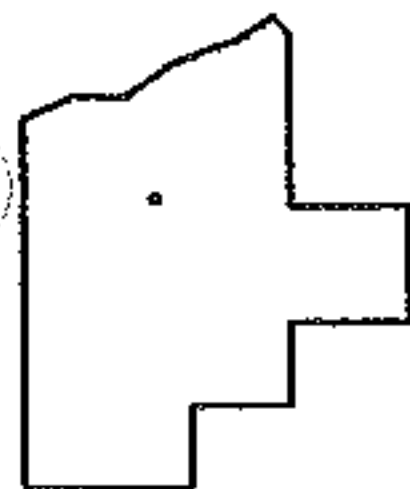
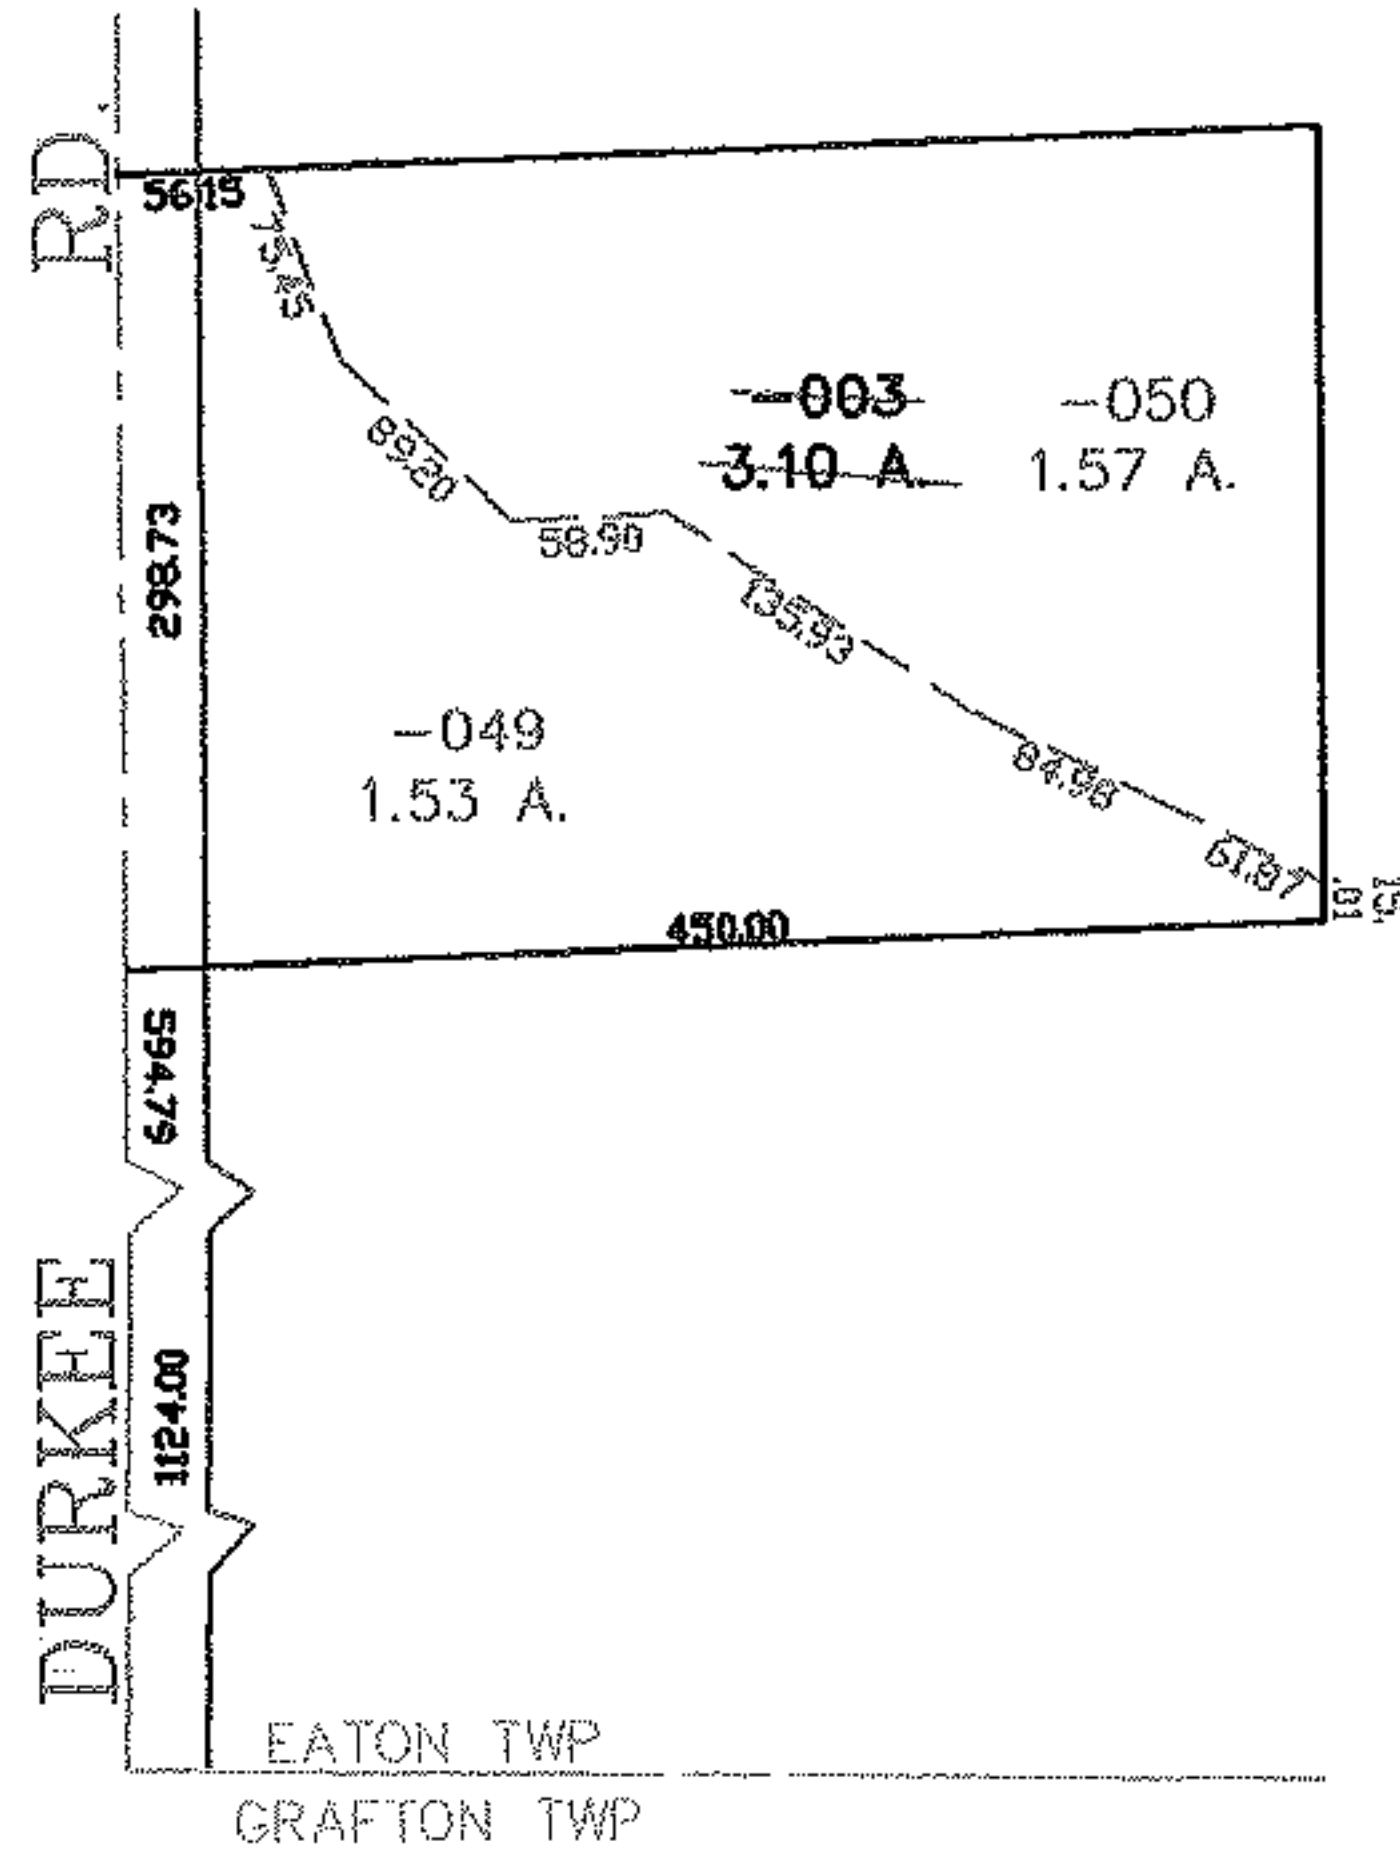


PARENT PARCEL: 11-00-080-000-003

CHILD PARCEL: 11-00-080-000-049, -050

STARTING POINT: CENTERLINE OF DURKEE RD. & O.L. 80

NO. 00126

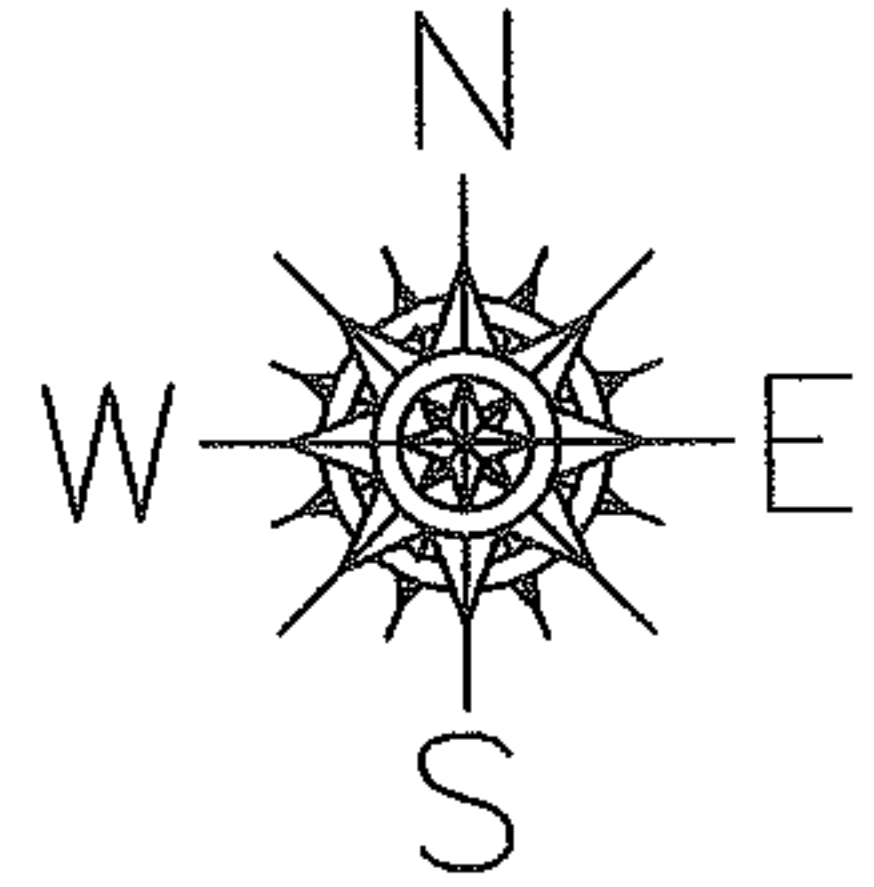

**SPLITS/DEEDS PROCESSED**  
**LORAIN COUNTY TAX MAP DEPARTMENT**  
 226 MIDDLE AVE. ELYRIA, OHIO

SURVEYED BY: CHARLES P. UNTERREINER  
 CLOSURE: 0.00 : 10.000  
 MAP PAGE(S): 11-00-080-A  
 APPROVED BY: JAH DATE: 11-1-04  
 SCALE: 1" = 200 PRIOR INSTRUMENT: OR 1117/629