

PARENT PARCEL: 15-00-057-000-006

CHILD PARCEL: --SAME--

STARTING POINT: INT CL WEST MAIN ST AND E LINE OF O.L. 57

NO. 00953-A



WEST MAIN ST

O.L. 57

O.L. 56

1650.95

AC. CORR.  
PER SURVEY  
L.S.C. & ASSOC

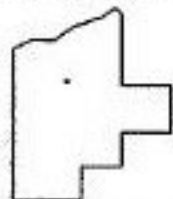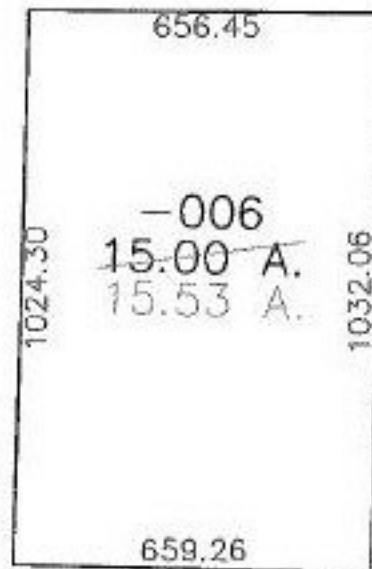

**SPLITS/DEEDS PROCESSED**

LORAIN COUNTY TAX MAP DEPARTMENT  
226 MIDDLE AVE. ELYRIA, OHIO

SURVEYED BY: LAUNDON, SIMON, CAHL & ASSOC

CLOSURE: 1:10,000

MAP PAGE(S): 15-F

APPROVED BY: DRH DATE: 3/10/2004

SCALE: 1" = 400' PRIOR INSTRUMENT: 20010736284