

RASTER

PARENT PARCEL: 09-00-027-000-004



CHILD PARCEL: --SAME--

STARTING POINT: MON BOX INT OBERLIN RD AND CL OF RUSSIA RD

NO. 00956-A



RUSSIA RD

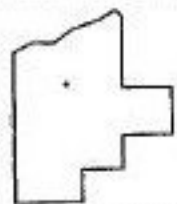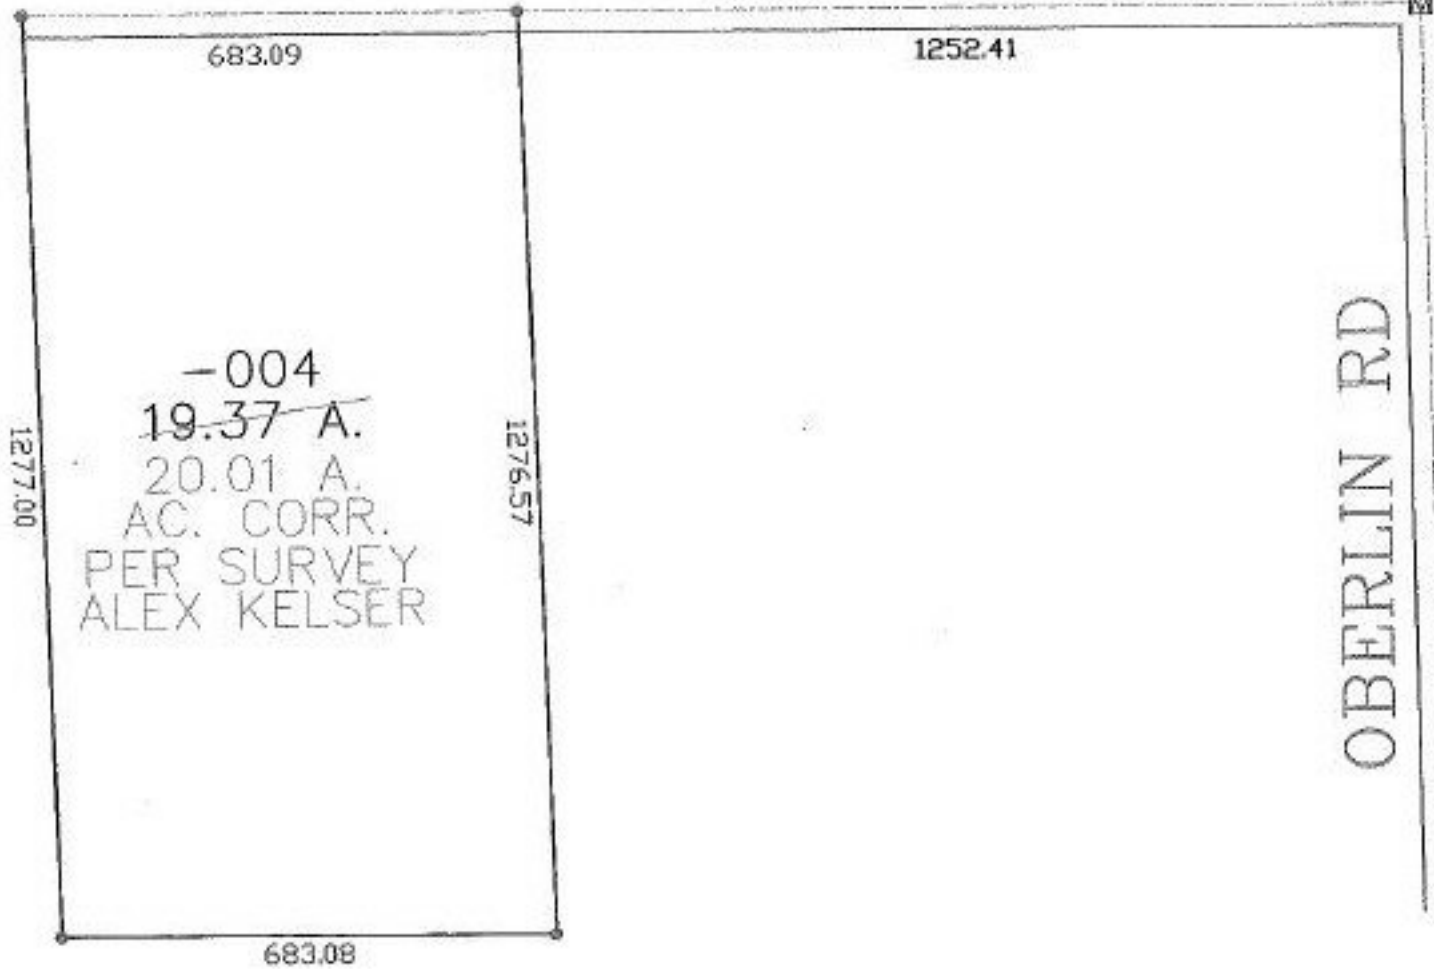

**SPLITS/DEEDS PROCESSED**  
 LORAIN COUNTY TAX MAP DEPARTMENT  
 226 MIDDLE AVE. ELYRIA, OHIO

SURVEYED BY: ALEX KELSER  
 CLOSURE: 1:60,000  
 MAP PAGE(S): 9-B  
 APPROVED BY: DRH DATE: 1/7/2004  
 SCALE: 1" = 300' PRIOR INSTRUMENT: 20030910683