

PARENT PARCEL: 11-00-092-000-042


CHILD PARCEL: --SAME--

STARTING POINT:

NO. 00962-X


CHESTNUT RIDGE

DEWHURST RD

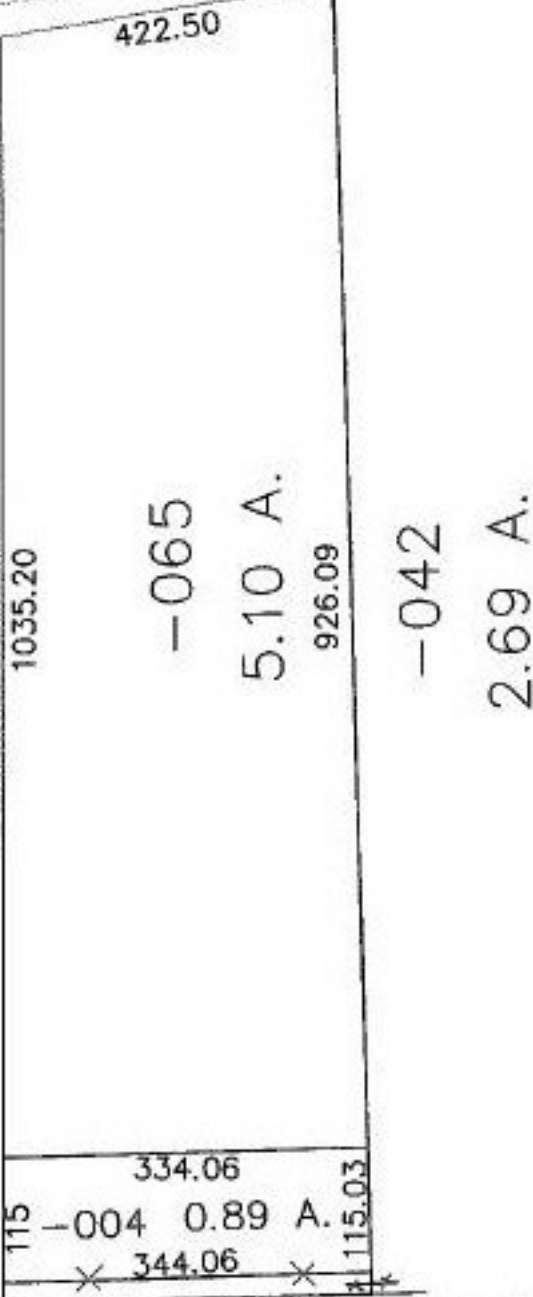

MAP UPDATE

SPACE LEFT ON MAP
SHOULD NOT BE THERE
ERASE LINE AND MOVE DIM
DOWN

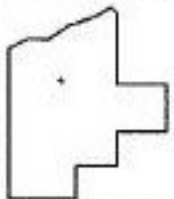

SPLITS/DEEDS PROCESSED
LORAIN COUNTY TAX MAP DEPARTMENT
226 MIDDLE AVE. ELYRIA, OHIO

SURVEYED BY: N/A

CLOSURE: N/A

MAP PAGE(S): 11-00-092-A

APPROVED BY: DRH DATE: 1/13/2004

SCALE: 1" = 200' PRIOR INSTRUMENT: DV 801/507