PARENT PARCEL: 01-00-027-000-055


CHILD PARCEL: -- SAME --

STARTING POINT: INT CL COOPER FOSTER RD AND E LINE OF LAND

NO.00969-



AC.CORR. PER SURVEY GEORGE A. HOFMANN

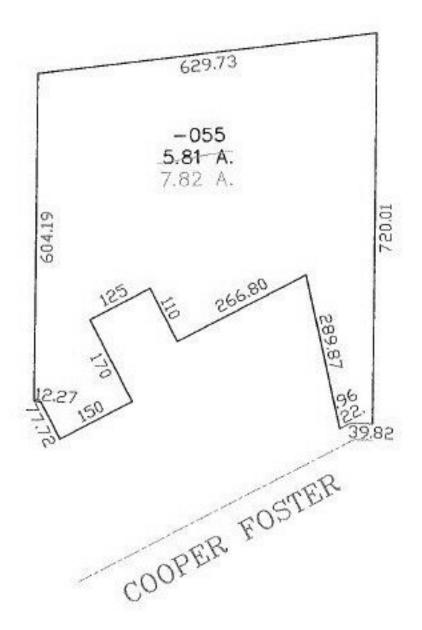

SPLITS/DEEDS PROCESSED LORAIN COUNTY TAX MAP DEPARTMENT 226 MIDDLE AVE. ELYRIA, OHIO

SURVEYED BY: GEORGE A. HOFMANN CLOSURE: 1:10,000

MAP PAGE(S): 01-00-027-A

2/9/2004 APPROVED BY: DRH DATE: SCALE: 1"= 200 PRIOR INSTRUMENT:-