



PARENT PARCEL: 18-00-027-110-023

CHILD PARCEL: ---SAME---

STARTING POINT:

NO. 00978-C

MAP CORR
PER DEED

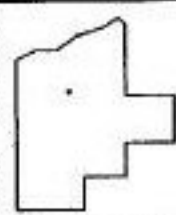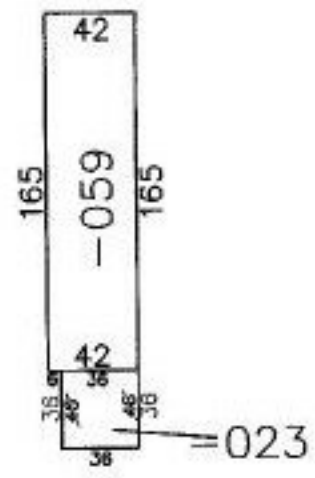

SPLITS/DEEDS PROCESSED

LORAIN COUNTY TAX MAP DEPARTMENT
226 MIDDLE AVE. ELYRIA, OHIO

SURVEYED BY: N/A
CLOSURE: N/A
MAP PAGE(S): 18-00-027-B
APPROVED BY: DRH DATE: 3/11/2004
SCALE: 1" = 100' PRIOR INSTRUMENT: DV 89/367