

RASTER


PARENT PARCEL: 15-00-005-000-024

CHILD PARCEL: --SAME--

STARTING POINT: INT N LINE & CL LAGRANGE ROAD

NO. 00981-C

Doesn't Close
UPDATE LEGAL Before Next
Transfer
AC. CORR. PER DEED

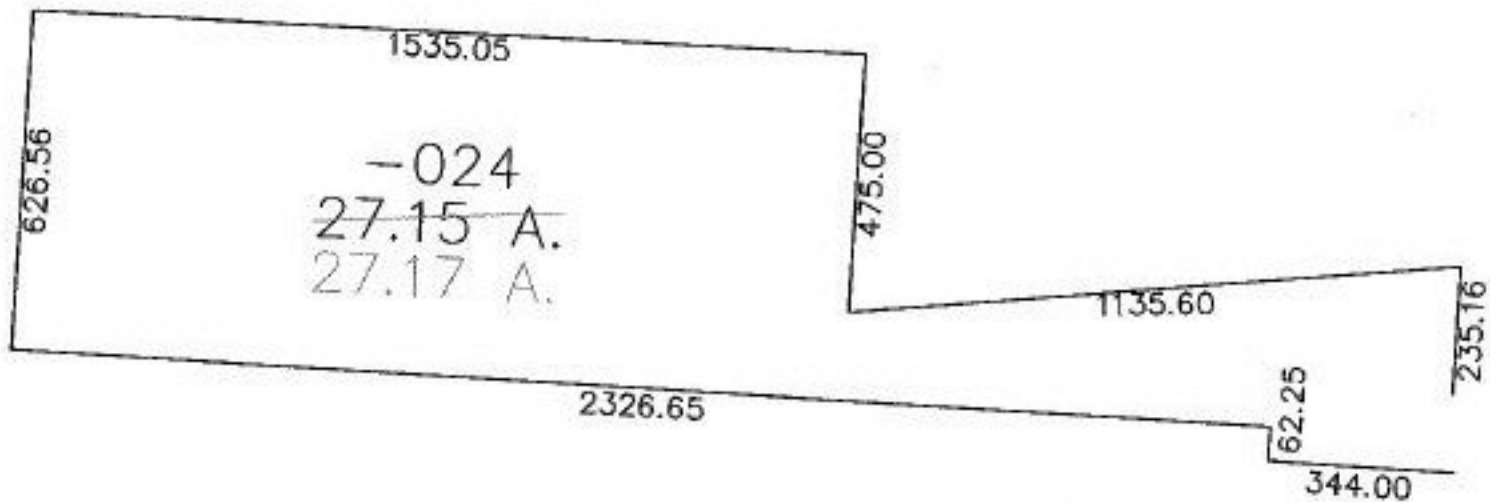

SPLITS/DEEDS PROCESSED
LORAIN COUNTY TAX MAP DEPARTMENT
226 MIDDLE AVE. ELYRIA, OHIO

SURVEYED BY: N/A
CLOSURE: N/A
MAP PAGE(S): 15-00-005-B
APPROVED BY: DRH DATE: 3/12/2004
SCALE: 1" = 400 PRIOR INSTRUMENT: DV 1341/672