

RASTER

PARENT PARCEL: 04-00-002-101-042


CHILD PARCEL: --SAME--

STARTING POINT: INT CL MOON RD AND FRENCH CREEK RD

NO. 00993-C



FRENCH CREEK

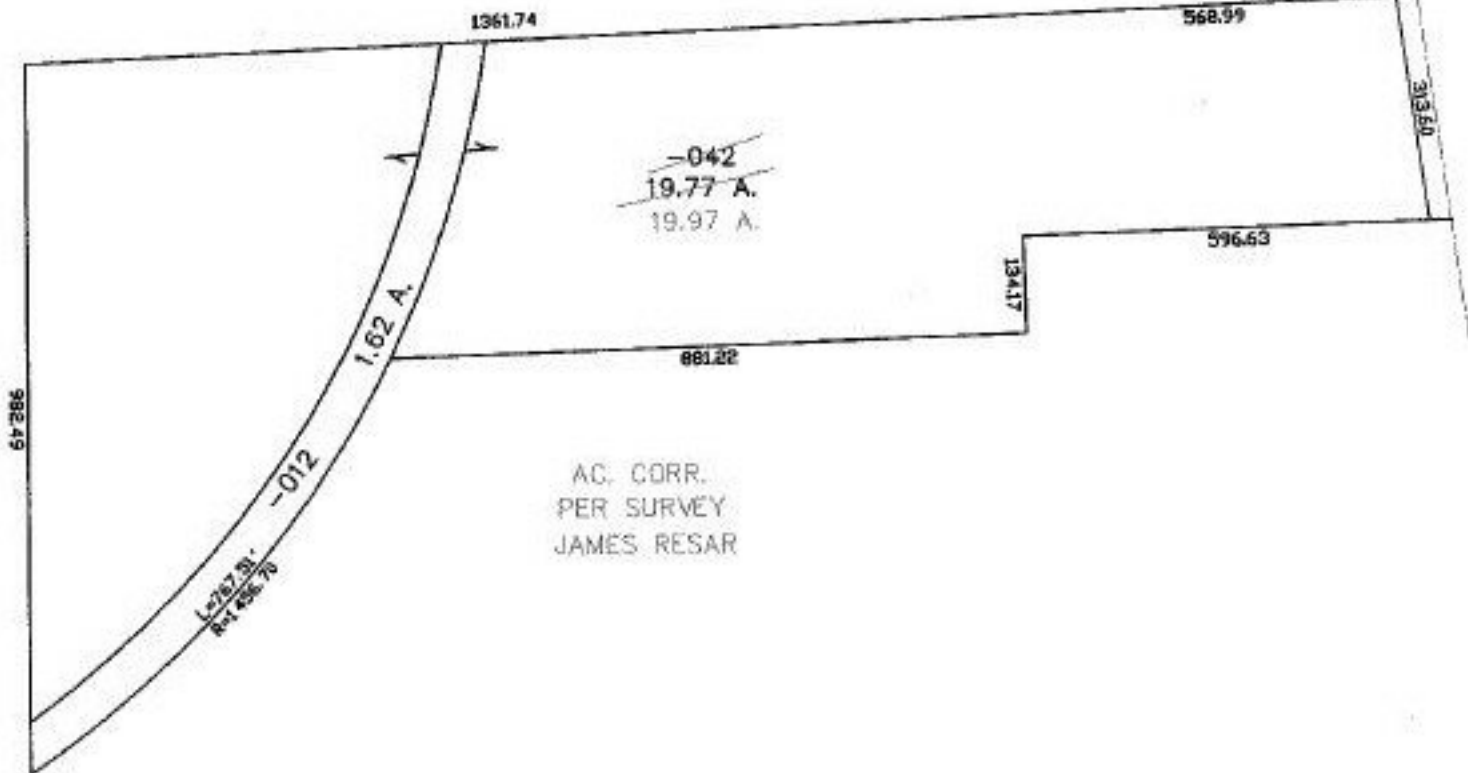

SPLITS/DEEDS PROCESSED
LORAIN COUNTY TAX MAP DEPARTMENT
 226 MIDDLE AVE. ELYRIA, OHIO

SURVEYED BY: JAMES RESAR
 CLOSURE: 1:10,000
 MAP PAGE(S): 04-00-002-A
 APPROVED BY: DRH DATE: 4/12/2004
 SCALE: 1" = 300' PRIOR INSTRUMENT: 20000715791