




ROSTEK

PARENT PARCEL: 06-25-002-113-023

CHILD PARCEL: 06-25-002-113-060 THRU -079

STARTING POINT: CENTER OF DARTMOUTH CIRCLE IN PARKWOOD ESTS. SUBD. NO. 3

NO. 01560

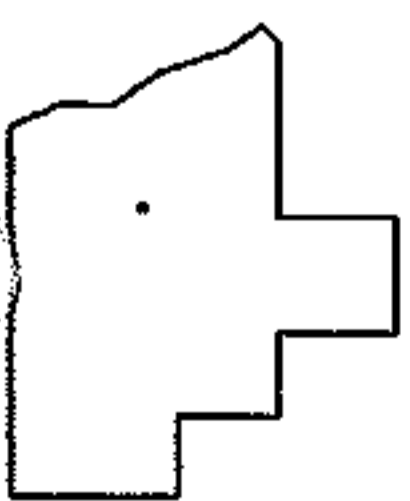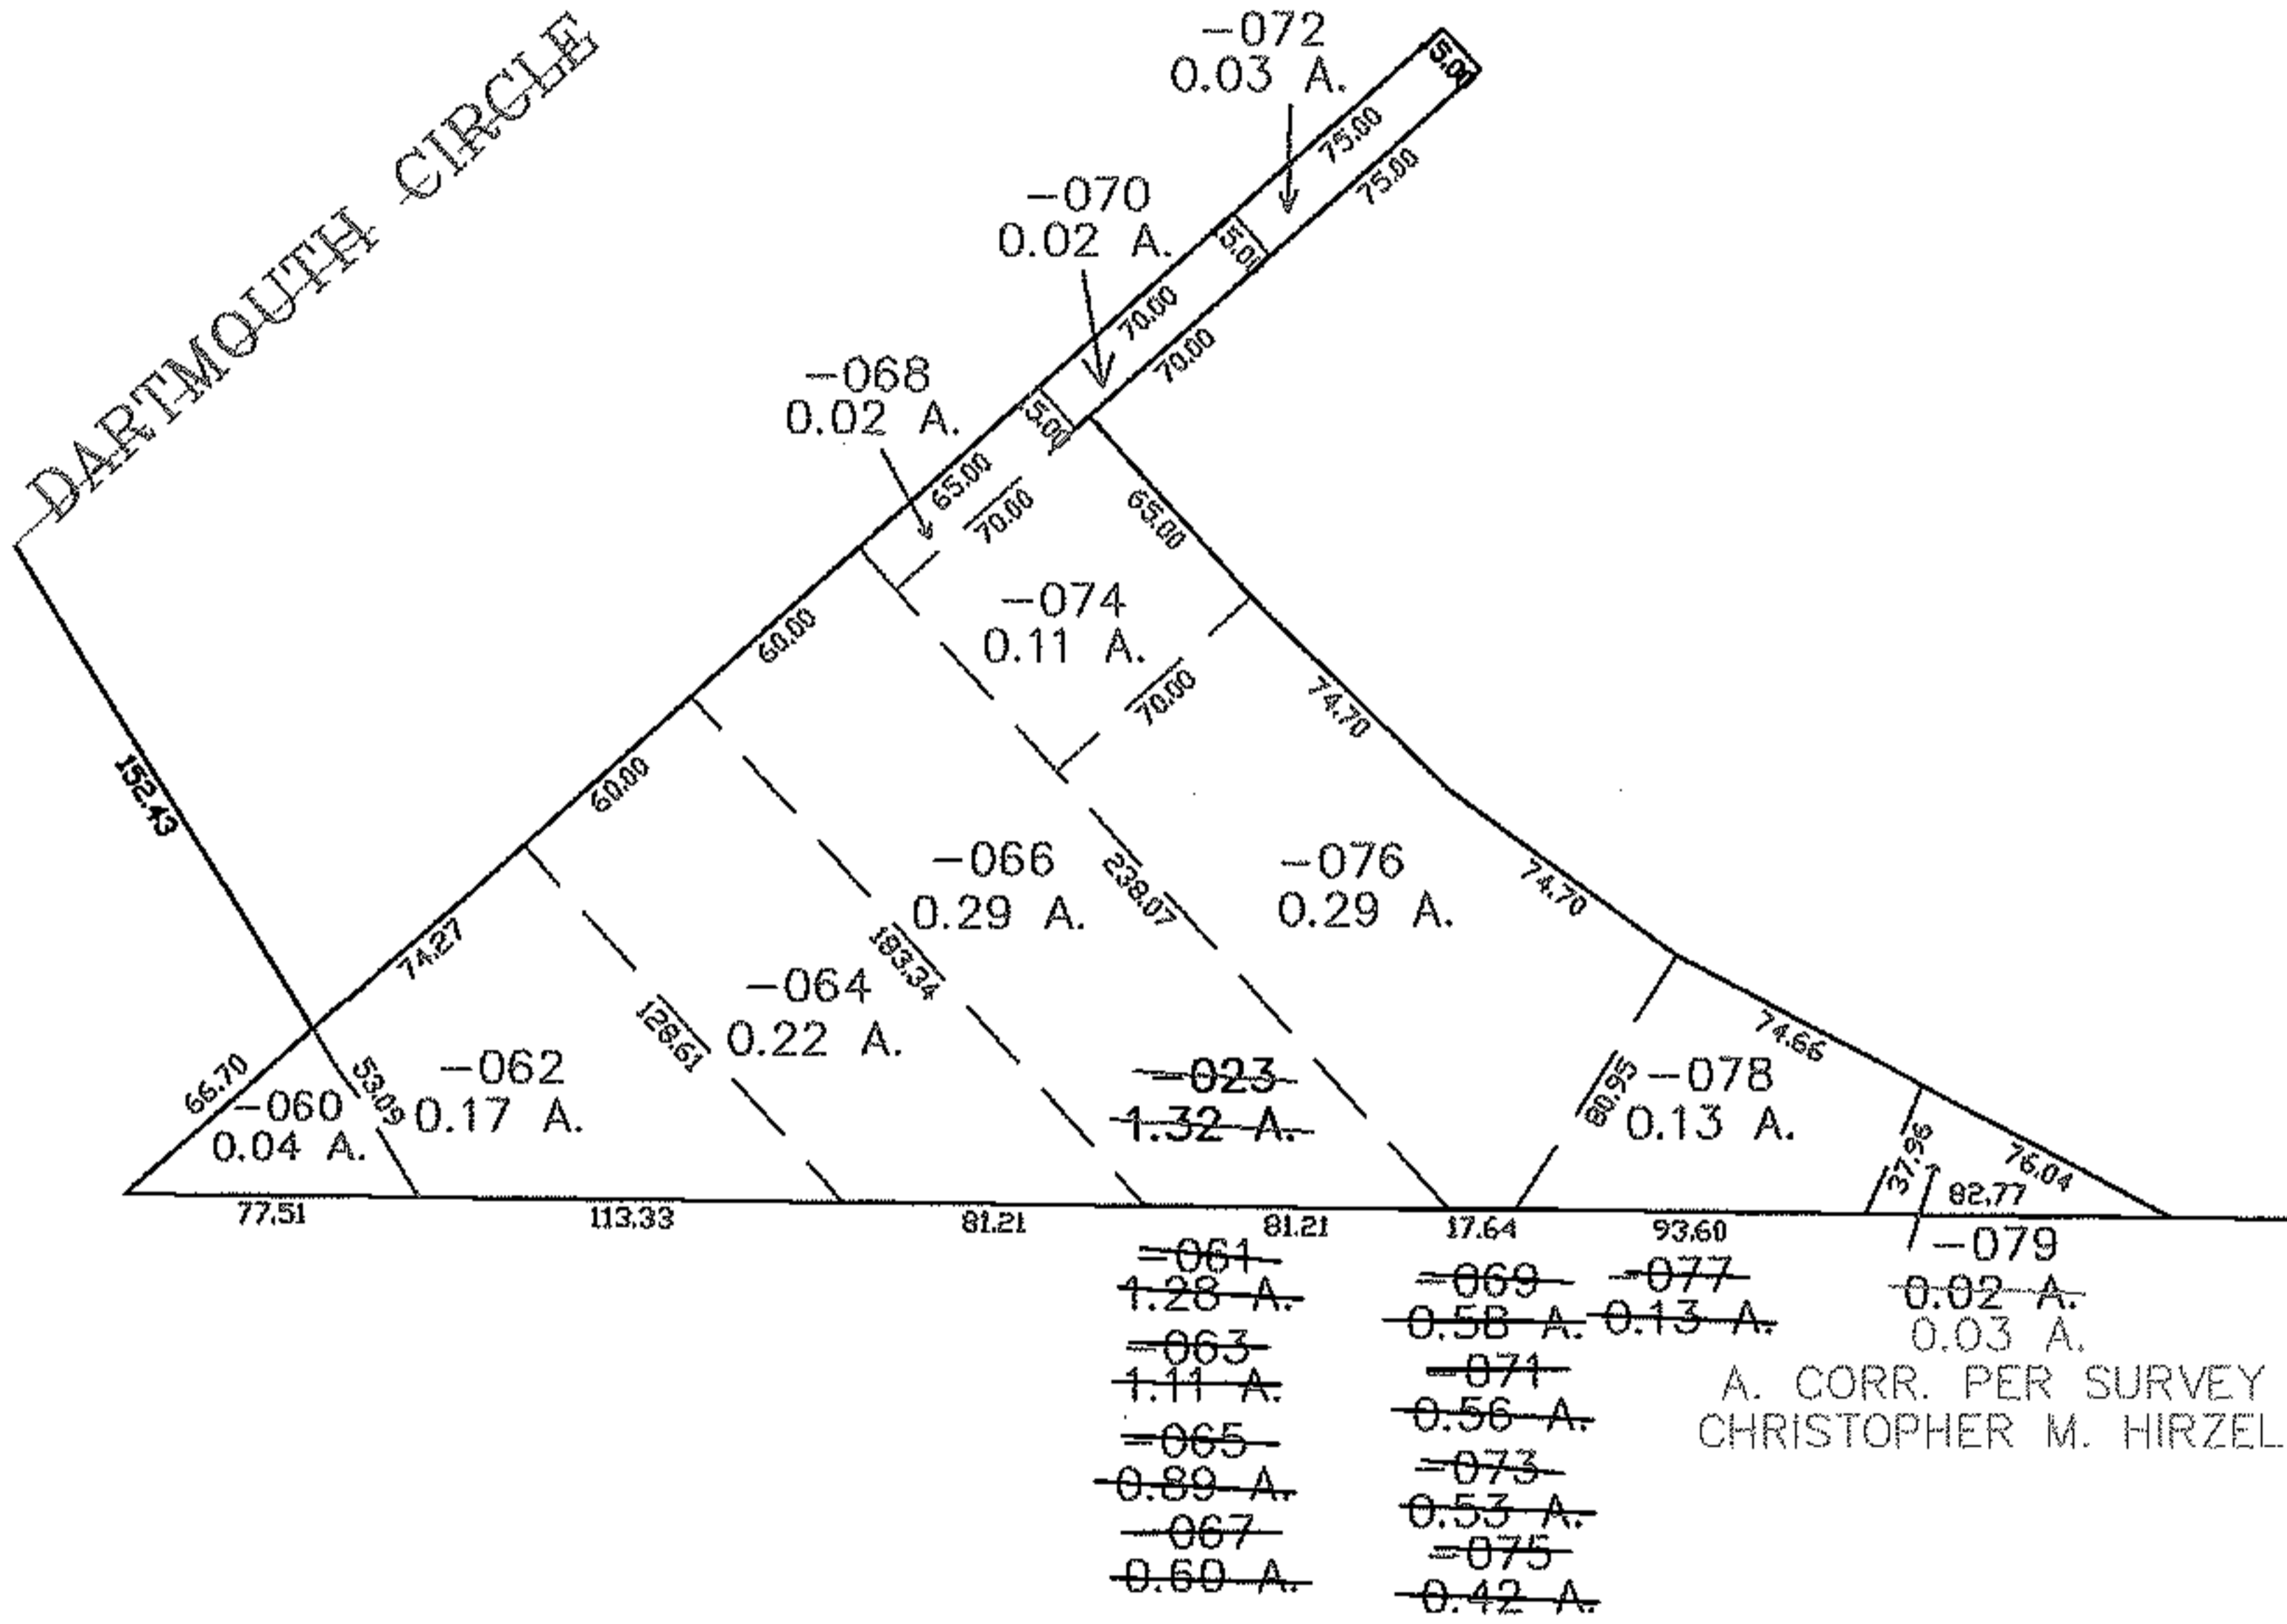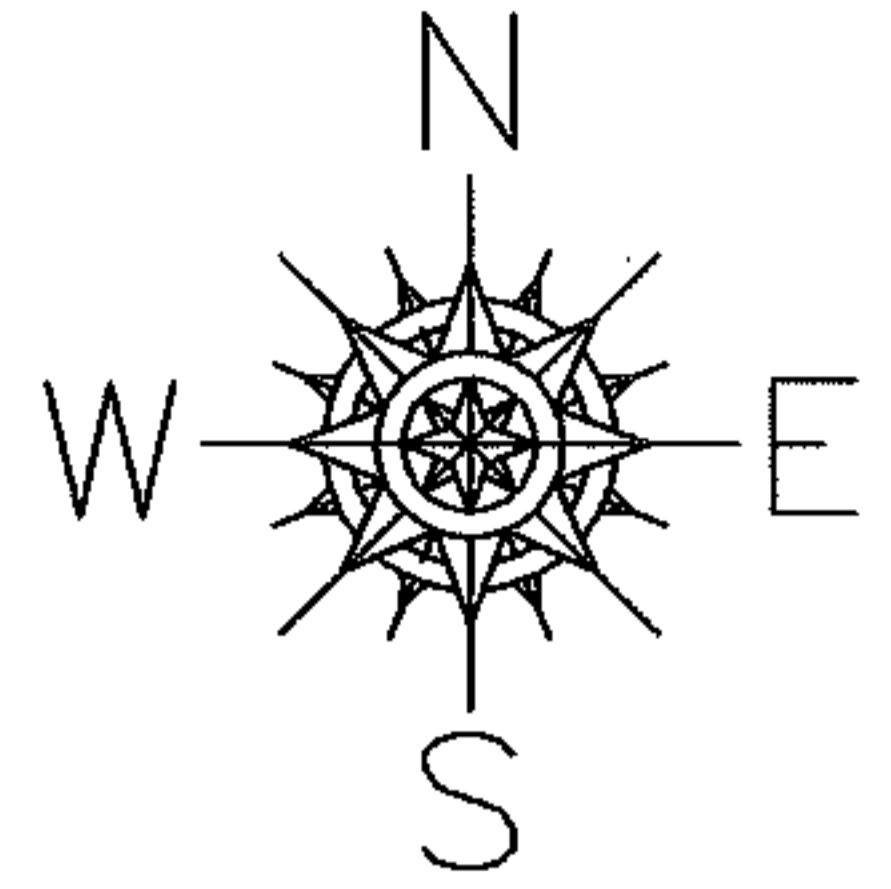

SPLITS/DEEDS PROCESSED

LORAIN COUNTY TAX MAP DEPARTMENT  
226 MIDDLE AVE. ELYRIA, OHIO

SURVEYED BY: CHRISTOPHER M. HIRZEL

CLOSURE: 0.00 : 10.000

MAP PAGE(S): 6-141

APPROVED BY: JAH DATE: 1-6-04

SCALE: 1" = 100 PRIOR INSTRUMENT: PL VL 25/84