
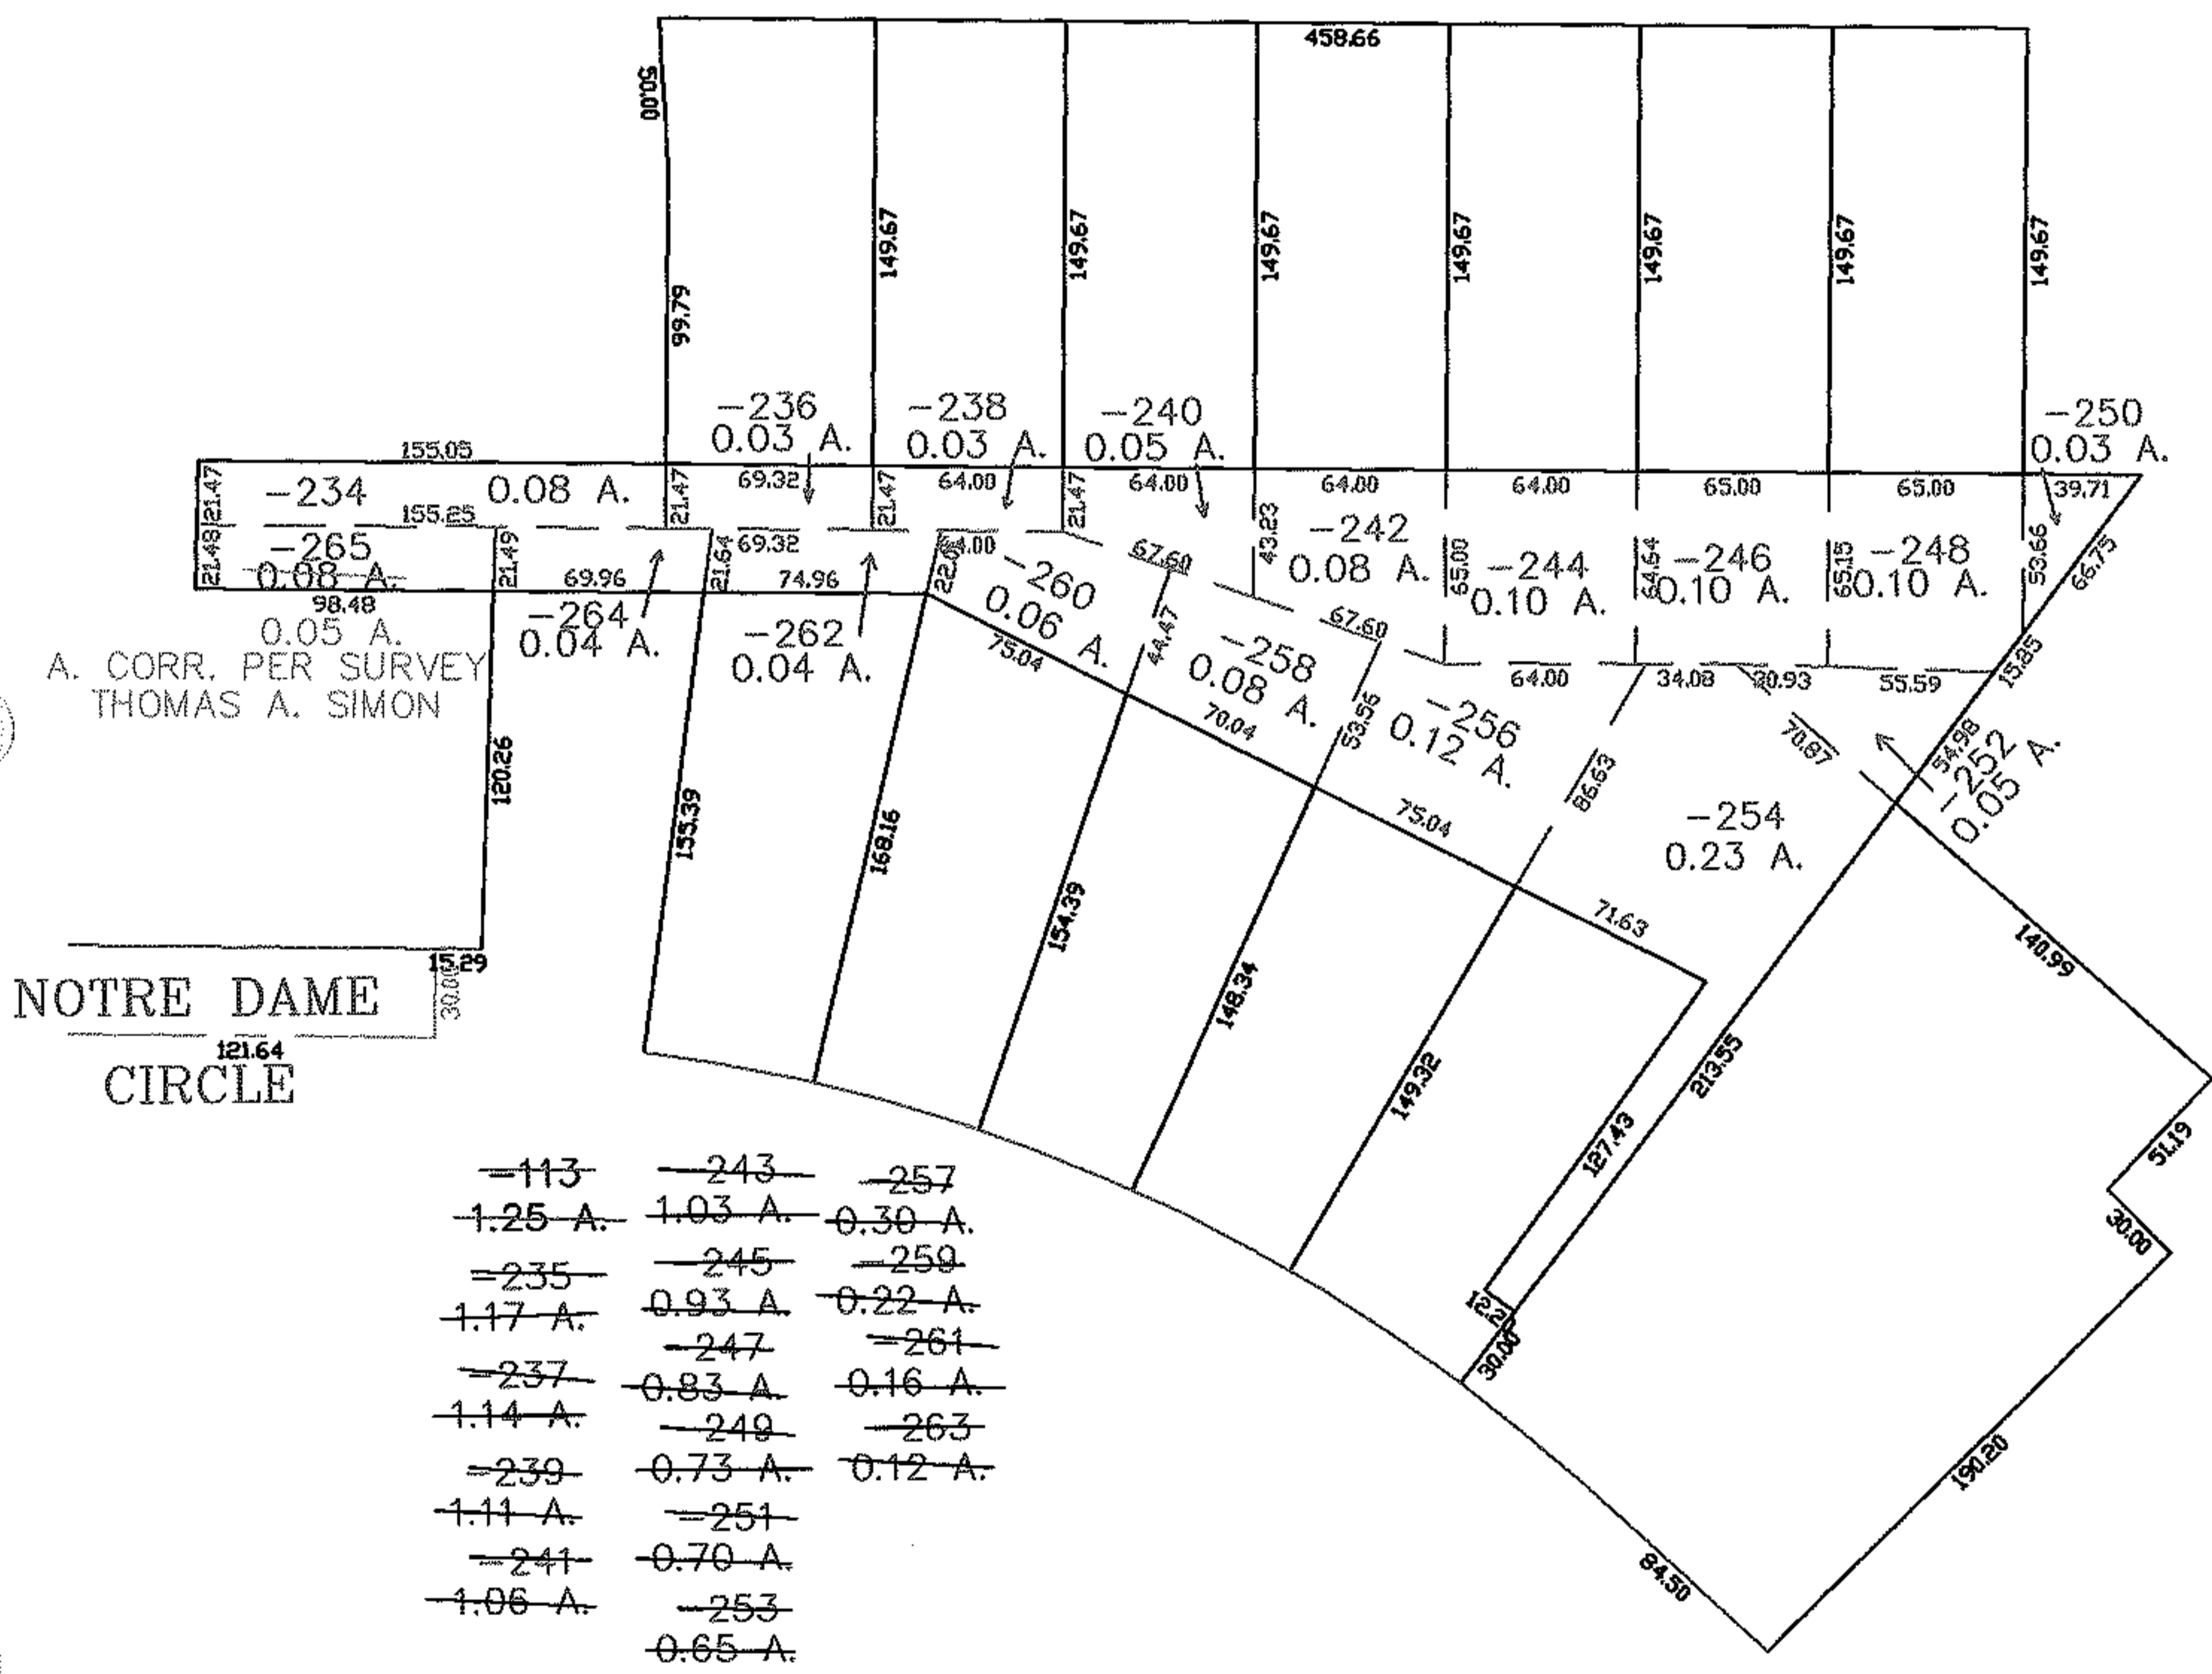


RASTER

PARENT PARCEL: 06-25-022-111-113
CHILD PARCEL: 06-25-002-111-234 THRU -265
STARTING POINT: CENTERLINE OF OF BOWLING GREEN CR. IN PARKWOOD EST. NO. 4

NO. 01561

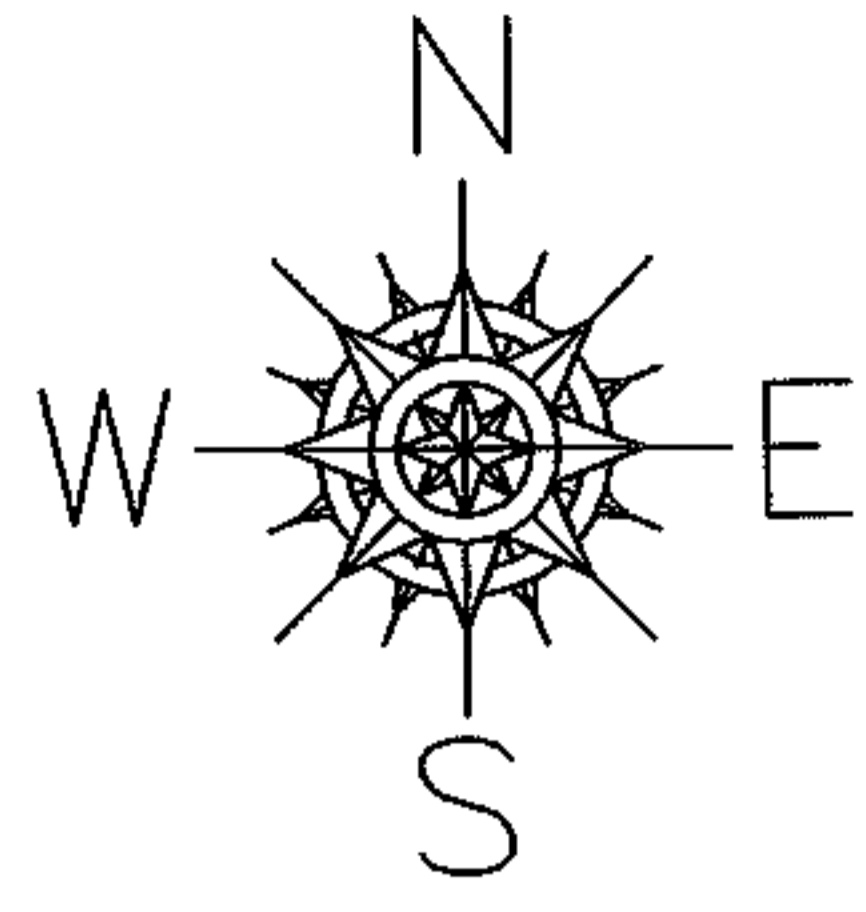

SPLITS/DEEDS PROCESSED

LORAIN COUNTY TAX MAP DEPARTMENT
226 MIDDLE AVE. ELYRIA, OHIO

SURVEYED BY: THOMAS A. SIMON
CLOSURE: 0.00 : 10.000
MAP PAGE(S): 6-142
APPROVED BY: JAH DATE: 1-8-04
SCALE: 1" = 100 PRIOR INSTRUMENT: PL VOL 26/50