
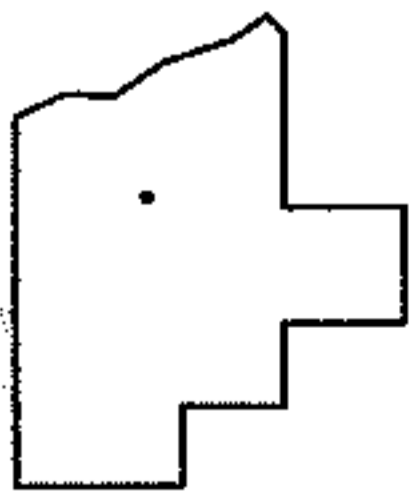


RASTER

PARENT PARCEL: 01-00-006-103-003, -009 THRU -011, -013, -014, -015, -018, -022
CHILD PARCEL: 01-00-006-103-023 THRU-027
STARTING POINT: C/L AND SOUTH LINE OF DED. PLAT OF NICHOLSON AVE. (V.43 P.7)

NO. 01563

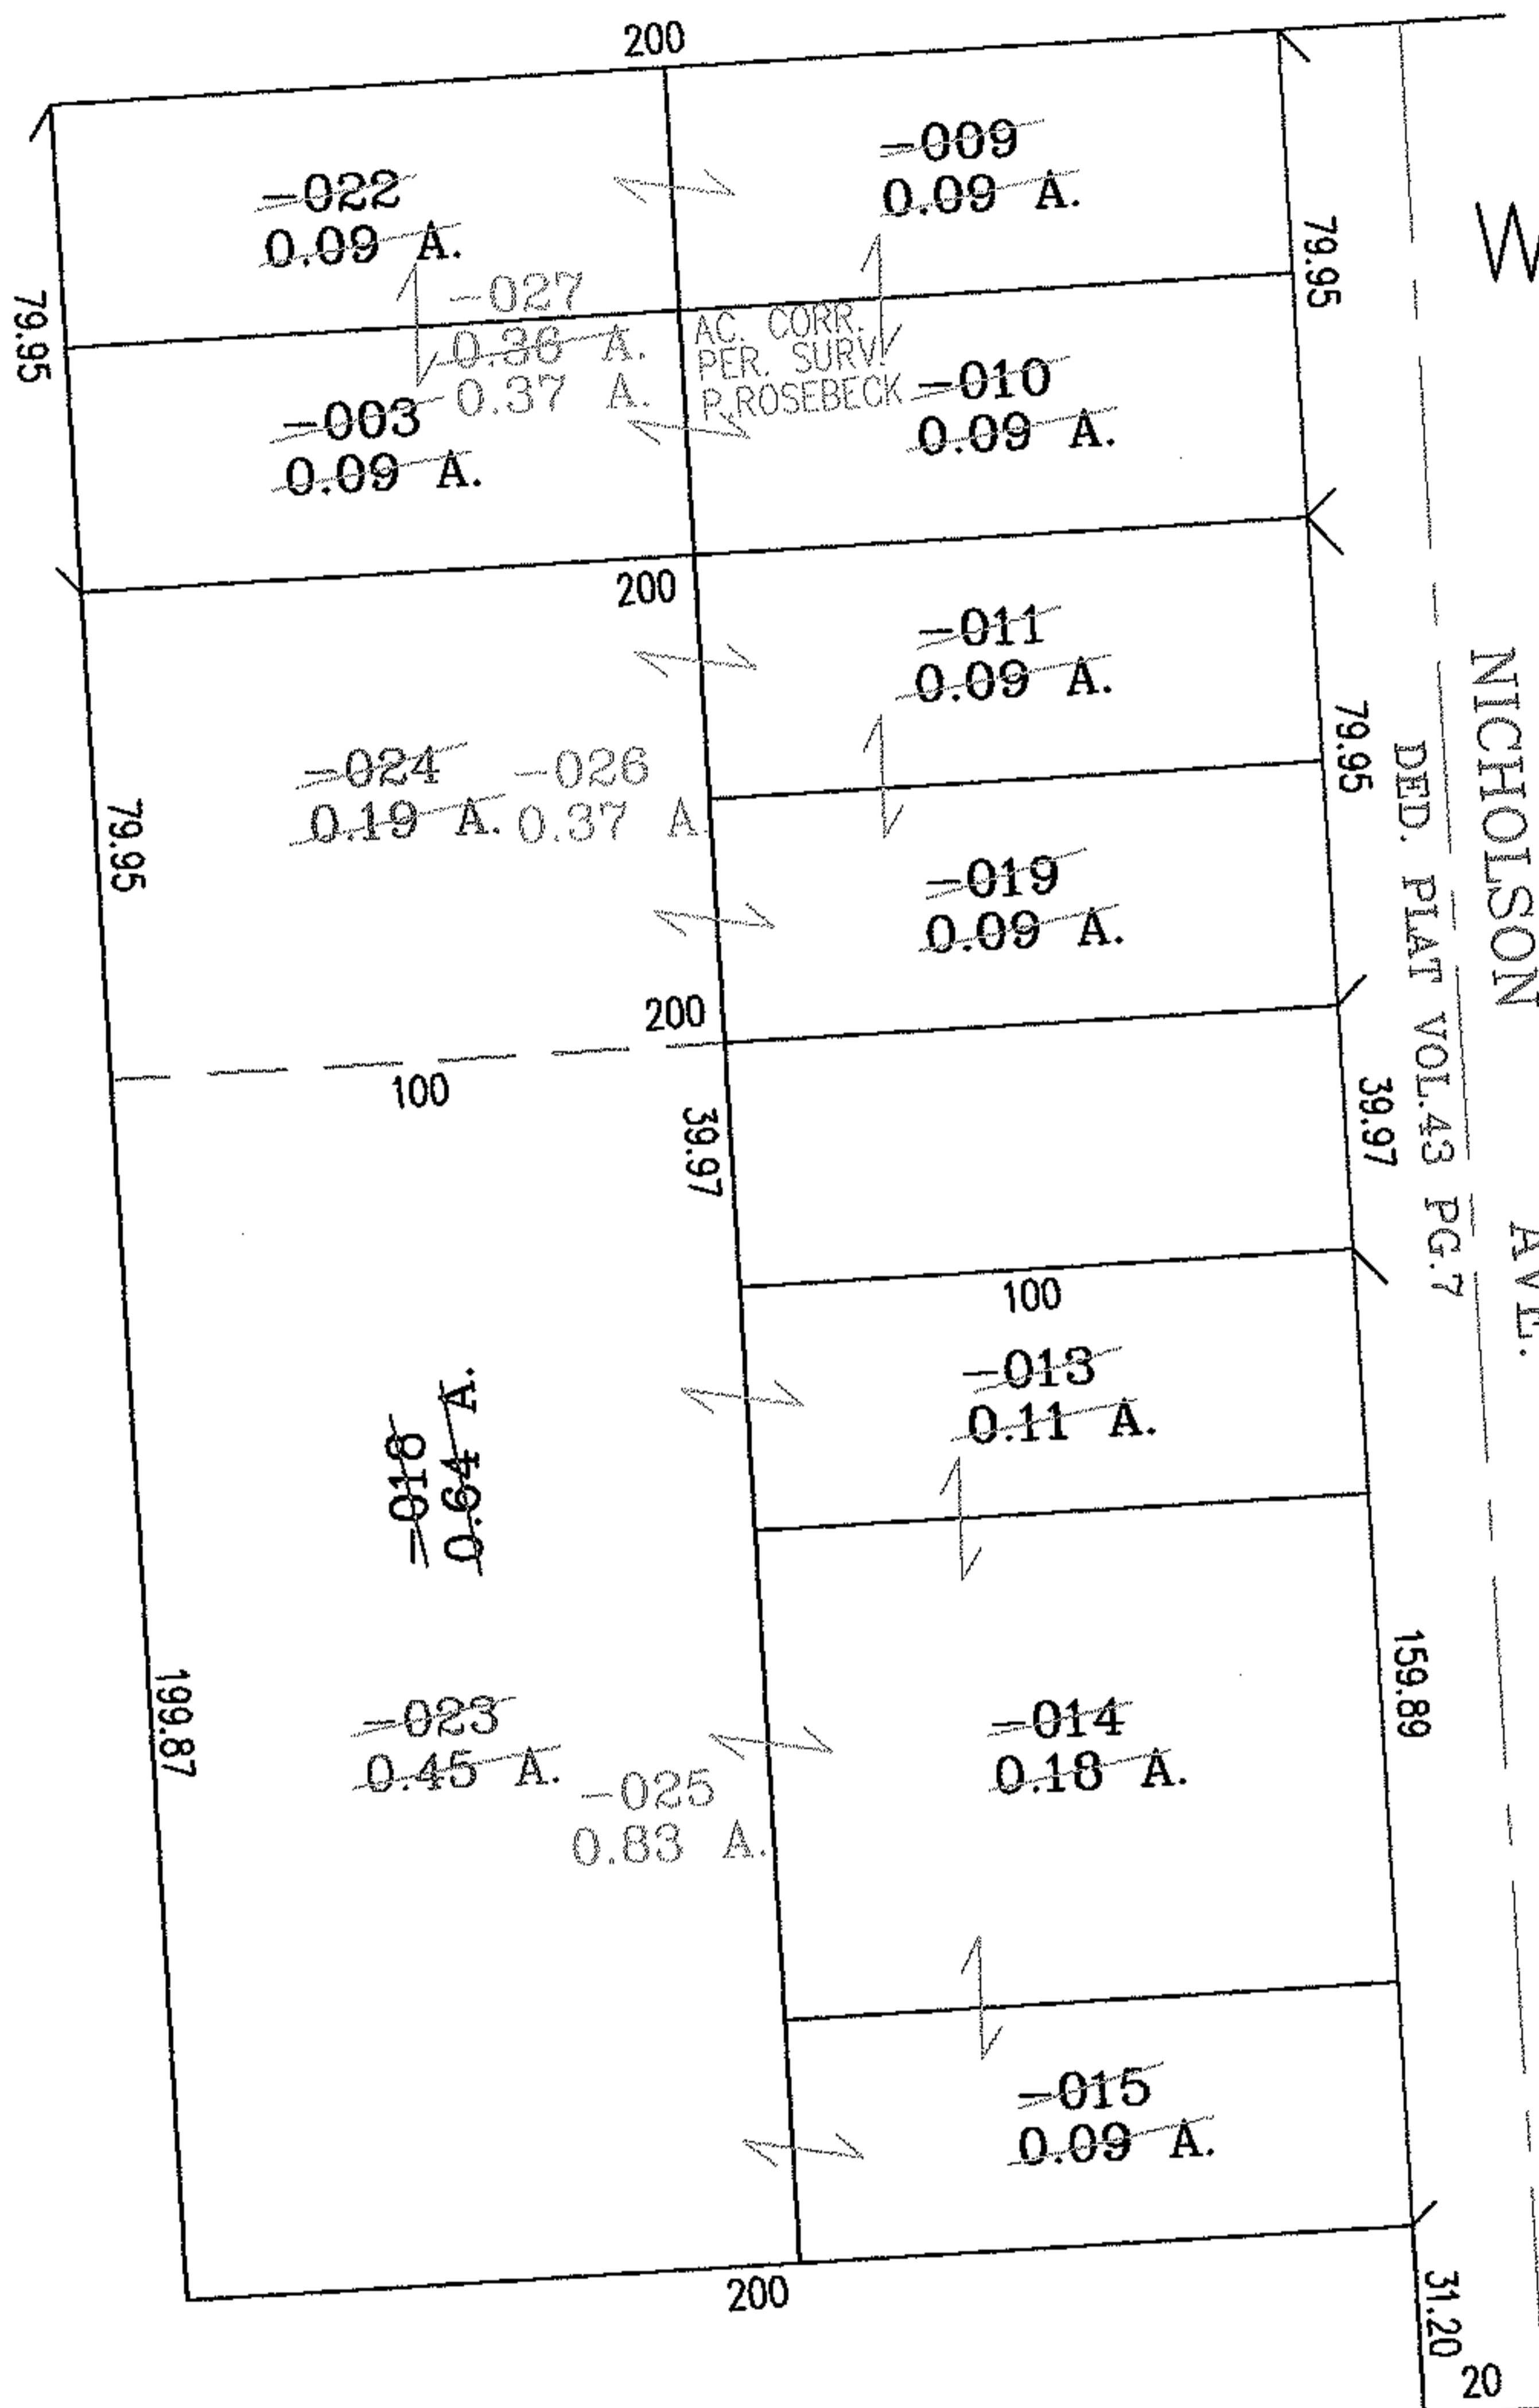

SPLITS/DEEDS PROCESSED
 LORAIN COUNTY TAX MAP DEPARTMENT
 226 MIDDLE AVE. ELYRIA, OHIO

SURVEYED BY: PHIL A. ROSEBECK
 CLOSURE: 01:10.000
 MAP PAGE(S): 1-00-006-A
 APPROVED BY: RRM DATE: 1/8/04
 SCALE: 1" = 50' PRIOR INSTRUMENT: OR 1122/434