



MASTER

PARENT PARCEL: 01-00-006-103-003,-009 THRU -011,-013,-014,-015,-018,-022

CHILD PARCEL: 01-00-006-103-023 THRU-027

STARTING POINT: C/L AND SOUTH LINE OF DED. PLAT OF NICHOLSON AVE.(V.43 P.7)

NO. 01563

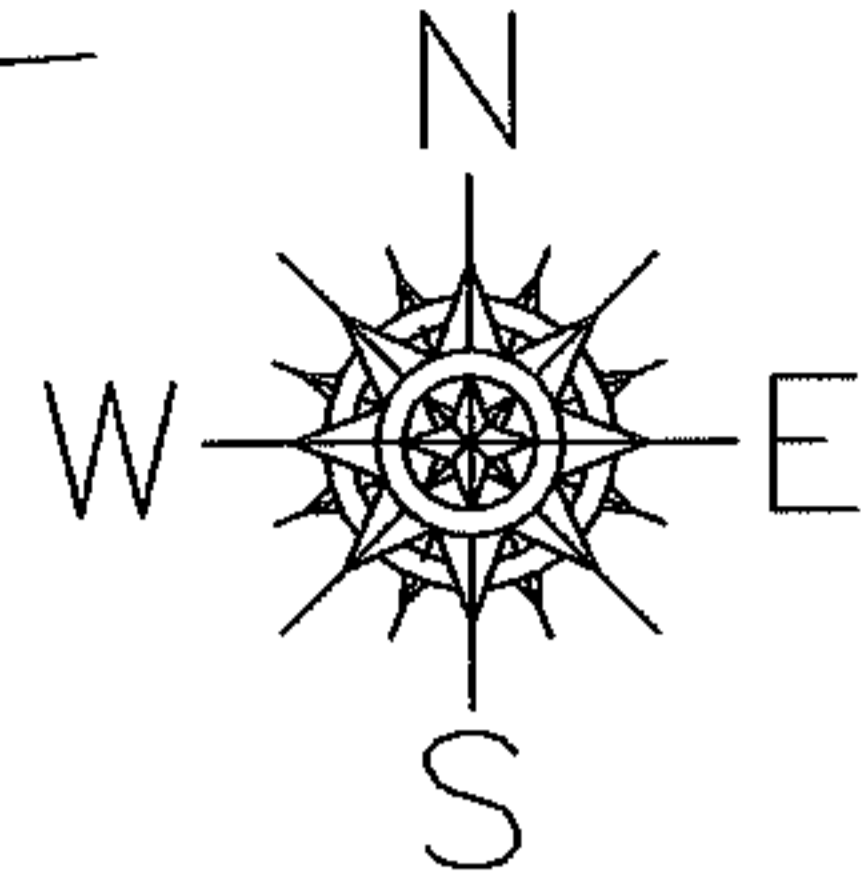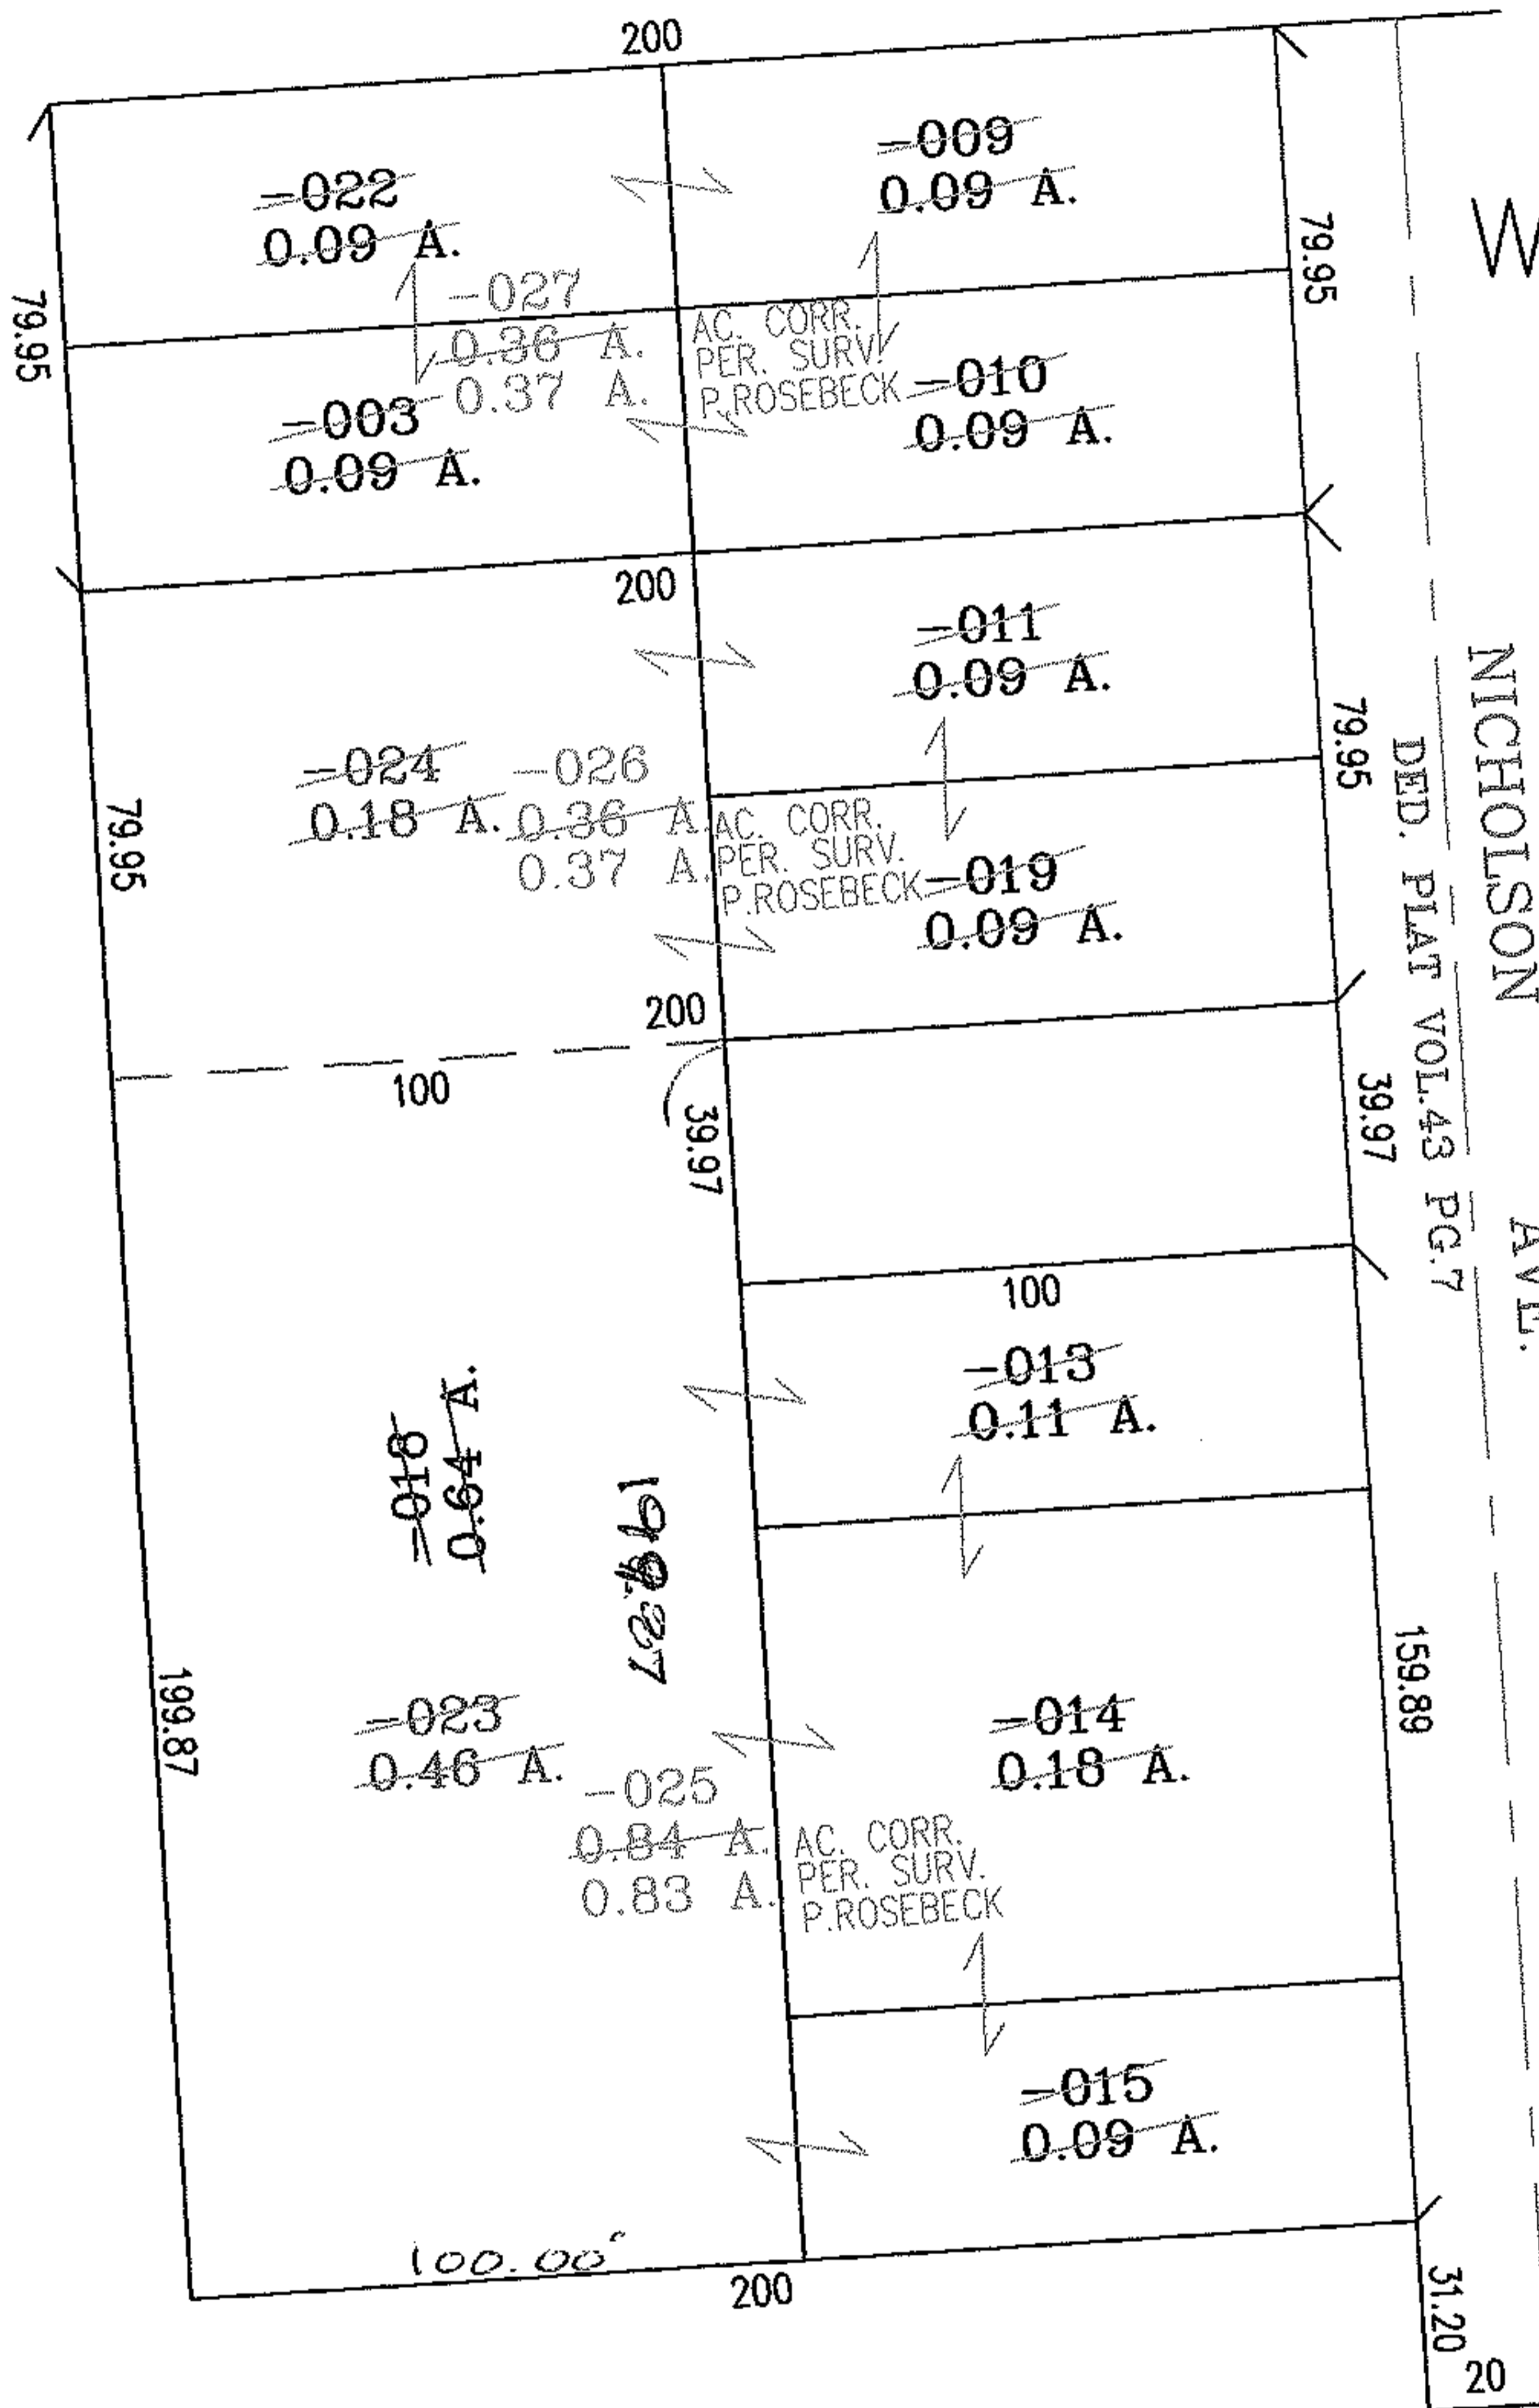

**SPLITS/DEEDS PROCESSED**

LORAIN COUNTY TAX MAP DEPARTMENT  
226 MIDDLE AVE. ELYRIA, OHIO

SURVEYED BY: PHIL A. ROSEBECK  
 CLOSURE: .01:10.000  
 MAP PAGE(S): 1-00-006-A  
 APPROVED BY: RRM DATE: 1/8/04  
 SCALE: 1"= 50 PRIOR INSTRUMENT: OR 1122/434