




RASTER

PARENT PARCEL: 05-00-090-000-004

CHILD PARCEL: 05-00-090-000-010 THRU -012

STARTING POINT: CENTERLINE OF ALBRECHT RD. & BECHTEL RD.

NO. 01567

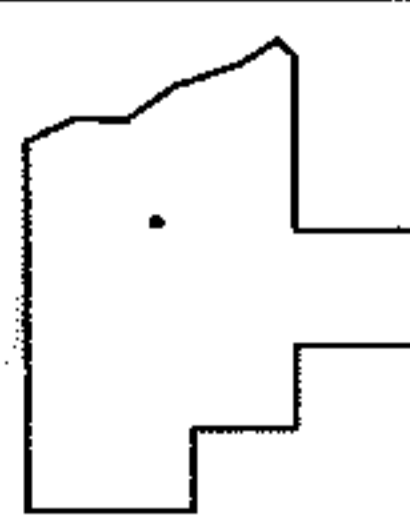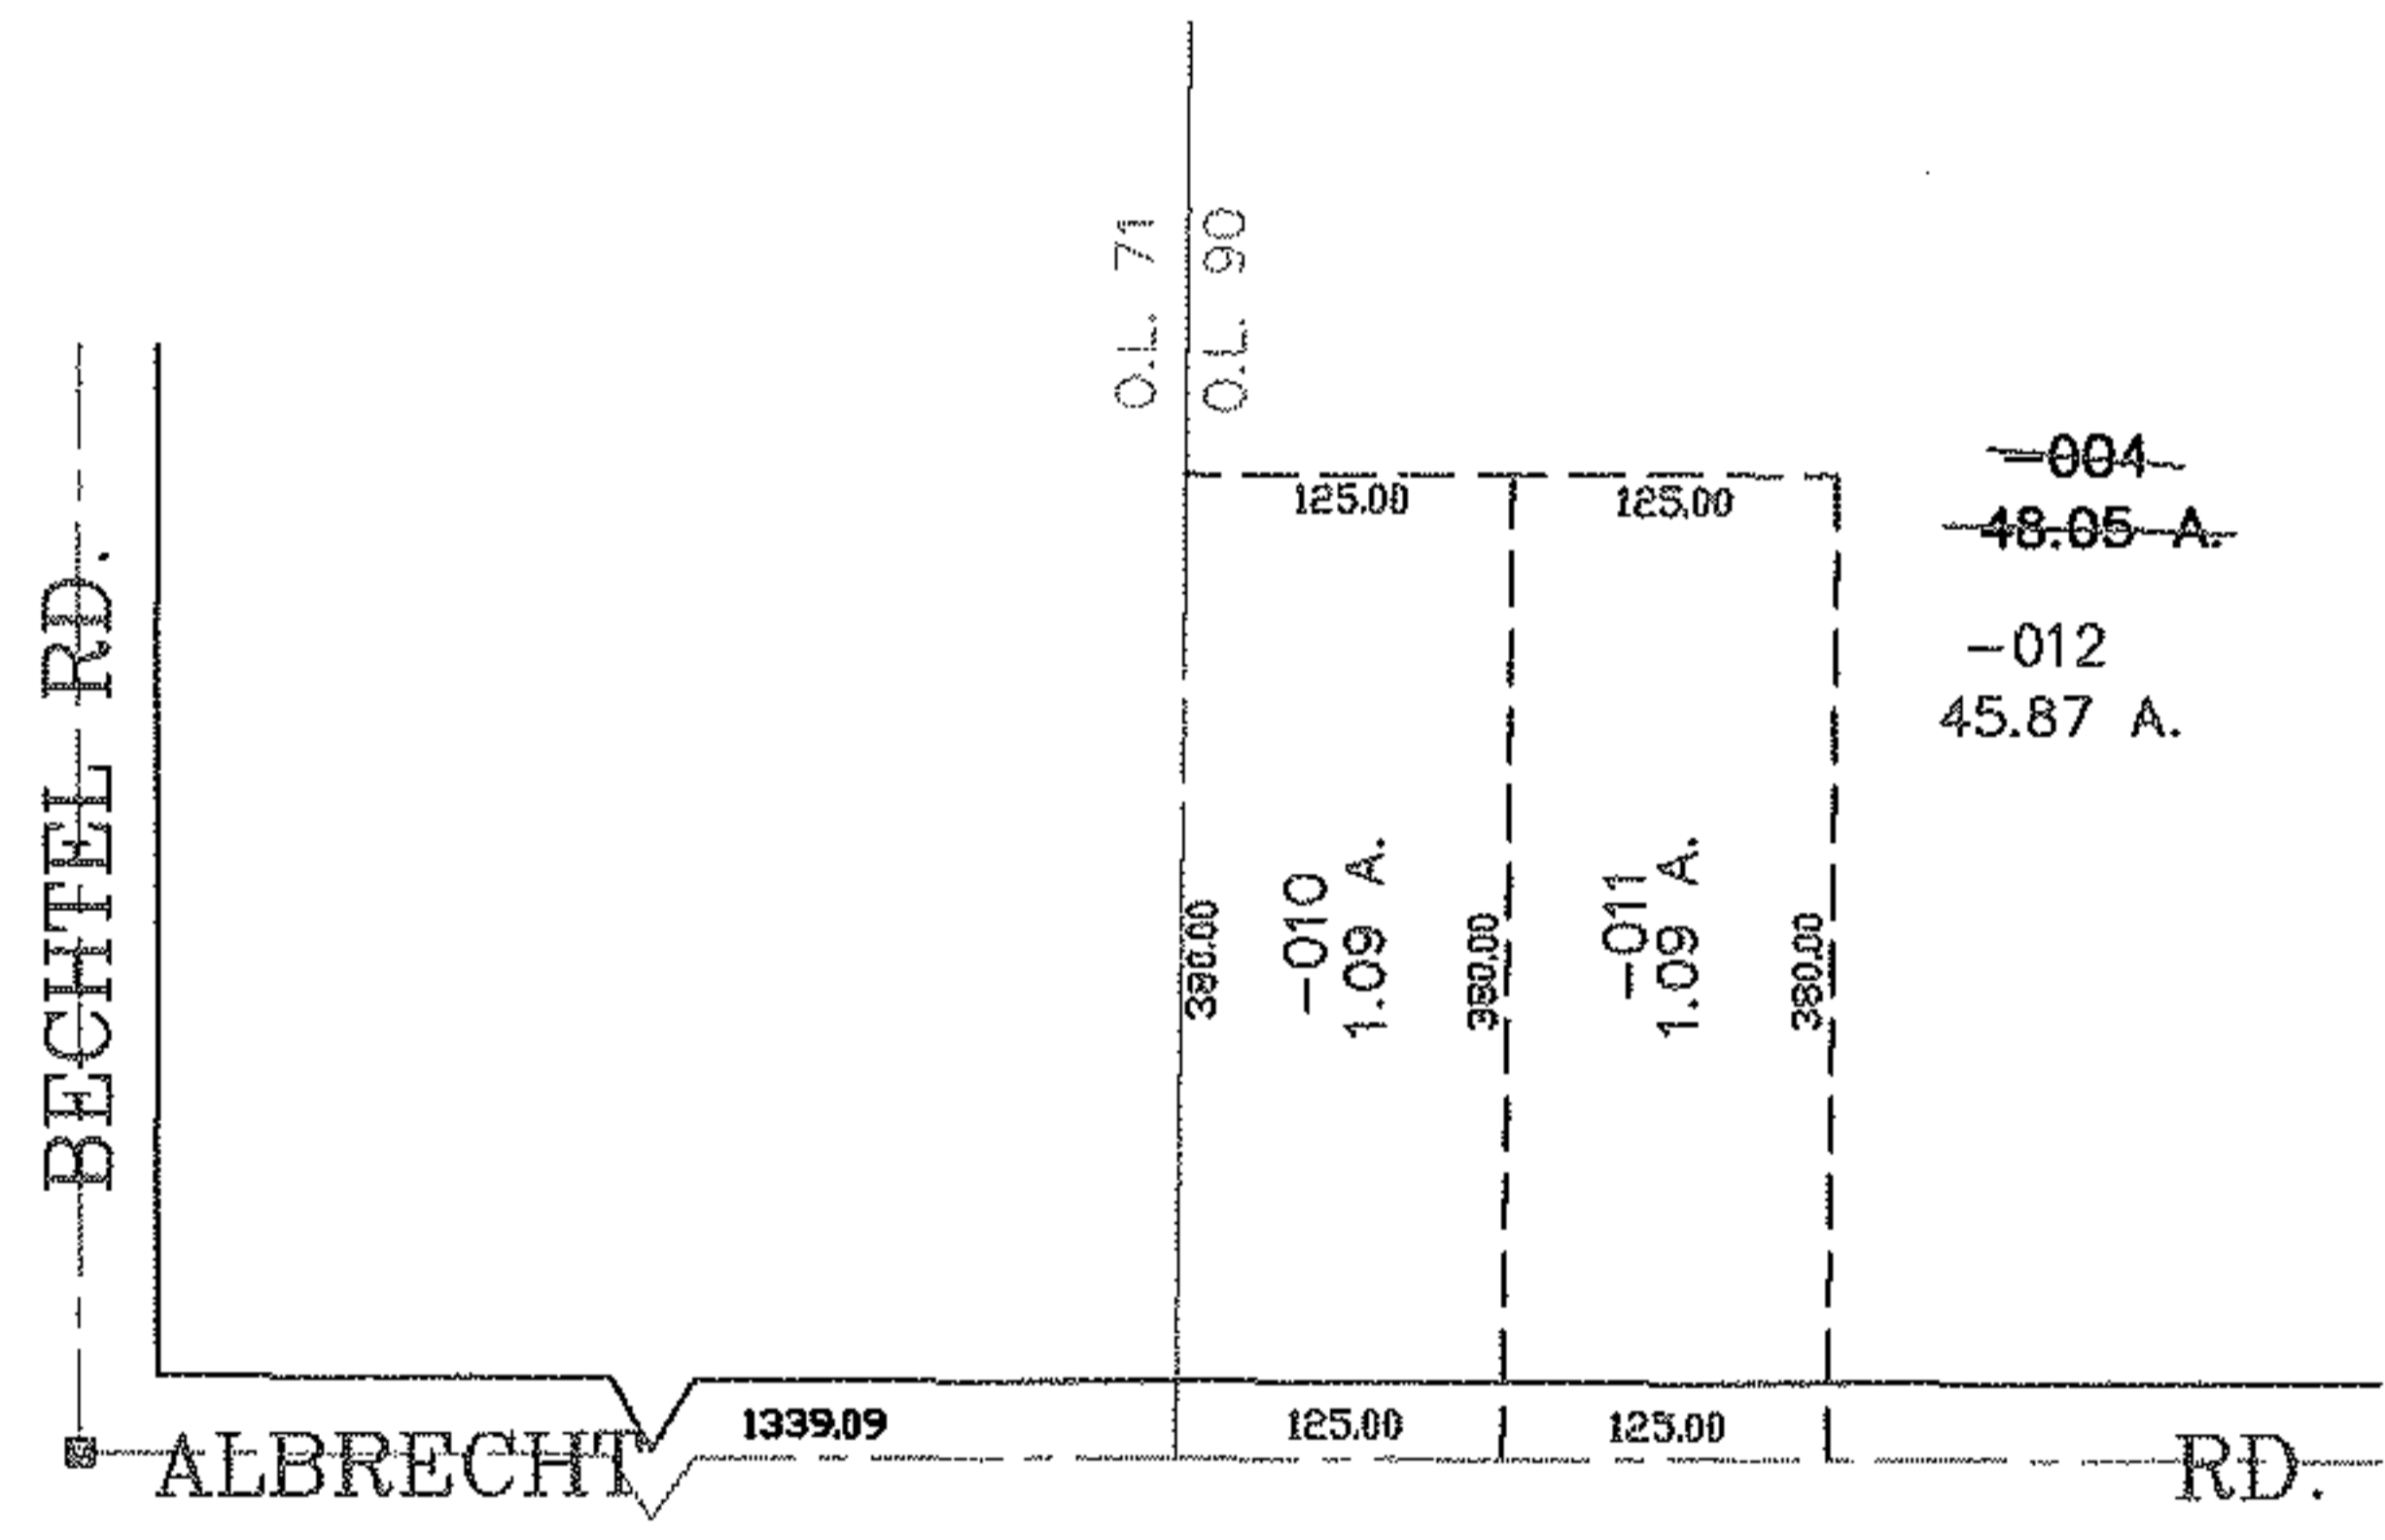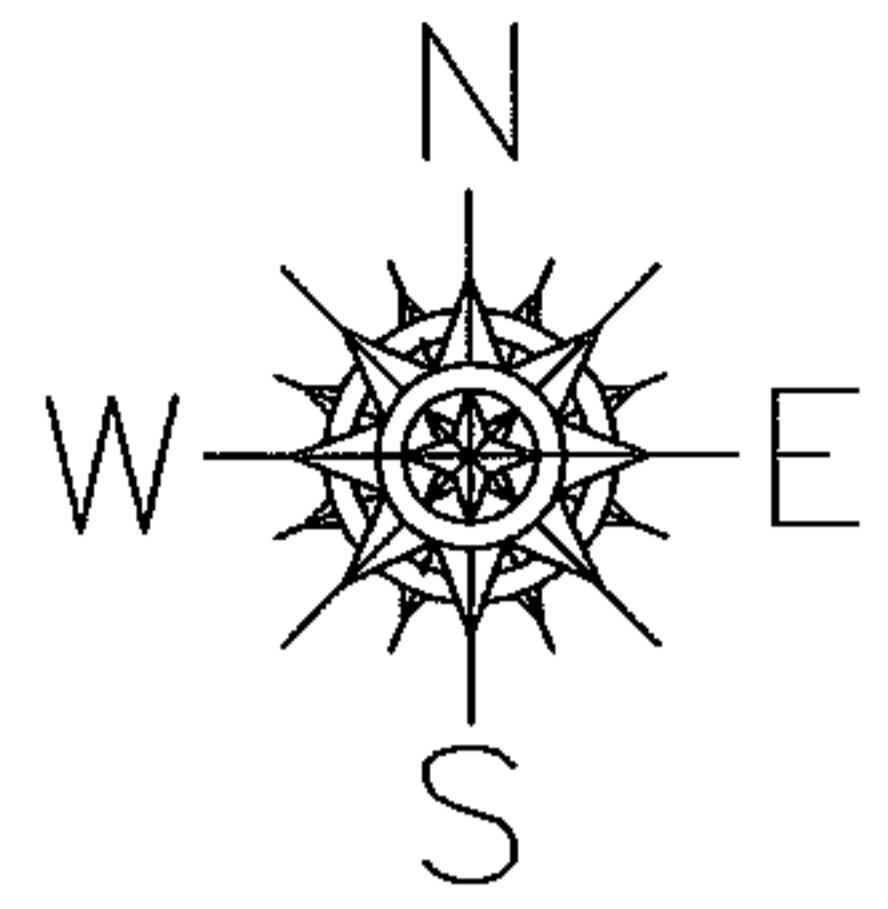

SPLITS/DEEDS PROCESSED

LORAIN COUNTY TAX MAP DEPARTMENT
226 MIDDLE AVE. ELYRIA, OHIO

SURVEYED BY: CHRISTOPHER HIRZEL

CLOSURE: 0.00 : 10.000

MAP PAGE(S): 5-H

APPROVED BY: JAH DATE: 1-15-04

SCALE: 1" = 200 PRIOR INSTRUMENT: 20030963983