
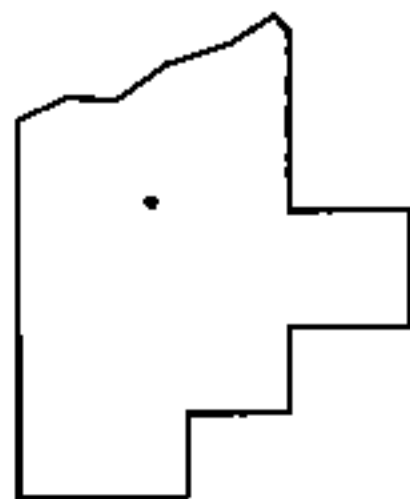
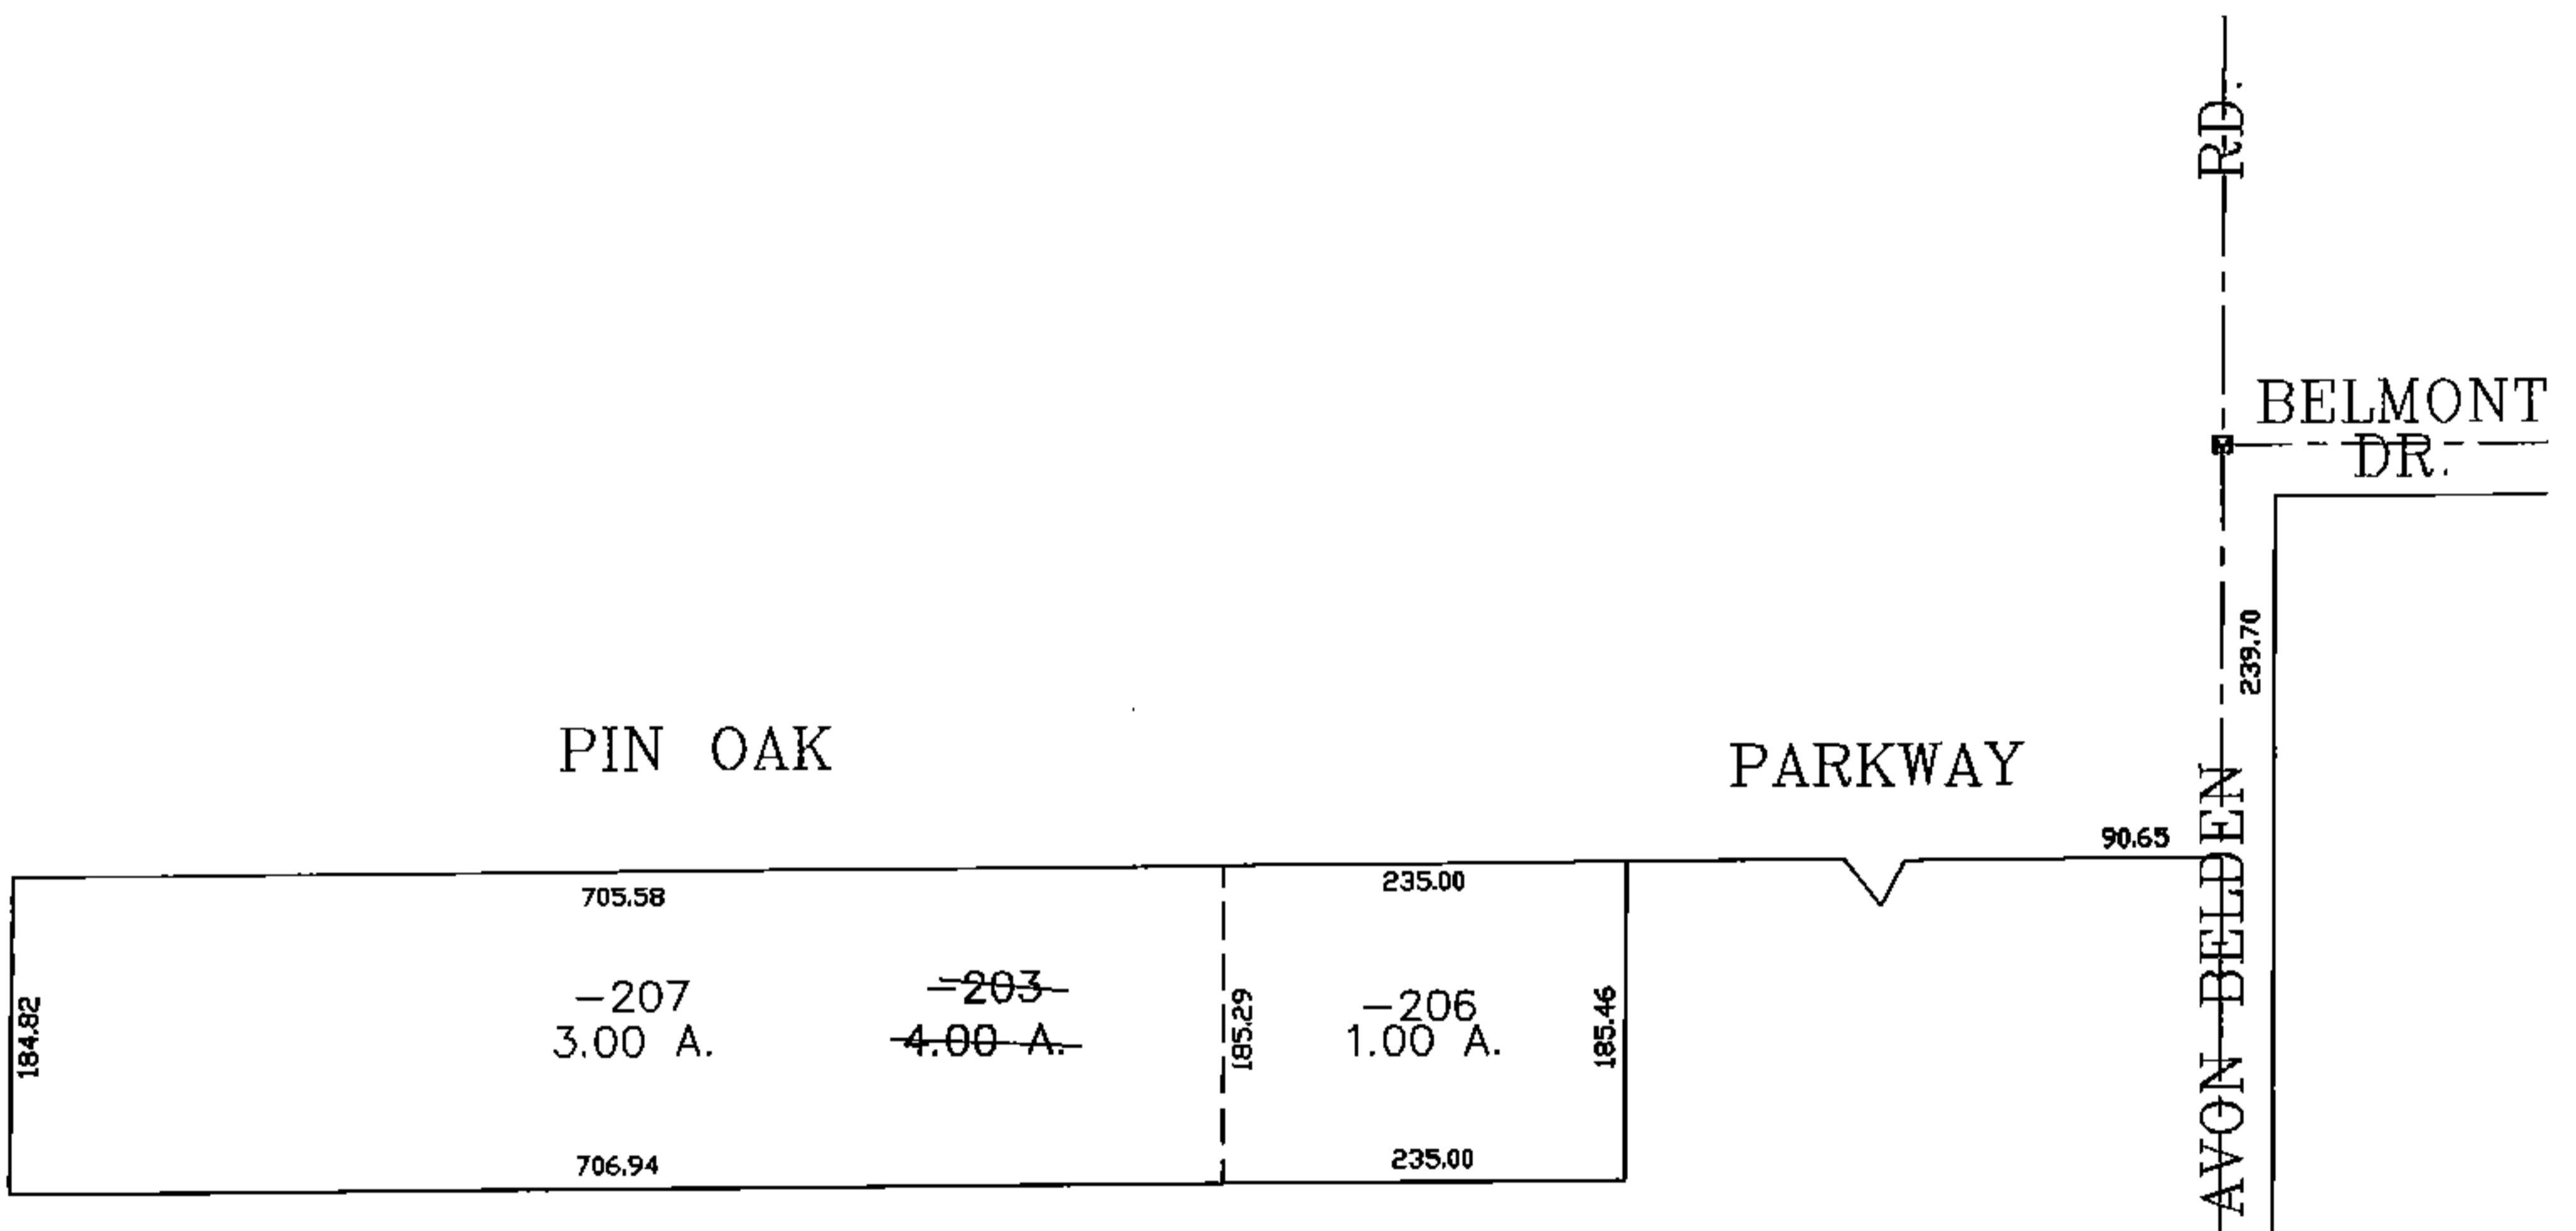


PARENT PARCEL: 04-00-017-102-203

CHILD PARCEL: 04-00-017-102-206, -207

STARTING POINT: CENTERLINE OF AVON BELDEN RD. & BELMONT DR.

NO. 01572

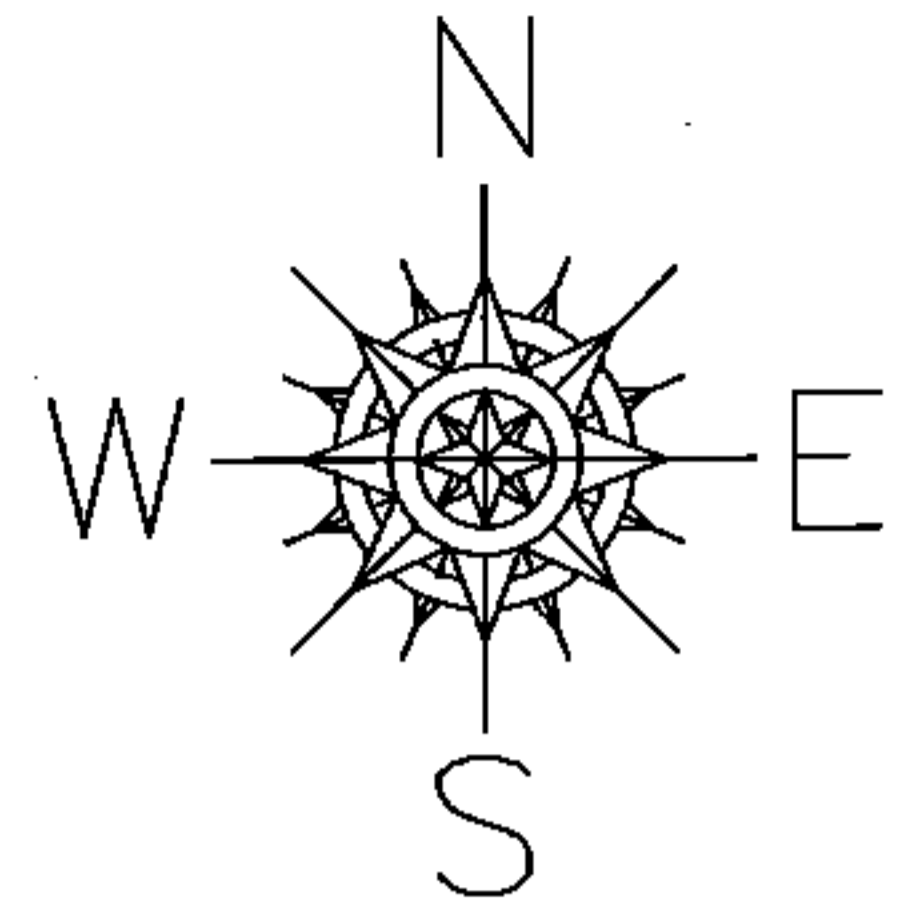

**SPLITS/DEEDS PROCESSED**  
 LORAIN COUNTY TAX MAP DEPARTMENT  
 226 MIDDLE AVE. ELYRIA, OHIO

SURVEYED BY: DAVID L. ELWELL  
 CLOSURE: 0.00 : 10.000  
 MAP PAGE(S): 04-00-017-E, F  
 APPROVED BY: JAH DATE: 1-16-04  
 SCALE: 1" = 200 PRIOR INSTRUMENT: 20010734167